
CA-2
Please split Parcel

FARRIS, HANSEN & COOPER, INC.

ENGINEERING, SURVEYING AND LAND PLANNING
715 W. WALWORTH ST. P.O. Box 467 - ELKHORN, WI 53121
OFFICE: 414/723-2000

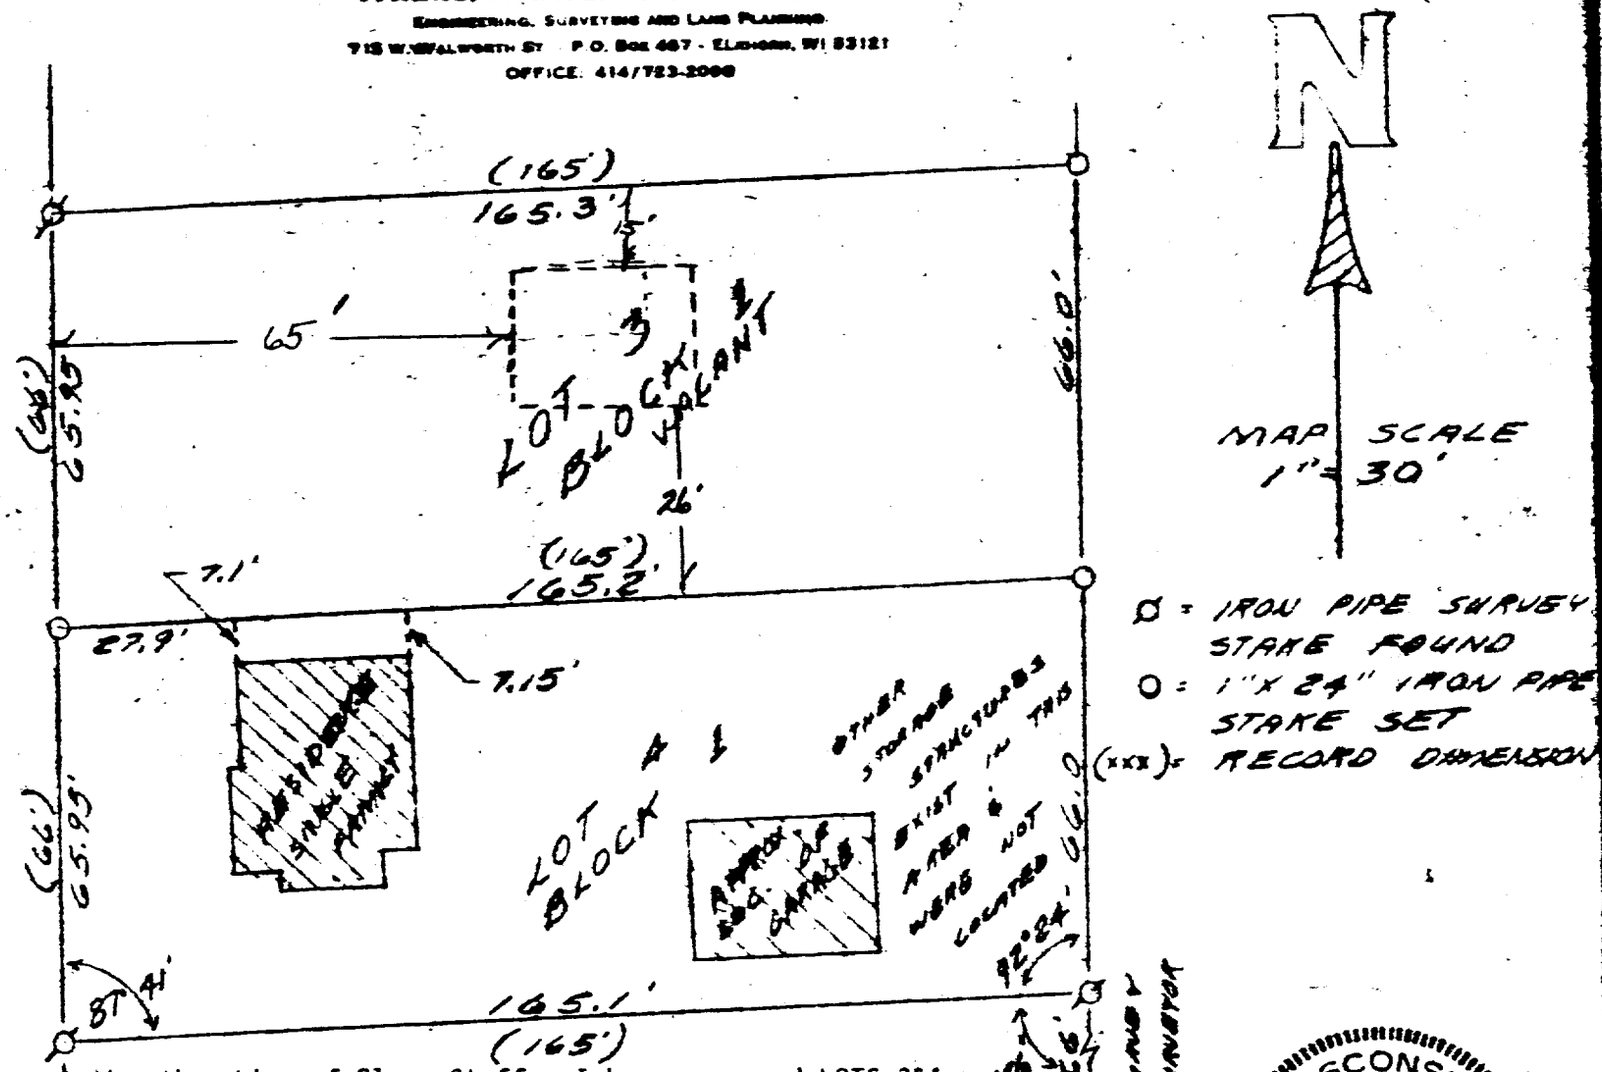

N

MAP SCALE
1" = 30'

Ø = IRON PIPE SURVEY STAKE FOUND
O = 1" X 24" IRON PIPE STAKE SET
(XXX) = RECORD DIMENSION

I HEREBY CERTIFY that at the direction of Glenn Steffen I have surveyed LOTS 3&4 of BLOCK 1 of CAINES ADDITION, CITY OF WHITEWATER, Walworth County, Wisconsin and located a residence on said Lot 4 and that this PLAT OF SURVEY is a true and accurate representation of the lot lines and residence location to the best of my professional knowledge and belief.

DATED THIS 7th DAY OF OCTOBER 1982

Robert A. Farris

Robert A. Farris, RLS

WISCONSIN
ROBERT A. FARRIS
S-1293
ELKHORN, WIS.
LAND SURVEYOR

DRAWING NUMBER 2018

CA-2+2A

10-315-F