
PLAT OF SURVEY

extra copy

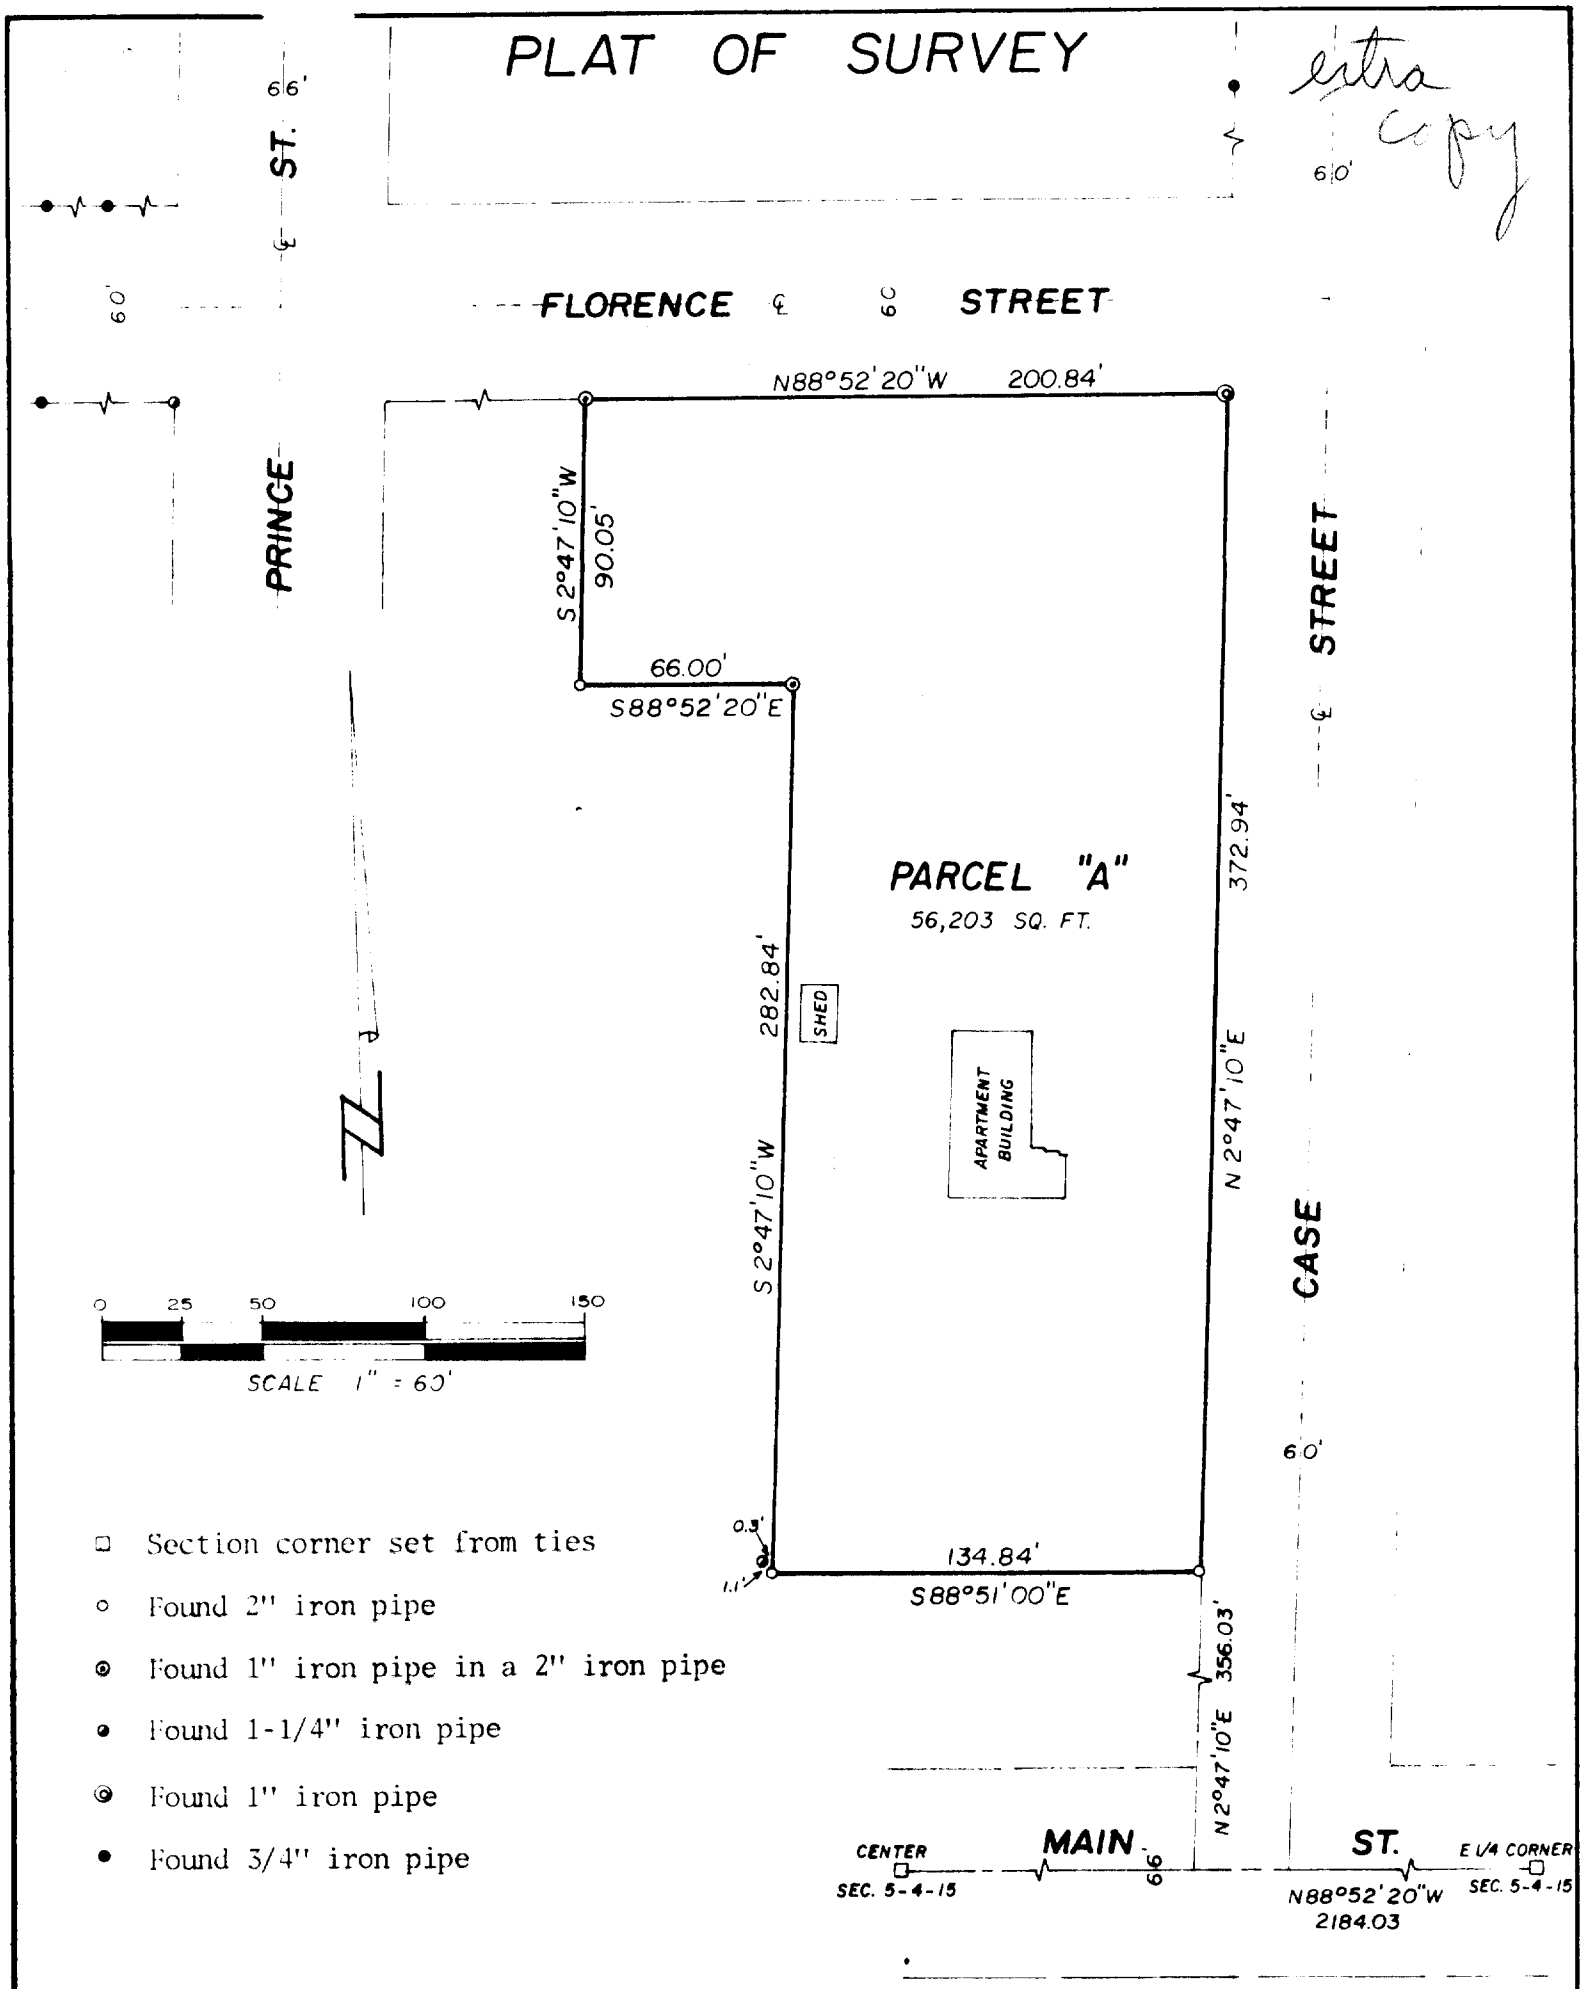

- □ Section corner set from ties
- ○ Found 2" iron pipe
- ◎ Found 1" iron pipe in a 2" iron pipe
- ● Found 1-1/4" iron pipe
- ◎ Found 1" iron pipe
- • Found 3/4" iron pipe

University of Wisconsin-Whitewater
Attn: Dr. Dale Brock
Whitewater
Wisconsin 53190

WISCONSIN
JAMES B. WOODMAN
S-1306
FORT ATKINSON, WIS
LAND SURVEYOR

2-28-83

Sheet 1 of 2

JN 83S-10

STRAND & WOODMAN ASSOCIATES
210 Madison Ave., Fort Atkinson, WI 53538

Land Surveyors & Engineers
Phone (414) 563 - 8162

WUP-144

10-3248

PLAT OF SURVEY

DESCRIPTION

Parcel "A"

A part of the SW¼ of the NE¼ of Section 5, T4N, R15E, City of Whitewater, Walworth County, Wisconsin, to-wit:

Commencing at the E ¼ corner of said Section 5; thence N88°52'20"W, along the south line of said NE¼, 2184.03 feet; thence N02°47'10"E, along the west line of Case Street and its extension, 356.03 feet to a 2" iron pipe and the point of beginning; thence continue N02°47'10"E, along said west line, 372.94 feet to a 1" iron pipe; thence N88°52'20"W, along the south line of Florence Street, 200.84 feet to a 2" iron pipe; thence S02°47'10"W, 90.05 feet to a 2" iron pipe; thence S88°52'20"E, 66.00 feet to a 2" iron pipe; thence S02°47'10"W, 282.84 feet to a 2" iron pipe; thence S88°51'00"E, 134.84 feet to the point of beginning, containing 56,203 square feet.

CERTIFICATION

I hereby certify that the property described above has been surveyed under my responsible direction and supervision and that this map is a correct representation of the lot lines and dimensions and the principle lines of the permanent structures thereon.

Date 2-28-83

James B. Woodman
Registered Land Surveyor S-1239

WISCONSIN
JAMES B.
WOODMAN
S-1239
FORT ATKINSON
WIS.
LAND SURVEYOR

Sheet 2 of 2 JN 83S-10

STRAND & WOODMAN ASSOCIATES
210 Madison Ave., Fort Atkinson, WI 53538

Land Surveyors & Engineers
Phone (414) 563 - 8168