
#121-67

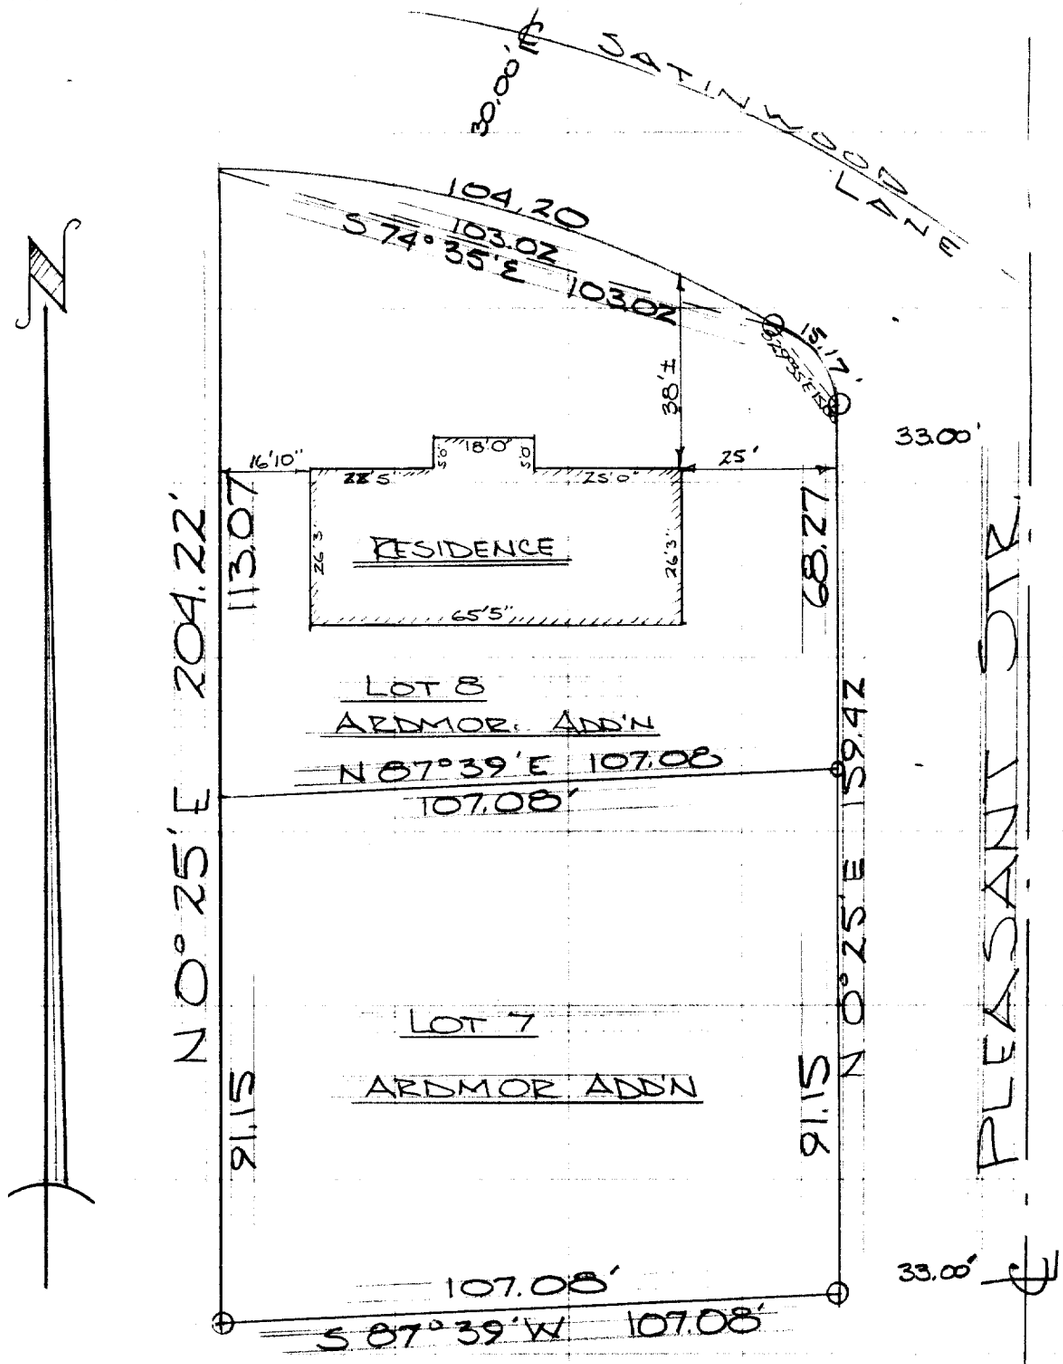

DESCRIPTION: Lot 8 of Ardmor Addition to the City of Whitewater, Walworth County, Wisconsin.

CERTIFICATE: I, James F. Biagi, surveyor do hereby certify that I have surveyed the property hereon described and that the location of the improvements are as shown.

Aug. 11, 1967.

James F. Biagi

James F. Biagi, RLS 272

WISCONSIN
JAMES F. BIAGI
MILWAUKEE, WIS.
LAND SURVEYOR

AA-8

10-32B