
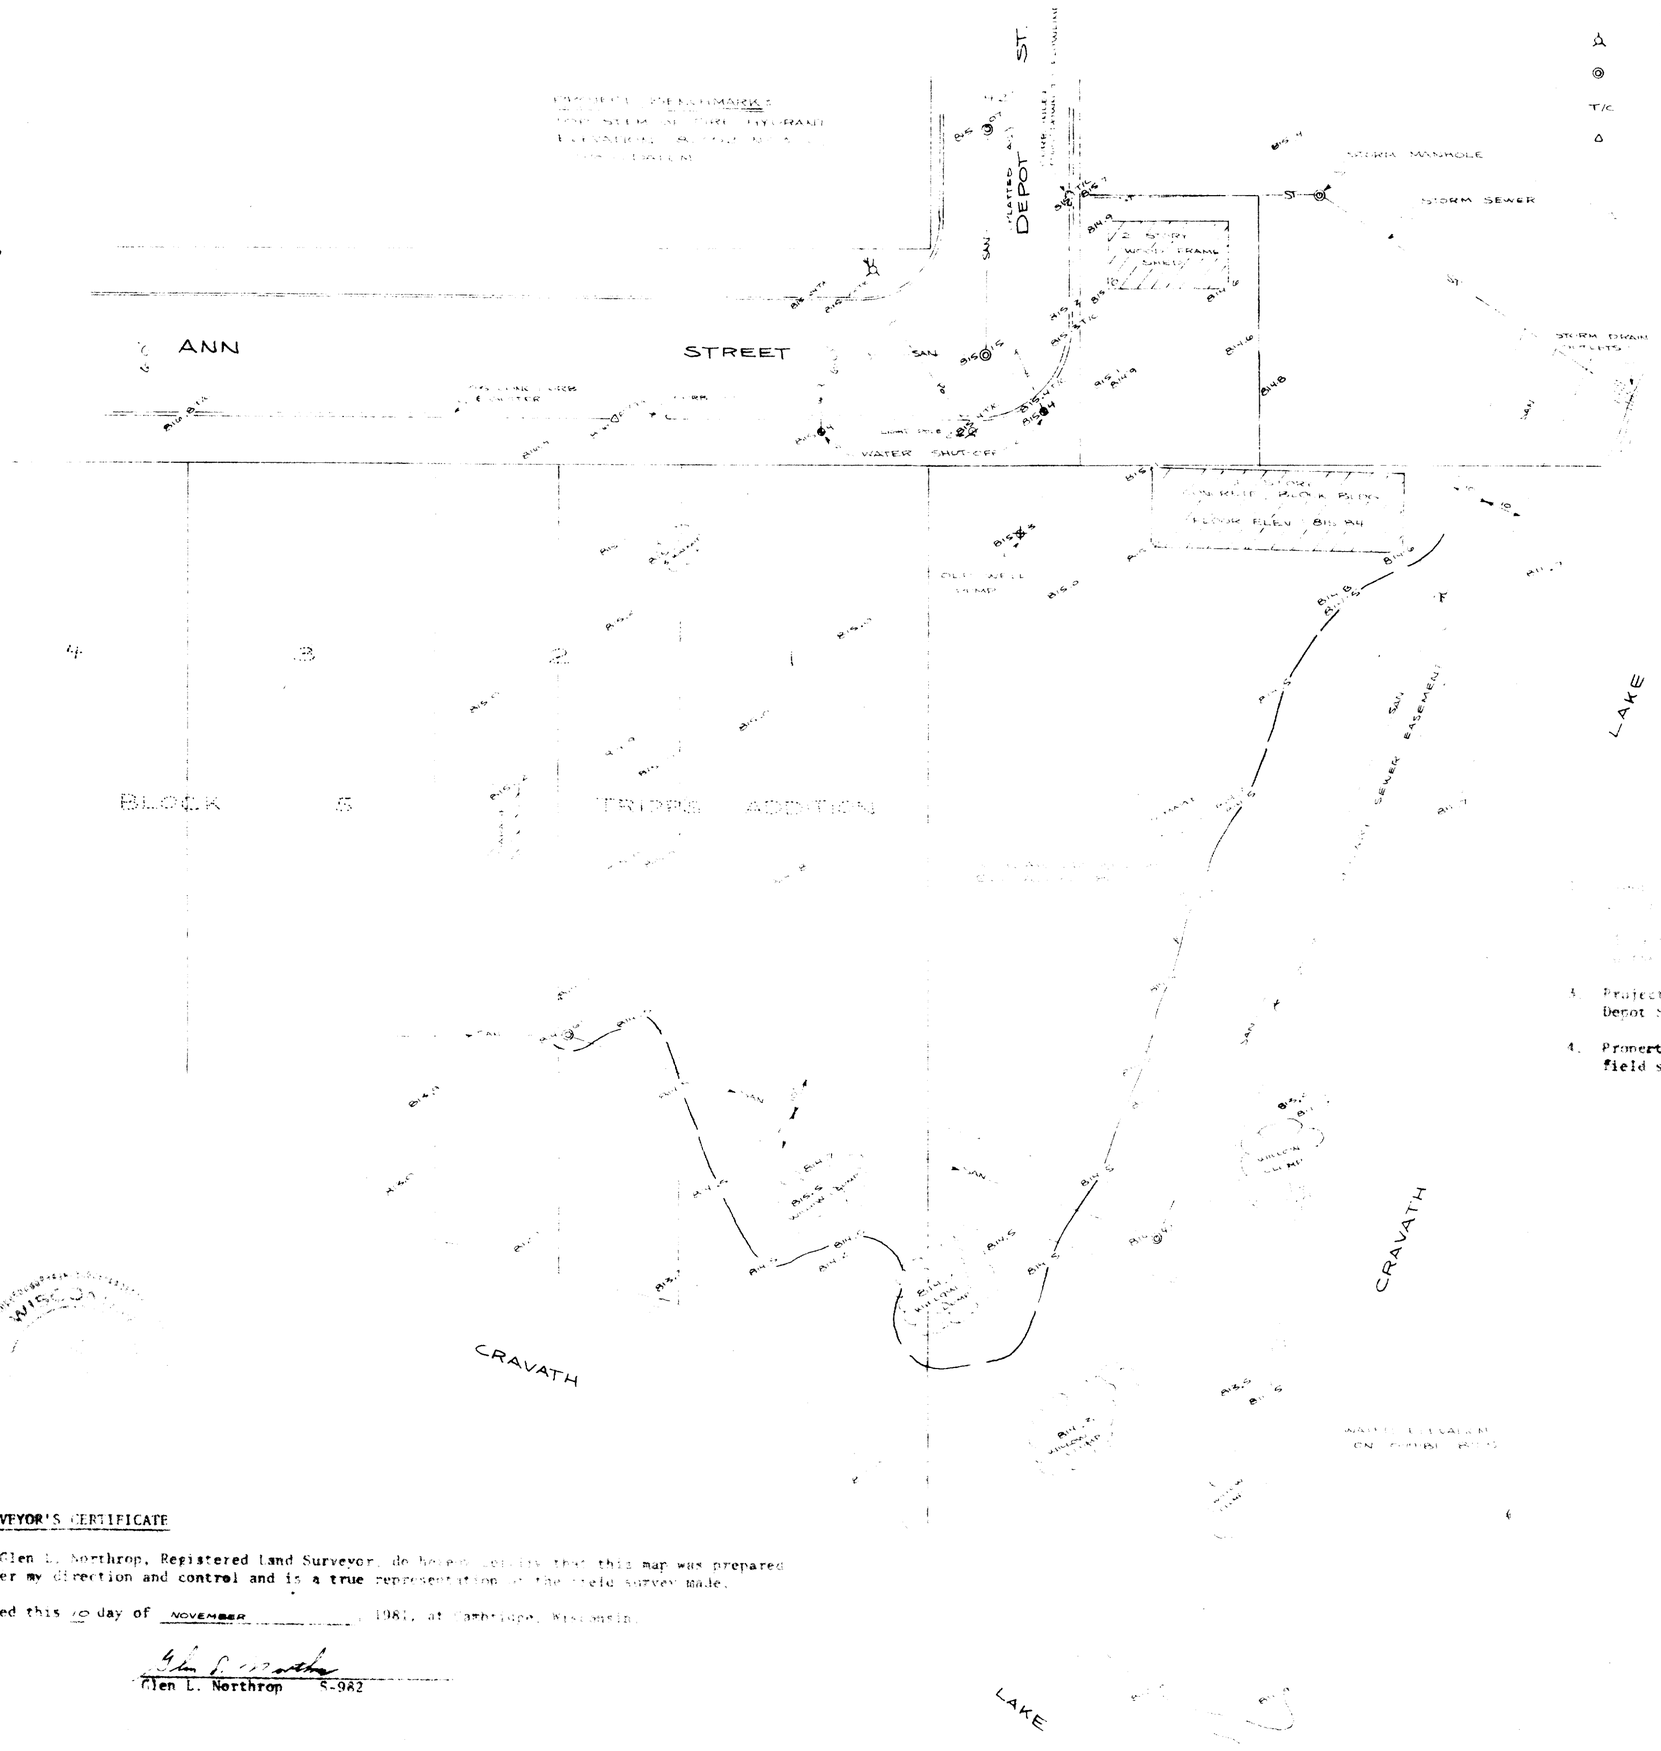


LEGEND

- FIRE HYDRANT
- SANITARY MANHOLE
- T/C TOP OF CURB
- SURVEY CONTROL POINT

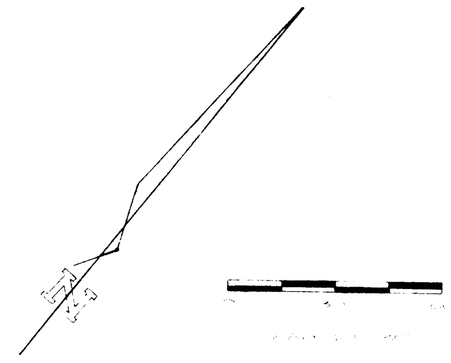

3. Project benchmark is top stem of hydrant located at the intersection of Ann and Depot Streets as shown, elevation 817.52 feet U.S.L.S. (N.O.A.A.) Datum.

4. Property lines shown are approximate only, and do not originate from an accurate field survey.

SURVEYOR'S CERTIFICATE

I, Glen L. Northrop, Registered Land Surveyor, do hereby certify that this map was prepared under my direction and control and is a true representation of the field survey made.

Dated this 10 day of NOVEMBER, 1981, at Cambridge, Wisconsin.

Glen L. Northrop S-982

FLOOD PLAIN MAP

PART OF THE SE¼ OF THE SW¼ OF SECTION 4, T 4 N, R 15 E, ALSO LOT 1 AND THE E½ OF LOT 2, BLOCK 5, TRIPPS ADDITION TO THE CITY OF WHITEWATER, WALWORTH COUNTY, WISCONSIN

Surveyed by: ABEX Survey Ltd.
Box 369, Cambridge, WI

Surveyed for: Mr. Neil Stone
147 Newcomb Street, Whitewater, WI

Surveyed: Oct 19, Nov 9, 1981; D. Riesop, G. Northrop

Drawn: Nov 10, 1981; D. Riesop

Printed:

Order No. AB 828-81

Dwg. No. 828

Sheet 1 of 1

Blk 5, TRIPPS Add. + UP-262

10-331