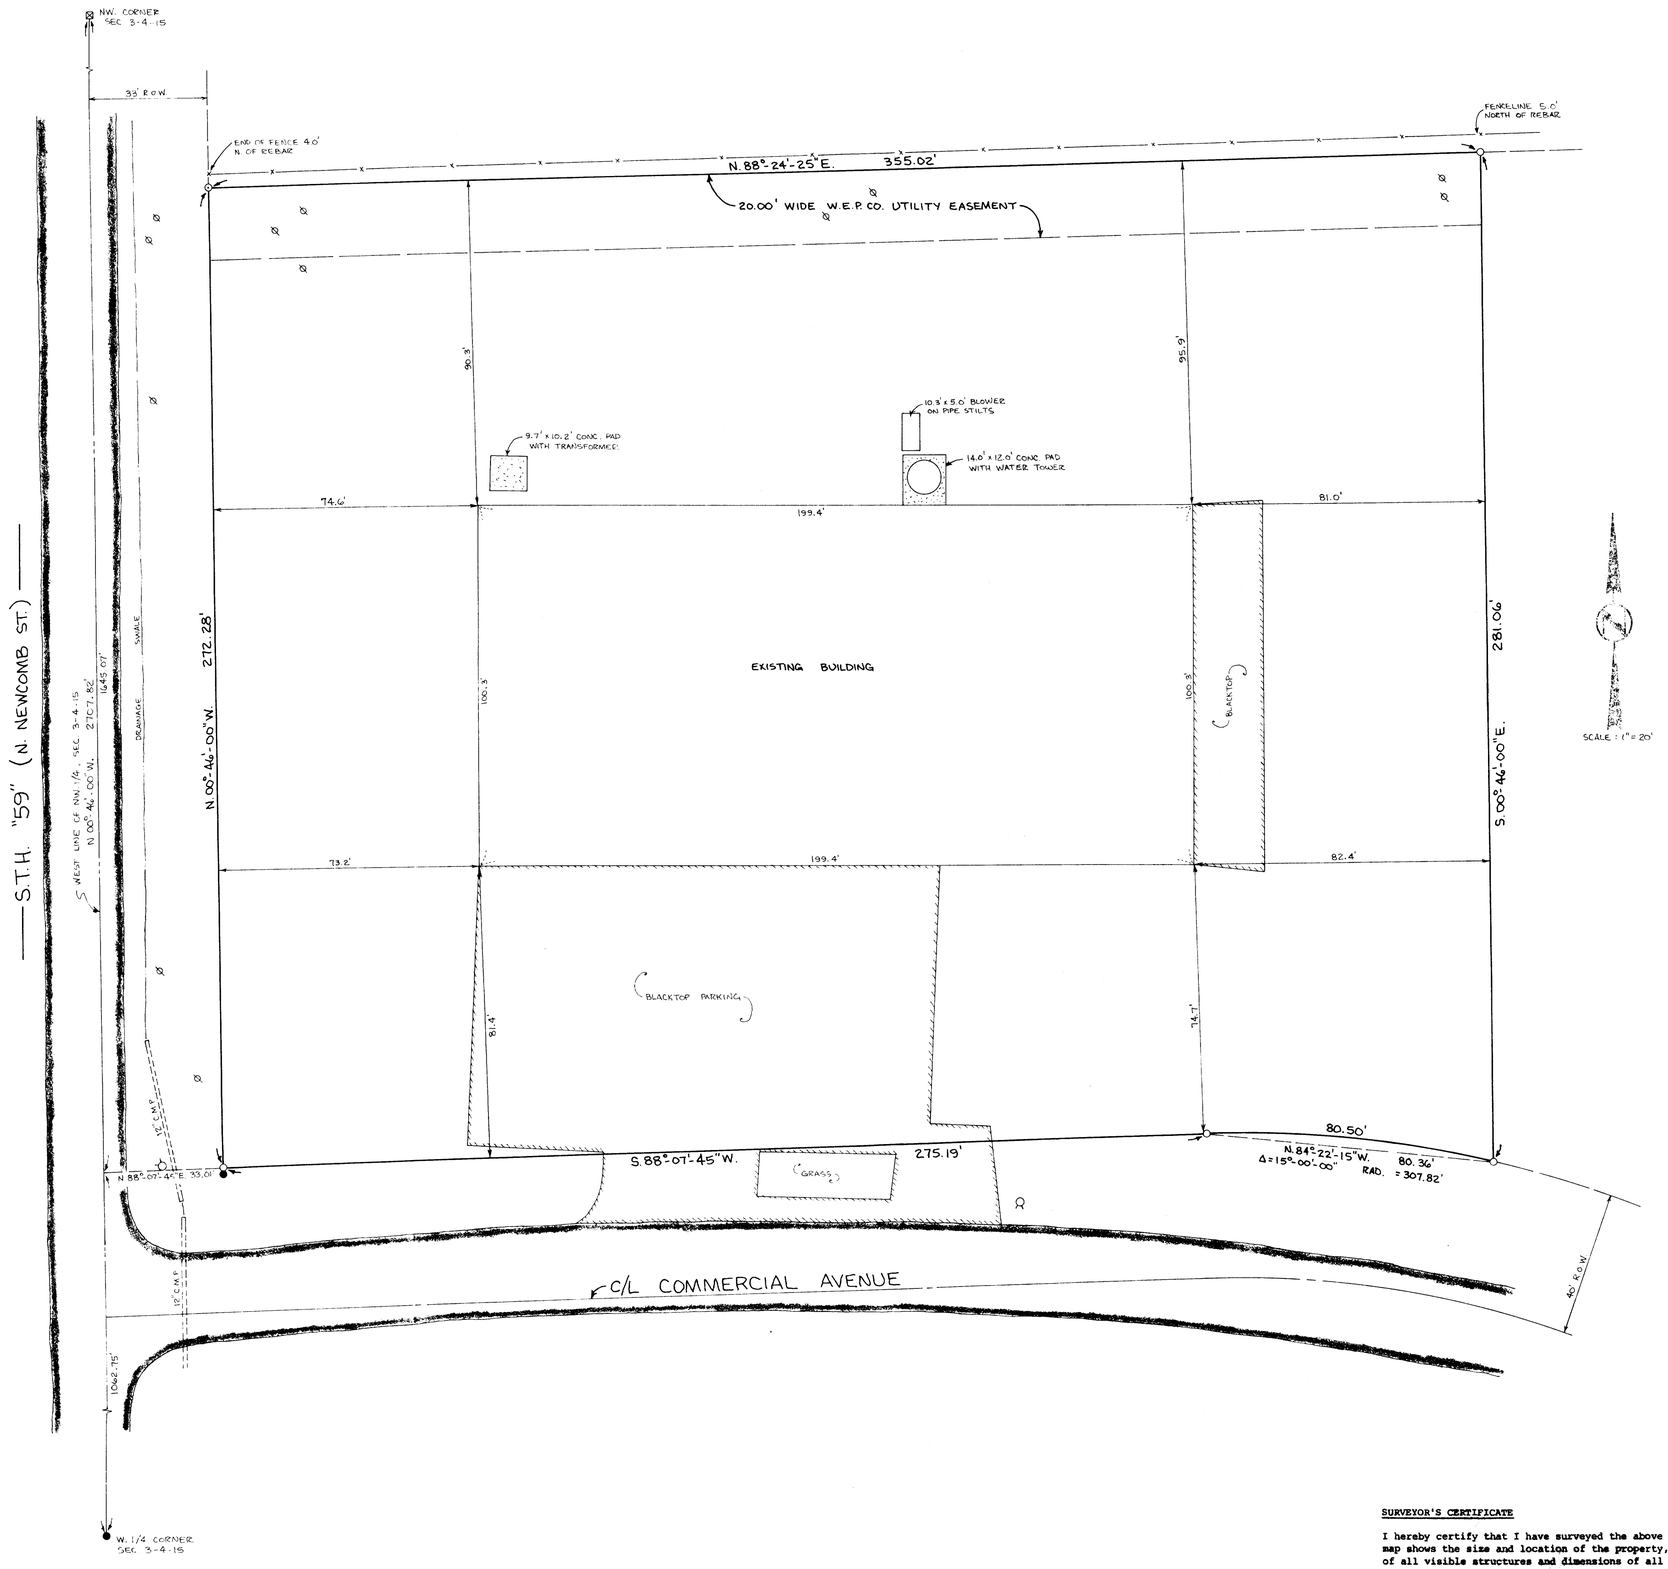

PLAT OF SURVEY

BEING ALL OF LOT 1 OF CERTIFIED SURVEY MAP NO. 457, RECORDED IN VOL. 2, PG. 242, LOCATED IN THE S.1/2 OF THE NW. 1/4 OF SEC. 3, T.4N., R.15E., CITY OF WHITEWATER, WALWORTH COUNTY, WI.

SURVEYOR
MARK A. POWERS R.L.S. 1701

SURVEY FOR
POLYMER TECHNOLOGIES
369 N. NEWCOMB ST.
WHITEWATER, WI. 53190

LEGEND
- IRON PLUG W/ "X" ON TOP
- 3/4" DIA. SOLID IRON BAR FOUND
- 1" DIA. IRON PIPE FOUND
- POWER POLE
- HYDRANT
- 3/4" DIA. SOLID IRON BAR SET, 24" LONG, WT. = 1.5 LBS./LIN. FT.

SCALE: 1" = 20'

Mark A. Powers
July 19, 1984

SURVEYOR'S CERTIFICATE

I hereby certify that I have surveyed the above described property and that the above map shows the size and location of the property, its exterior boundaries, the location of all visible structures and dimensions of all principal buildings thereon, boundary fences, apparent easements, roadways and visible encroachments, if any.

POLYMER TECHNOLOGIES
369 N. NEWCOMB ST.
WHITEWATER, WI.

WELCH, HANSON & ASSOC. INC.
PROFESSIONAL ENGINEERS - SURVEYORS
P.O. BOX 688 OCONOMOWOC WI. 53066
PHONE 367-4225

SCALE 1" = 20'	DATE JULY 1984
DRAWN BY M. POWERS	FILE NO. 1616
CHK'D BY M.A.P.	SHEET NO. OF

10-339