
PLAT OF SURVEY

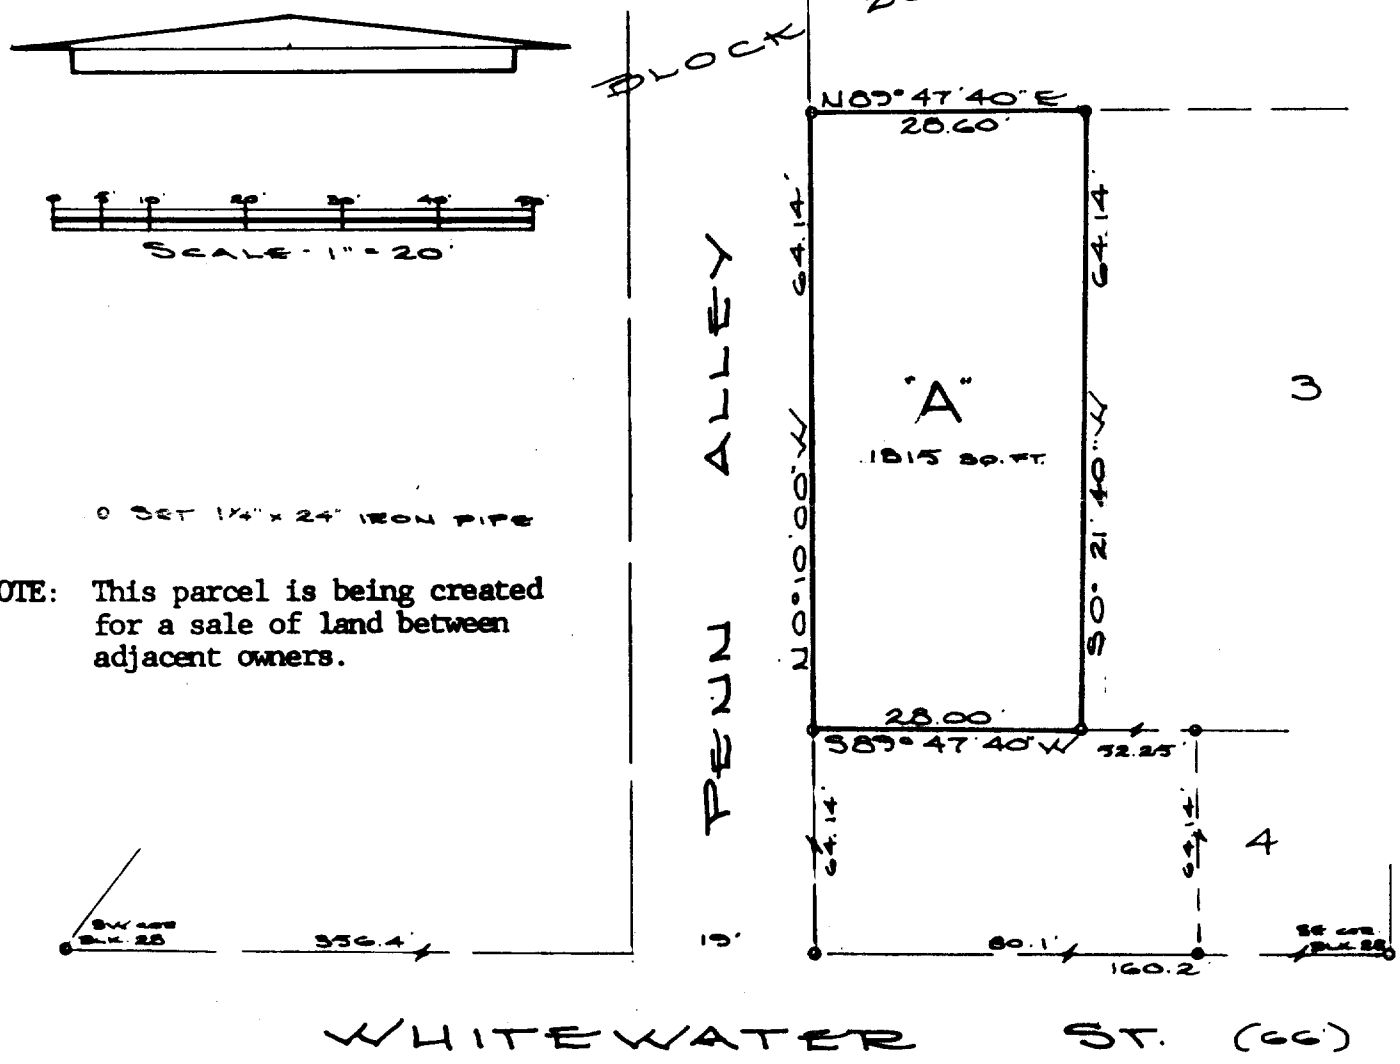

NOTE: This parcel is being created for a sale of land between adjacent owners.

DESCRIPTION

A part of Lot 3, Block 28, CHAPMAN & LUDINGTONS ADDITION in the SE¼, Section 5, T4N, R15E, City of Whitewater, Walworth County, Wisconsin, to-wit:

Beginning at a 1¼" iron pipe at the SW Corner of said Lot 3; thence N0°10'00"W, along the west line of said Lot 3, 64.14 feet to a 1¼" iron pipe at the NW Corner of said Lot 3; thence N89°47'40"E, along the north line of said Lot 3, 28.60 feet to a 1¼" iron pipe; thence S0°21'40"W, 64.14 feet to a 1¼" iron pipe on the south line of said Lot 3; thence S89°47'40"W, along said south line, 28.00 feet to the point of beginning; containing 1815 square feet.

CERTIFICATION

I hereby certify that the property described above has been surveyed under my responsible direction and supervision and that this map is a correct representation of the lot lines and dimensions and the principle lines of the permanent structures thereon.

Date 5-31-78

James B. Woodman
Registered Land Surveyor, S-1239

For: Charles Timm
516 Whitewater Street
Whitewater, WI 53190

WISCONSIN
JAMES B. WOODMAN
S-1239
FORT ATKINSON, WIS.
LAND SURVEYOR

JN 76S-19

STRAND & WOODMAN ASSOCIATES
210 Madison Ave., Fort Atkinson, WI 53538

Land Surveyors & Engineers
Phone (414) 563 - 8162

CL-97B

10-33B