
#84/73

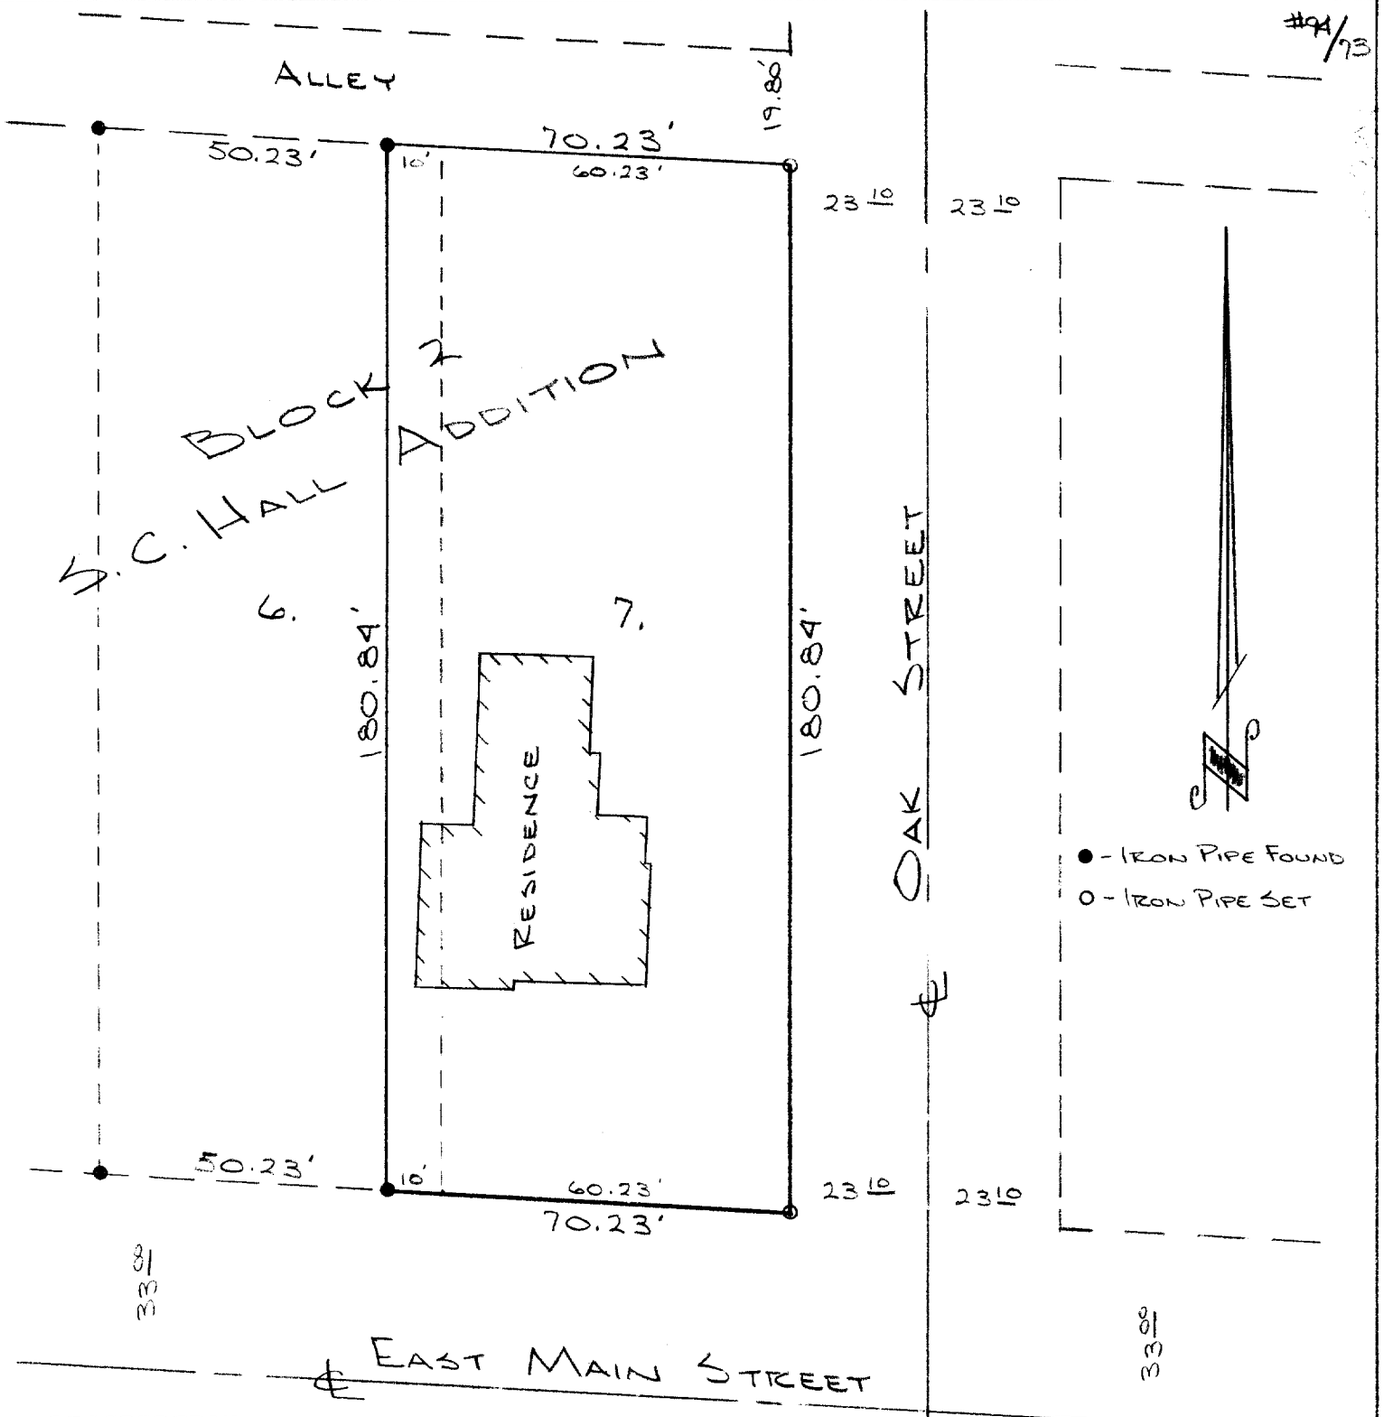

DESCRIPTION:
Lot number Seven (7) and the East 10.00 feet of Lot number Six (6) Block number Two (2) S. C. Hall Addition, City of Whitewater, Walworth County, Wisconsin.

CERTIFICATE:
I , Joseph M. Biagi, surveyor, do hereby certify that I have surveyed the lands hereon described.

September 13, 1973

Joseph M. Biagi RLS #12
Elkhorn, Wisconsin

HAS-15

10-34B