
RECEIVED
MAY 13 1986

PLAT OF SURVEY OF LOT 3 BLOCK 3, WESTERLY 1/2 OF LOT 4 BLOCK 3 ESTERLY ADDITION TO THE CITY OF WHITEWATER; EXCEPTING THERFROM BEGINNING AT THE NW CORNER OF SAID LOT 3 THENCE EASTERLY 99 FEET ALONG THE NORTHERLY LINE OF SAID LOTS; THENCE SOUTHERLY 38 FEET ALONG THE EASTERLY LINE OF THE WESTERLY 1/2 OF SAID LOT 4; THENCE IN A STRAIGHT LINE TO THE POINT OF BEGINNING ALL BEING LOCATED IN THE CITY OF WHITEWATER WALWORTH COUNTY WISCONSIN

SURVEY ORDERED BY RUMMEL DEVITT & ASSOC

SCALE 1"=50'

WISCONSIN
DANIEL D. COOPER
S-1464
ELKHORN, WIS.
LAND SURVEYOR

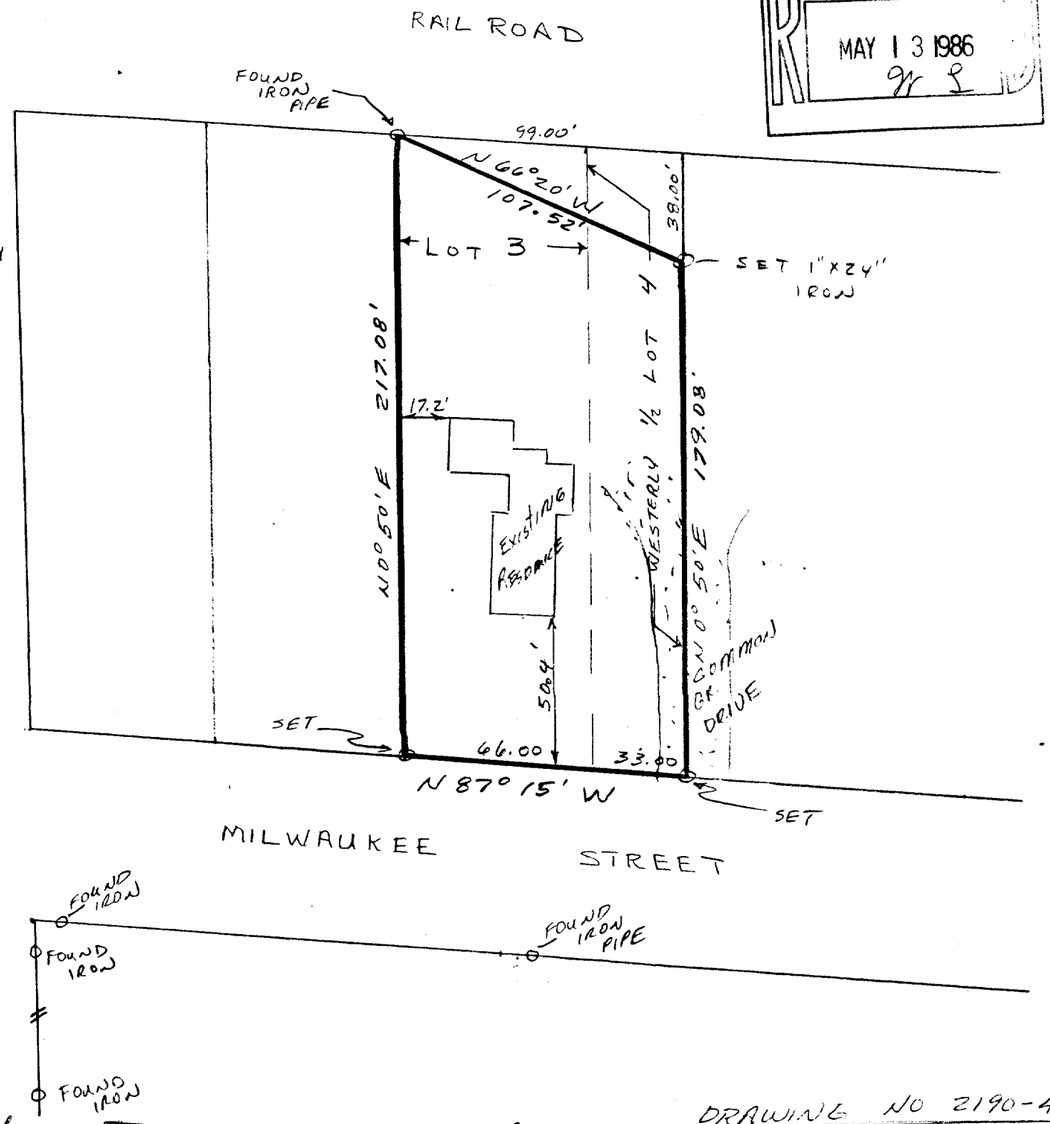

I. DANIEL D. COOPER. REGISTERED SURVEYOR. DO HEREBY CERTIFY THAT I HAVE SURVEYED THE PROPERTY DESCRIBED HEREON AND THAT THE MAP SHOWN HEREON IS A TRUE AND ACCURATE REPRESENTATION THEROF TO THE BEST OF MY PROFESSIONAL KNOWLEDGE AND BELIEF.

DATED THIS 8 DAY OF MAY, 1986 Daniel D Cooper
DANIEL D. COOPER. RLS NO. S-1464

CITY of WHITEWATER . TAX PARCEL ES 00013

DRAWING NO 2190-4-41
10-354-C