
225-21

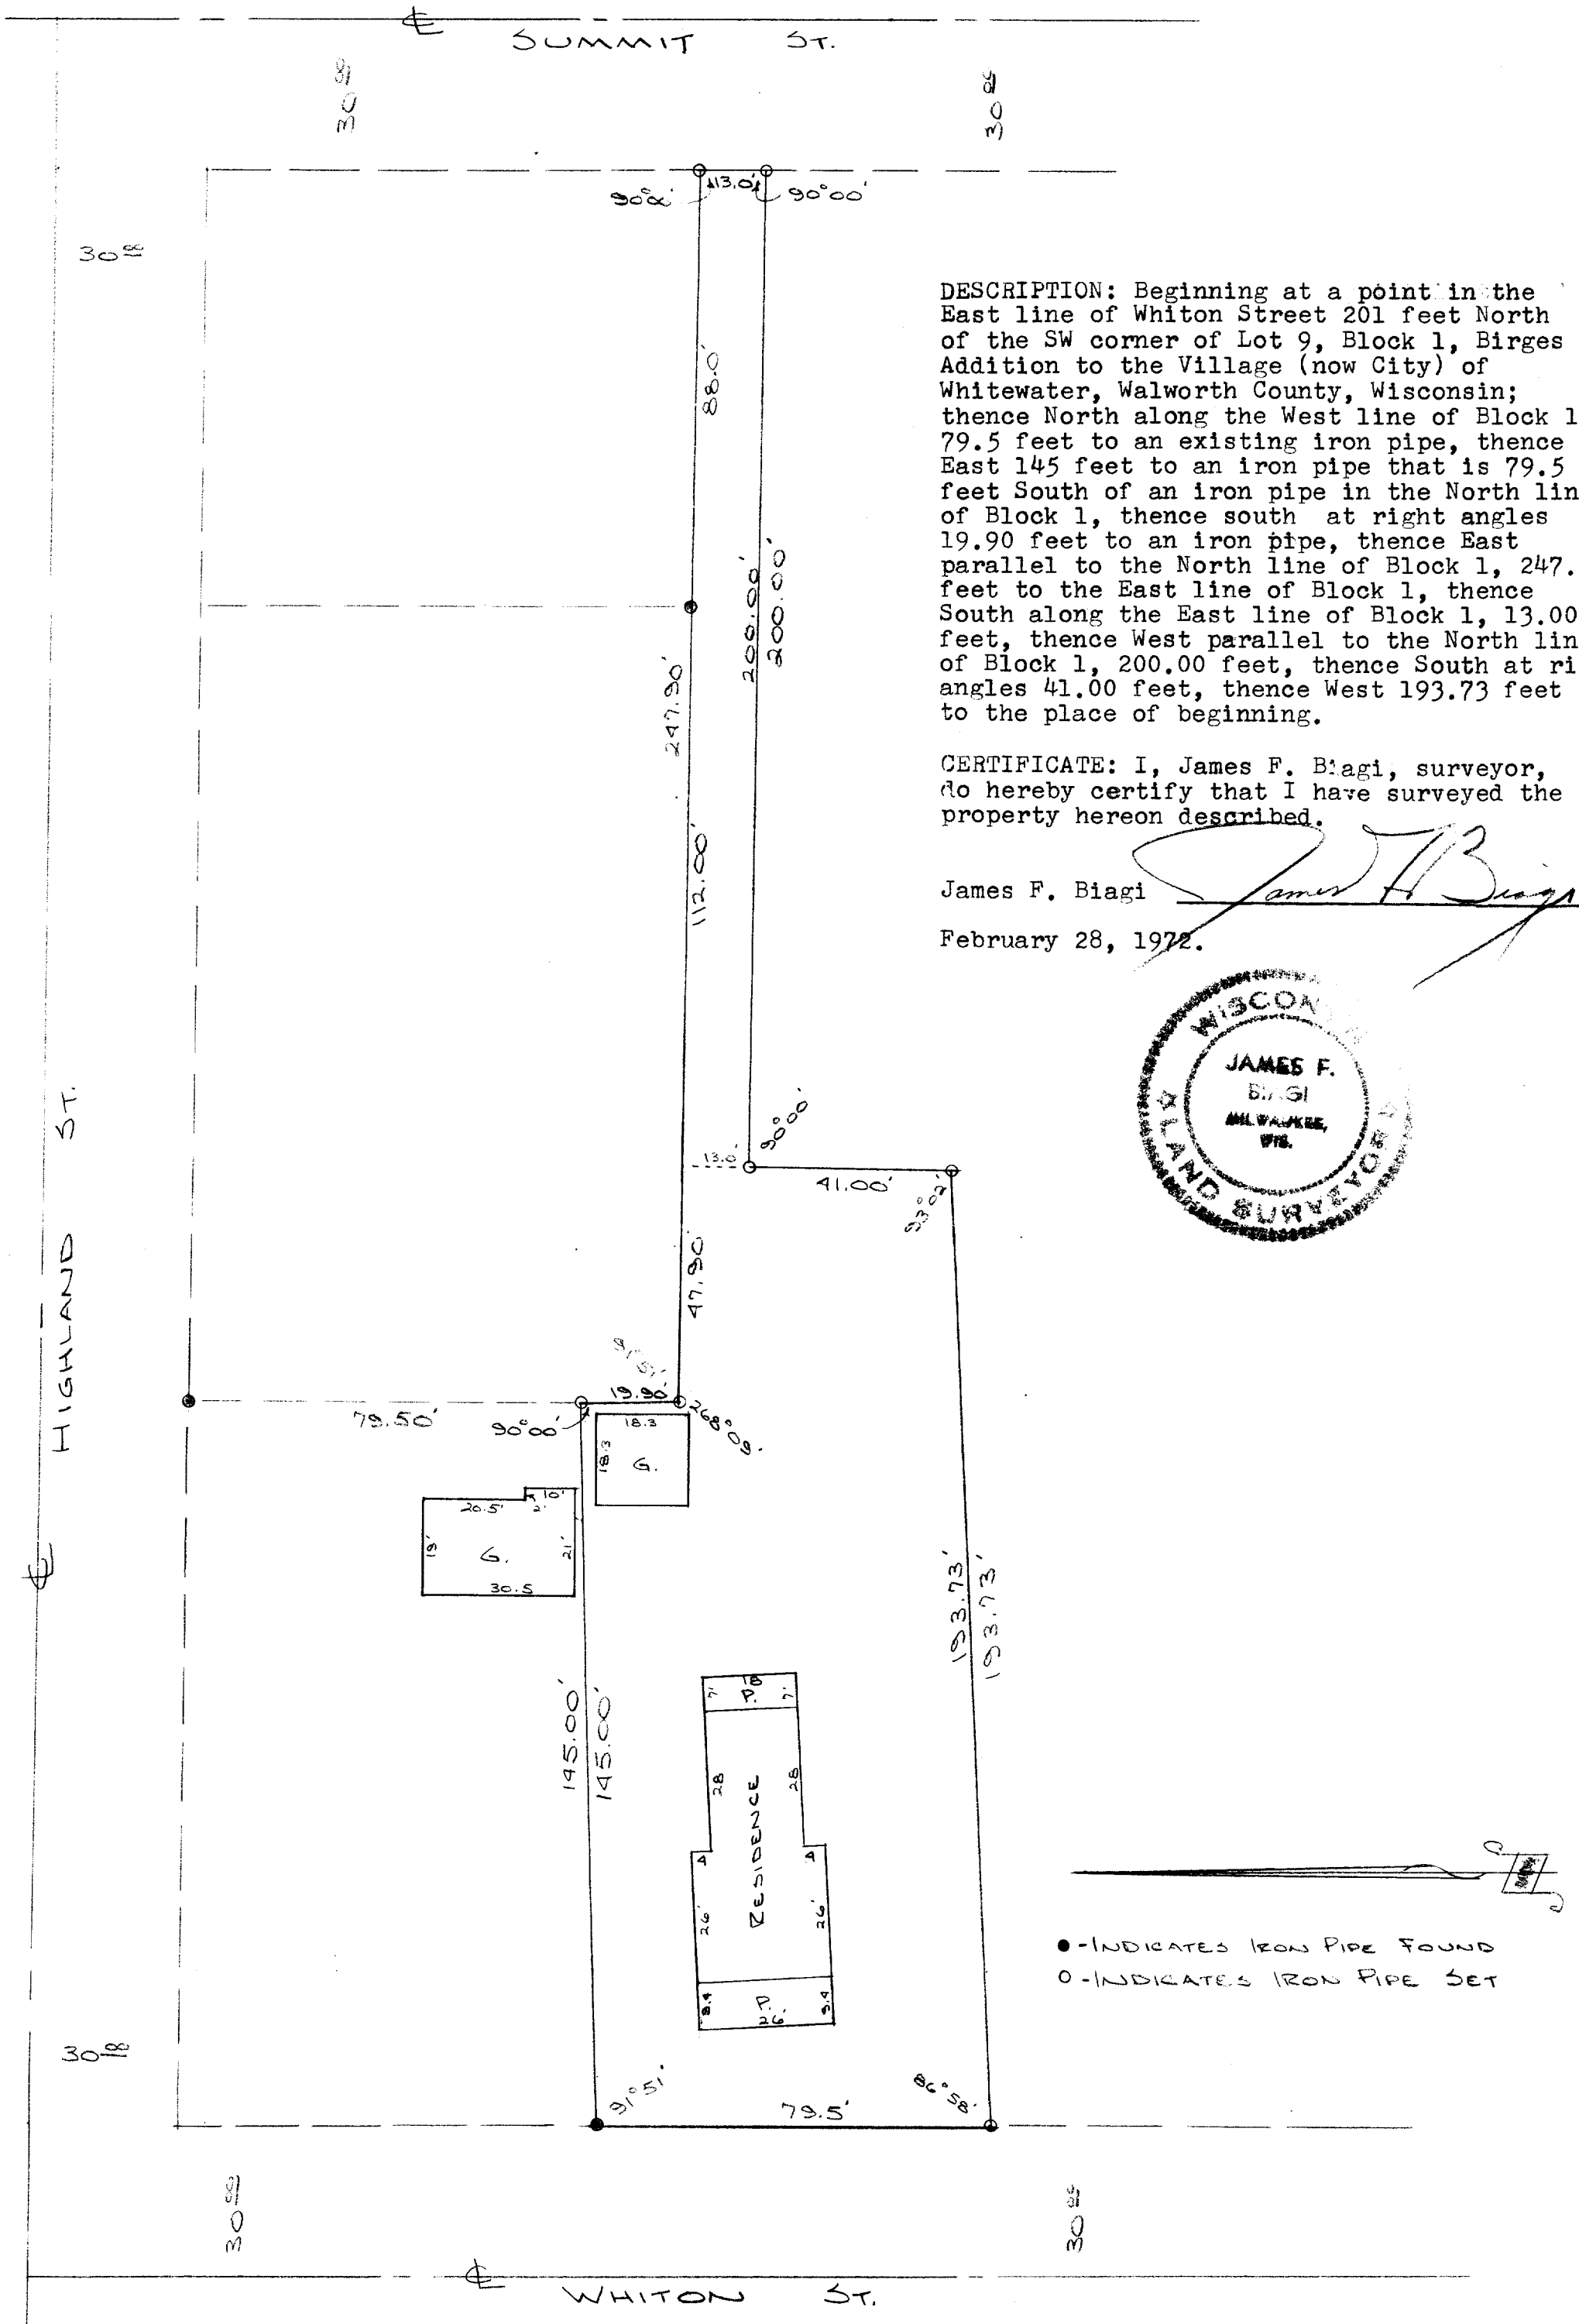

DESCRIPTION: Beginning at a point in the East line of Whiton Street 201 feet North of the SW corner of Lot 9, Block 1, Birges Addition to the Village (now City) of Whitewater, Walworth County, Wisconsin; thence North along the West line of Block 1, 79.5 feet to an existing iron pipe, thence East 145 feet to an iron pipe that is 79.5 feet South of an iron pipe in the North line of Block 1, thence south at right angles 19.90 feet to an iron pipe, thence East parallel to the North line of Block 1, 247.9 feet to the East line of Block 1, thence South along the East line of Block 1, 13.00 feet, thence West parallel to the North line of Block 1, 200.00 feet, thence South at right angles 41.00 feet, thence West 193.73 feet to the place of beginning.

CERTIFICATE: I, James F. Biagi, surveyor, do hereby certify that I have surveyed the property hereon described.

James F. Biagi

February 28, 1972.

WISCONSIN
JAMES F. BIAGI
MILWAUKEE, WIS.
LAND SURVEYOR

● - INDICATES IRON PIPE FOUND
O - INDICATES IRON PIPE SET