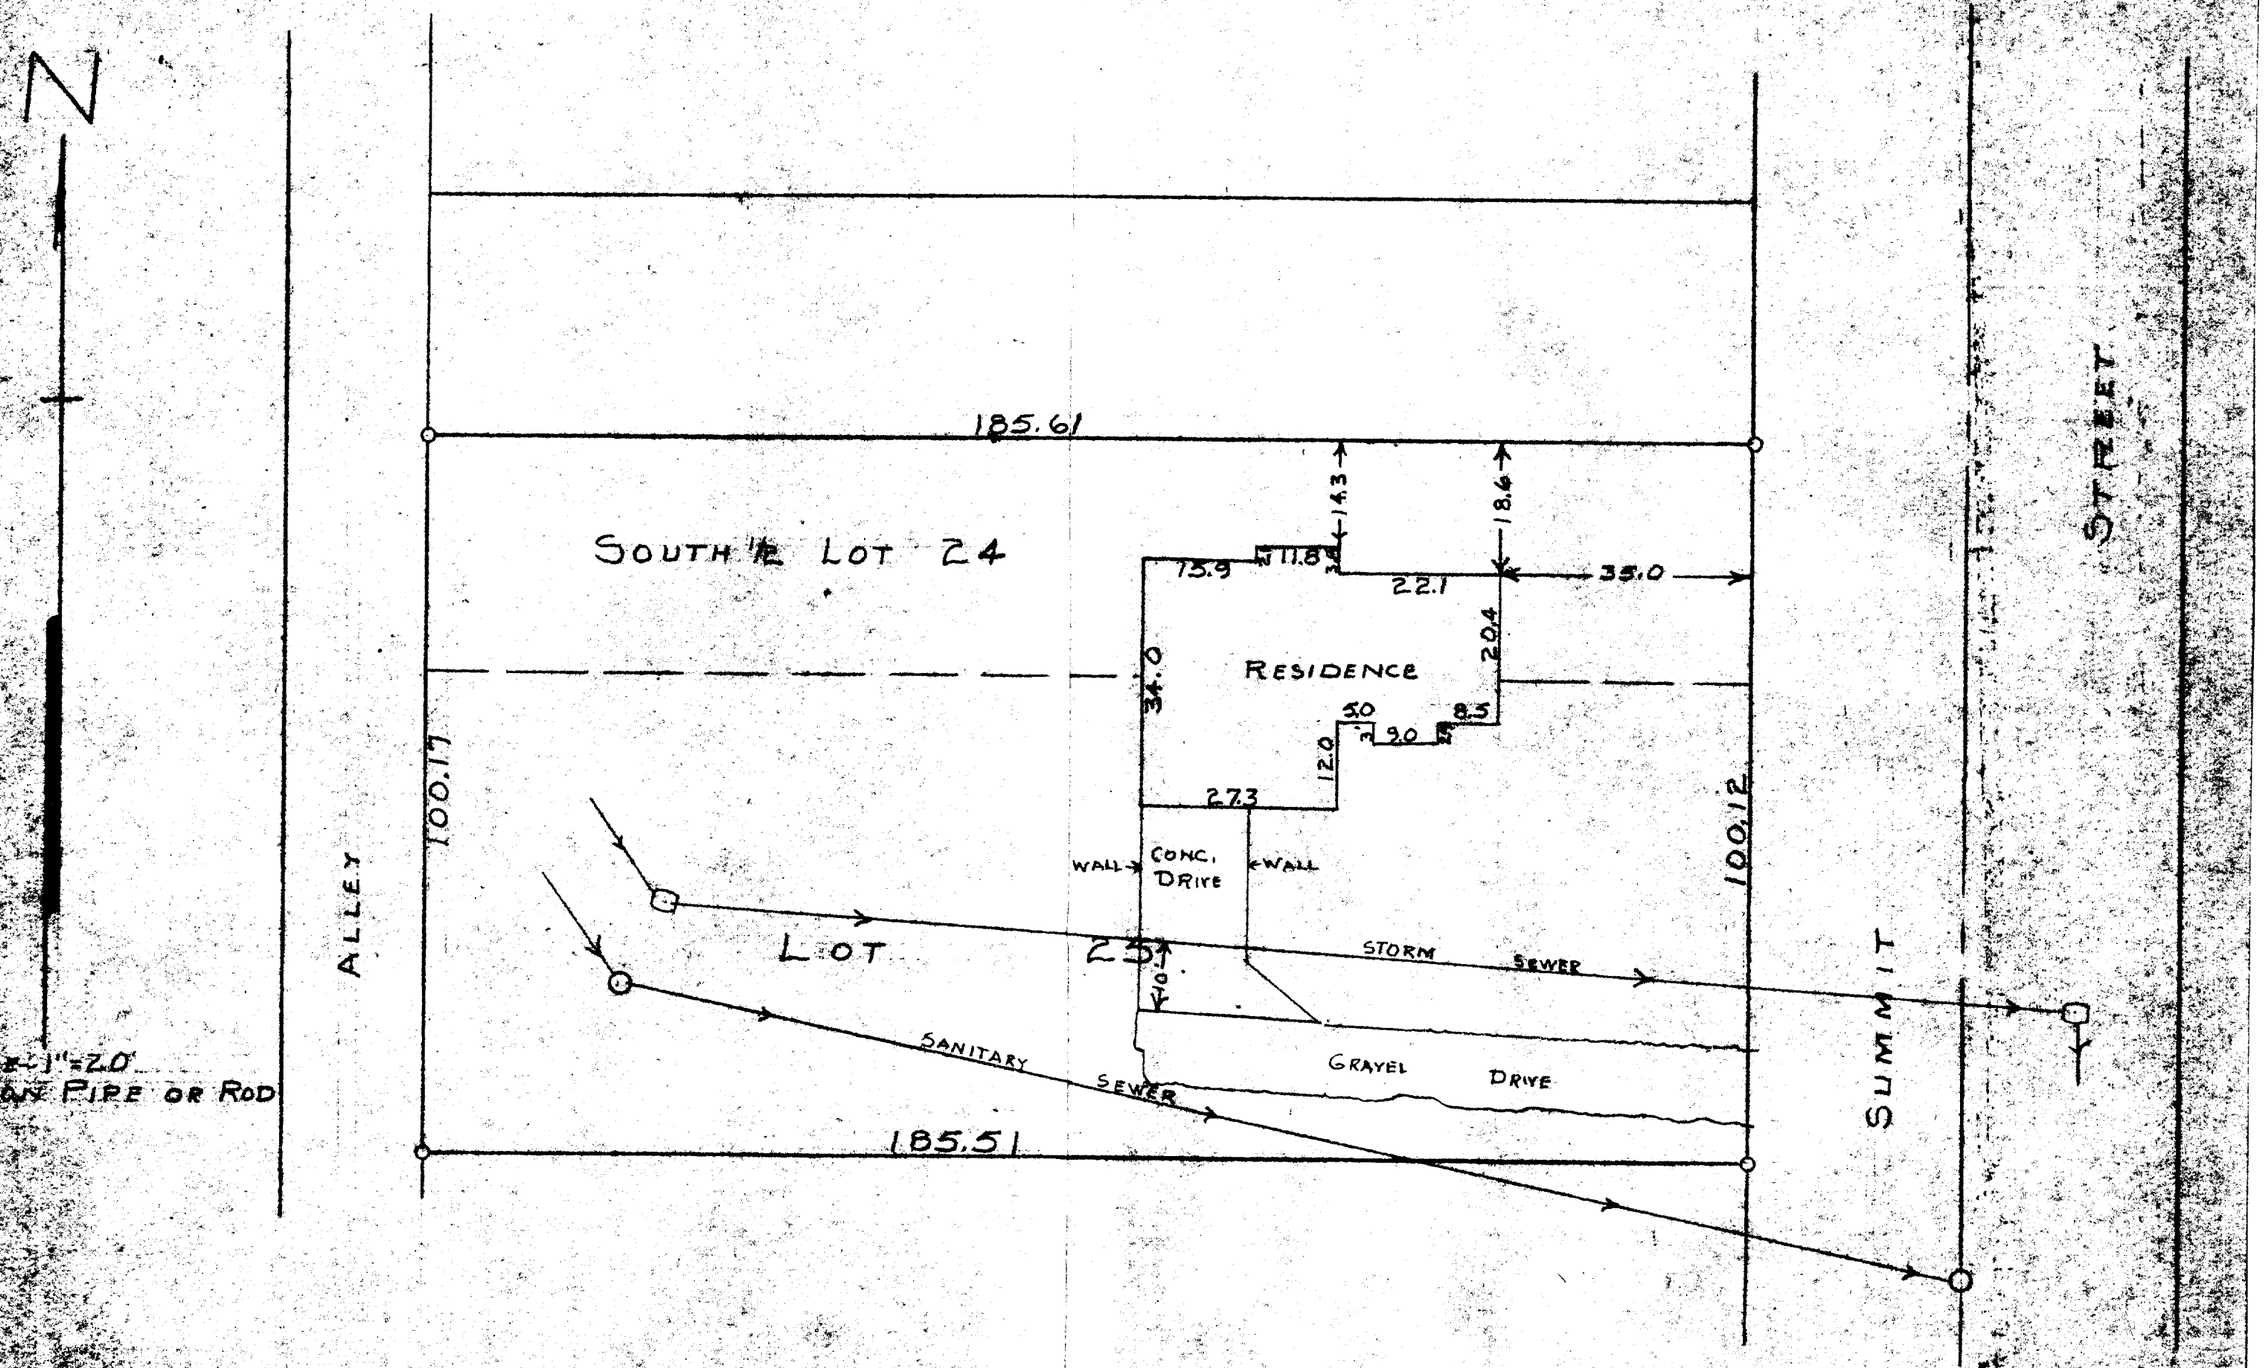

STATE OF WISCONSIN }
WALWORTH COUNTY } SS

I, GEORGE T. DUNHAM, DO HEREBY CERTIFY THAT I HAVE SURVEYED THE PROPERTY DESCRIBED AS FOLLOWS:

LOT 25 AND THE SOUTH ½ OF LOT 24, BLOCK 2, BIRGE'S ADDITION TO THE CITY OF WHITEWATER, WALWORTH COUNTY, WISCONSIN.

AND THAT THE PLAT SHOWN ABOVE IS A CORRECT REPRESENTATION OF THE PROPERTY LINES AND OF THE IMPROVEMENTS LOCATED THEREON

AUG. 28, 1958
REVISED OCT. 8, 1958

George T. Dunham
GEORGE T. DUNHAM, SURVEYOR
DELAVAN, WISCONSIN

10-46

BIR-32