


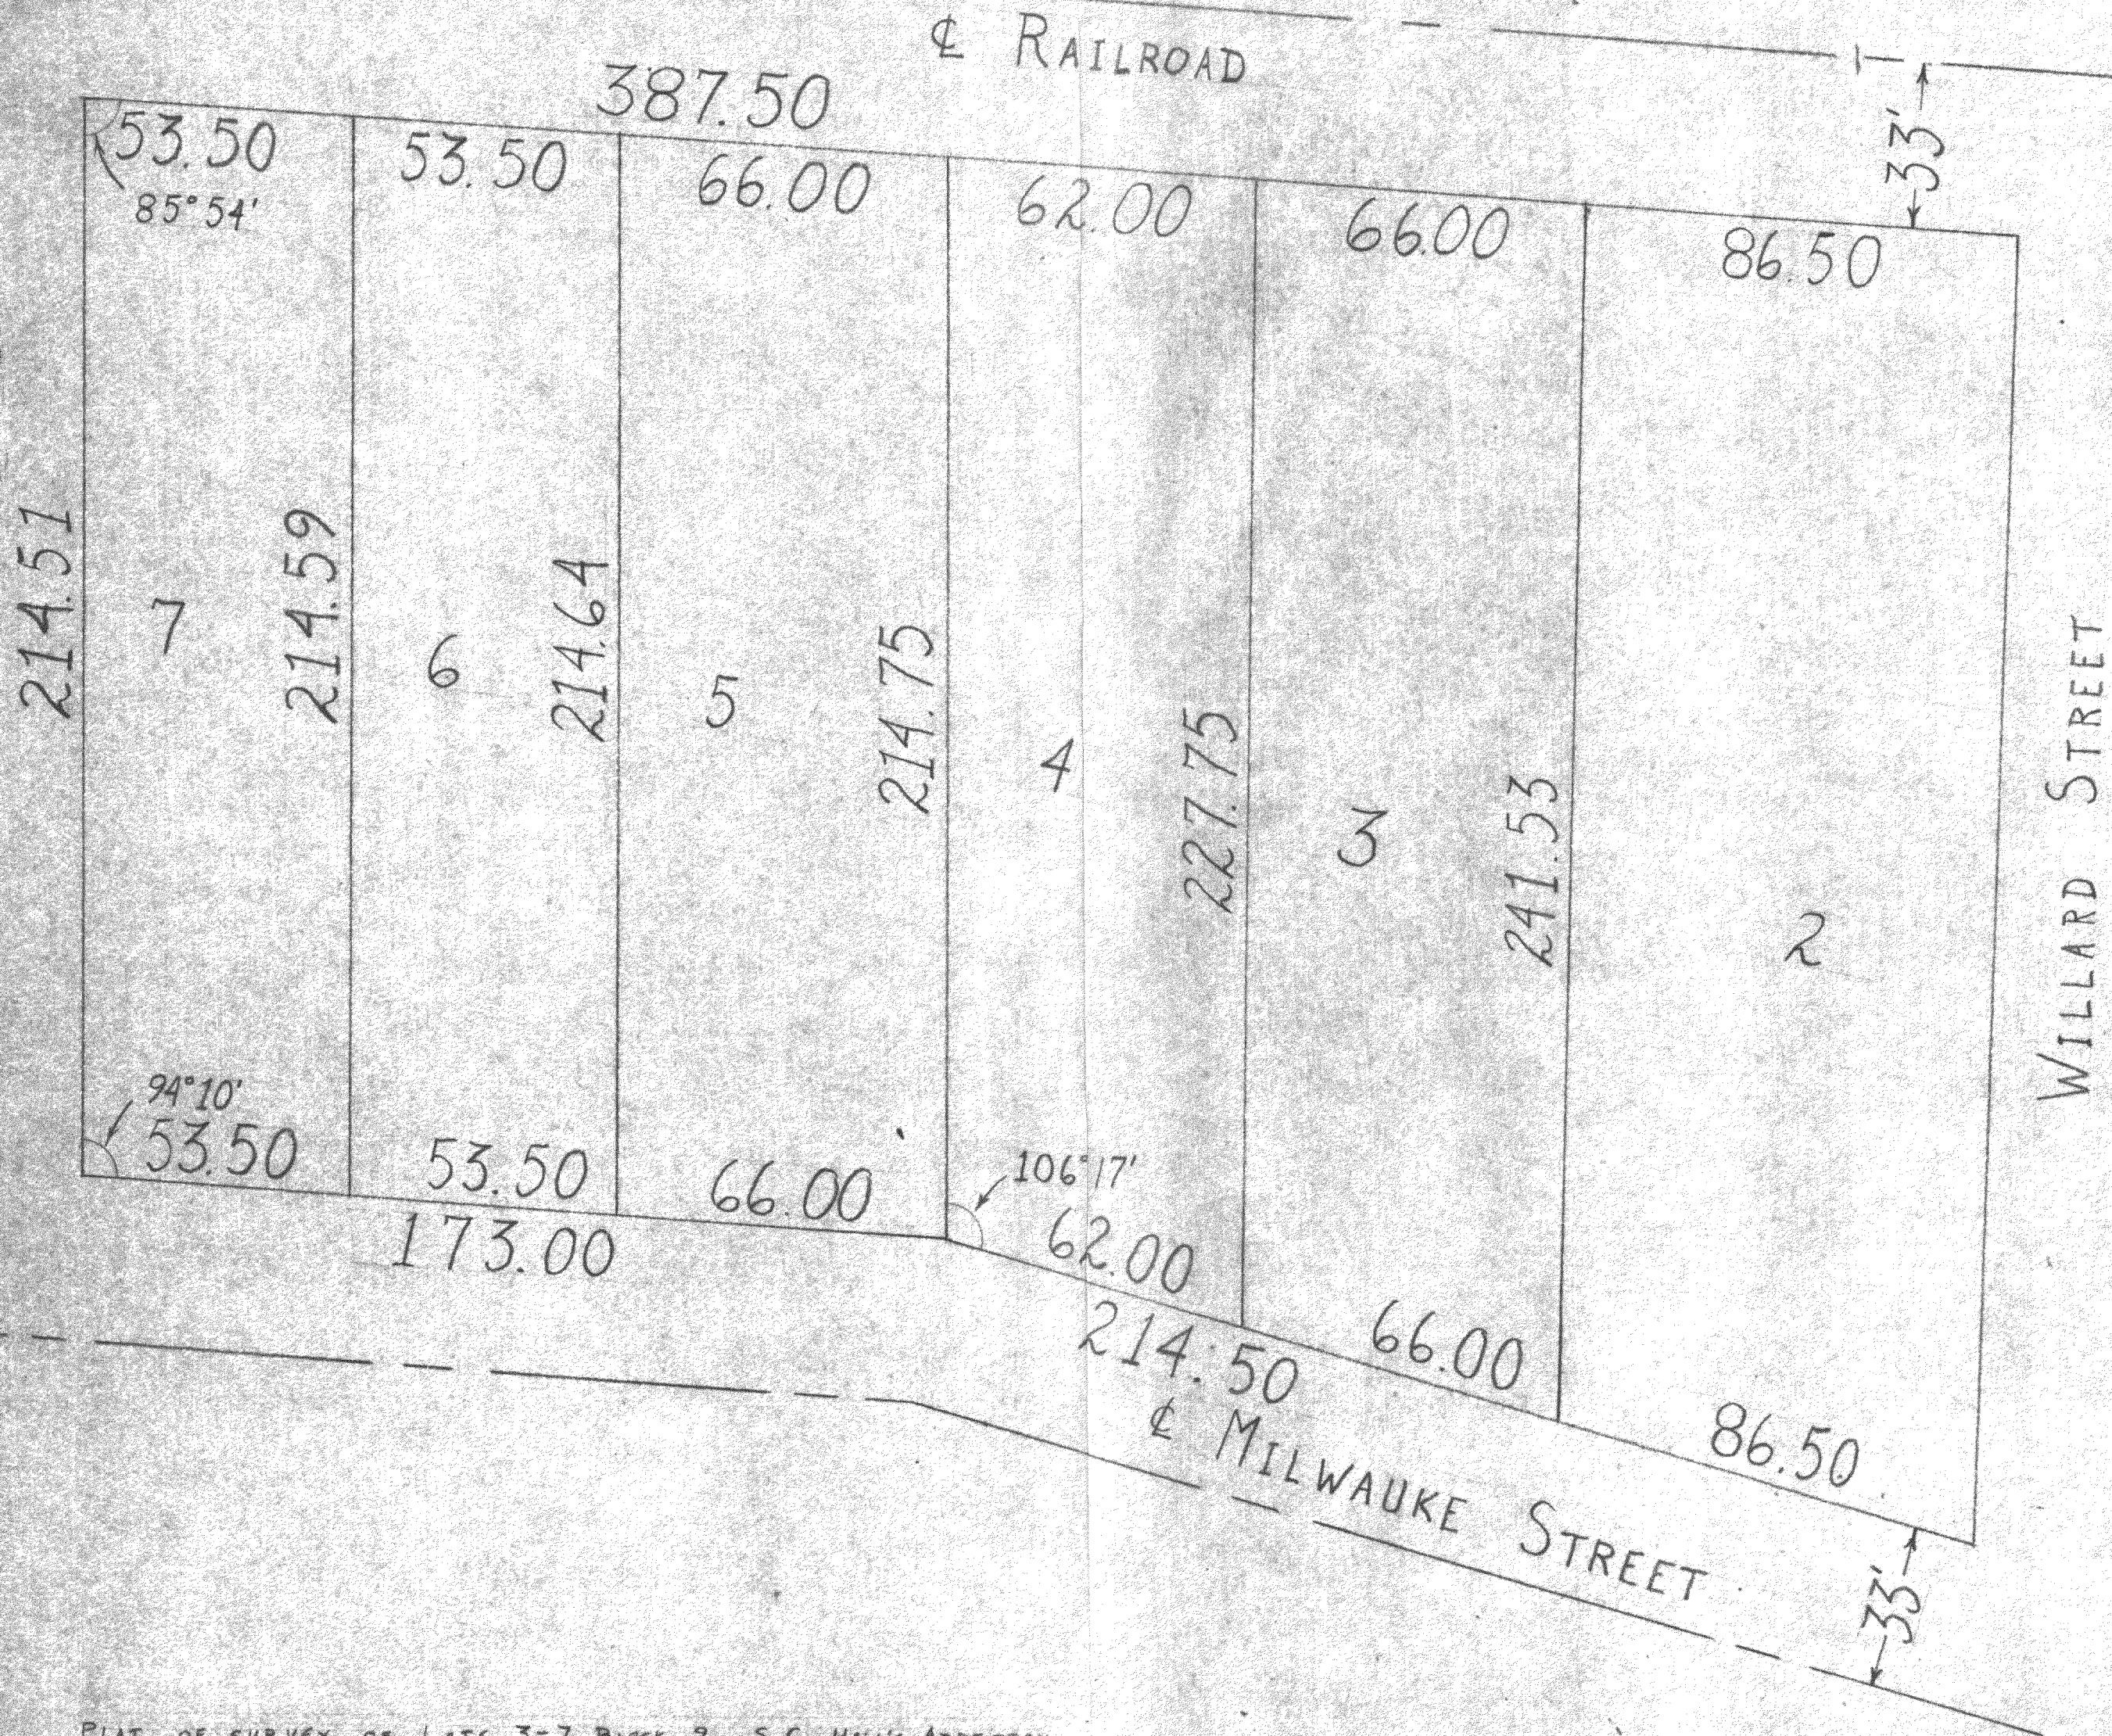

PLAT OF SURVEY OF LOTS 3-7 BLOCK 9 S. C. HALL'S ADDITION  
 TO CITY OF WHITEWATER, WALWORTH COUNTY, WISCONSIN AS  
 COPIED FROM A PLAT OF SURVEY PREPARED BY JENSEN AND  
 JOHNSON, ENGINEERS OF ELKHORN, WISCONSIN, DATED MAY 1952  
 JUNE 16, 1959

*George T. Dunham*  
 GEORGE T. DUNHAM, SURVEYOR  
 DELAVAN, WISCONSIN

SCALE - 1" = 30'

10-49

HAS 51.51A