


PLAT OF SURVEY
OF PROPERTY DESCRIBED BELOW

Form 428 700 9-10-29

Lot 17 and 18 in Block 4 of Tripp's 2nd Addition to Whitewater, Wisconsin. Also that part of said Block (4) described as follows: Beginning at the southwest corner of Lot 18 of said Block 4; running thence westerly along the northerly line of the C. M. St. P. and P. Ry. fifteen (15.00) feet; thence northerly to the northwest corner of said Lot 18; thence southerly along the westerly line of said Lot 18 to the place of beginning.

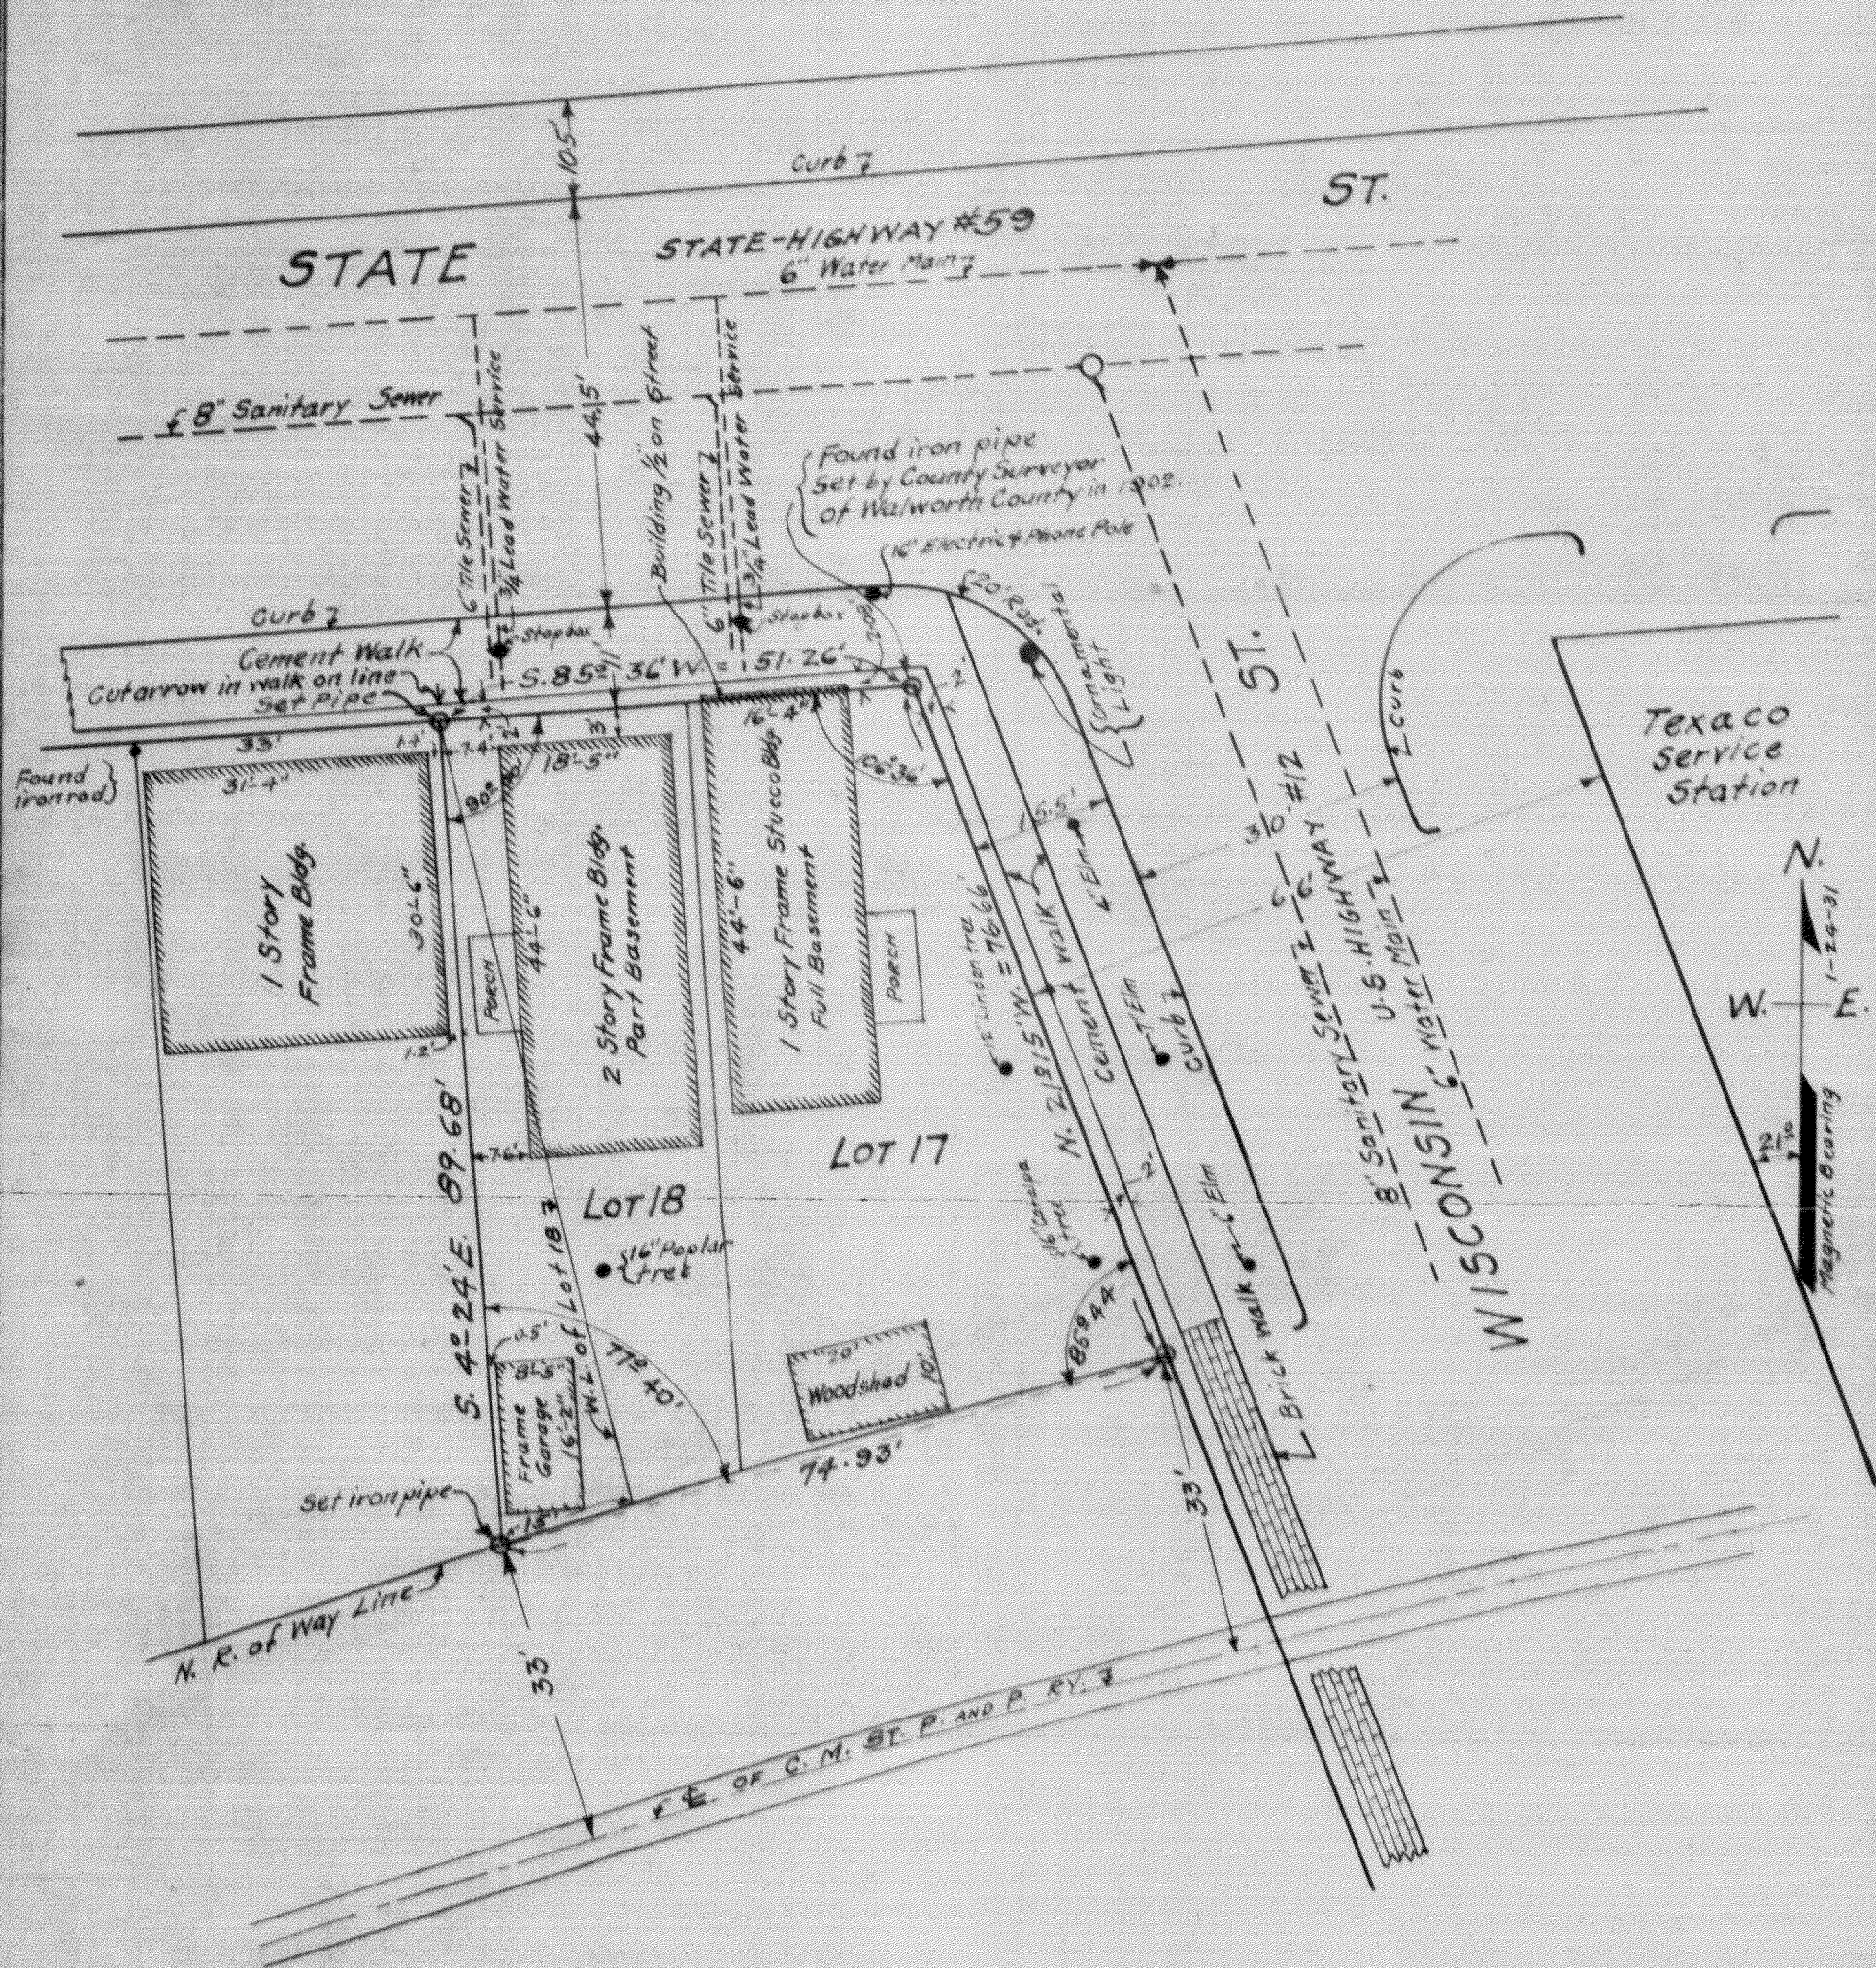

SPECIFICATIONS

- 1 Property lines should be marked by crosses or notches in sidewalk, and by iron pipes or pins at least 3 ft. long set at all corners.
- 2 Grades not to be determined unless requested.
- 3 Plat shall conform to following requirements:
 - A Show all sidewalks and curbs adjoining property and probable location of proposed walks and curbs. Indicate distance between property lines and sidewalks.
 - B Show names and widths of streets and alleys.
 - C Show location of sewer and water pipes.
 - D Show any building line restrictions.
 - E Mark plainly all property dimensions and angles other than 90°.
 - F Draw plat to scale as large as standard sheet will permit.
 - G Show location and dimensions of existing buildings and structures on property, describing the same briefly and indicating whether buildings or structures on adjoining property encroach on tract surveyed, and whether structures on property surveyed encroach on adjoining property.
 - H Indicate on plat the direction of "North."

Note: Survey should never be made until Law Department has examined title to real estate.

I, *B. J. Bunn*, do hereby certify that I have surveyed the property described above according to official records, and that the plat above drawn is a correct representation of said survey.

Janesville, Wis., Jan. 30, 1931.