GEORGE T. DUNHAM
SURVEYING & SUBDIVIDING
DELAVAN, WISCONSIN

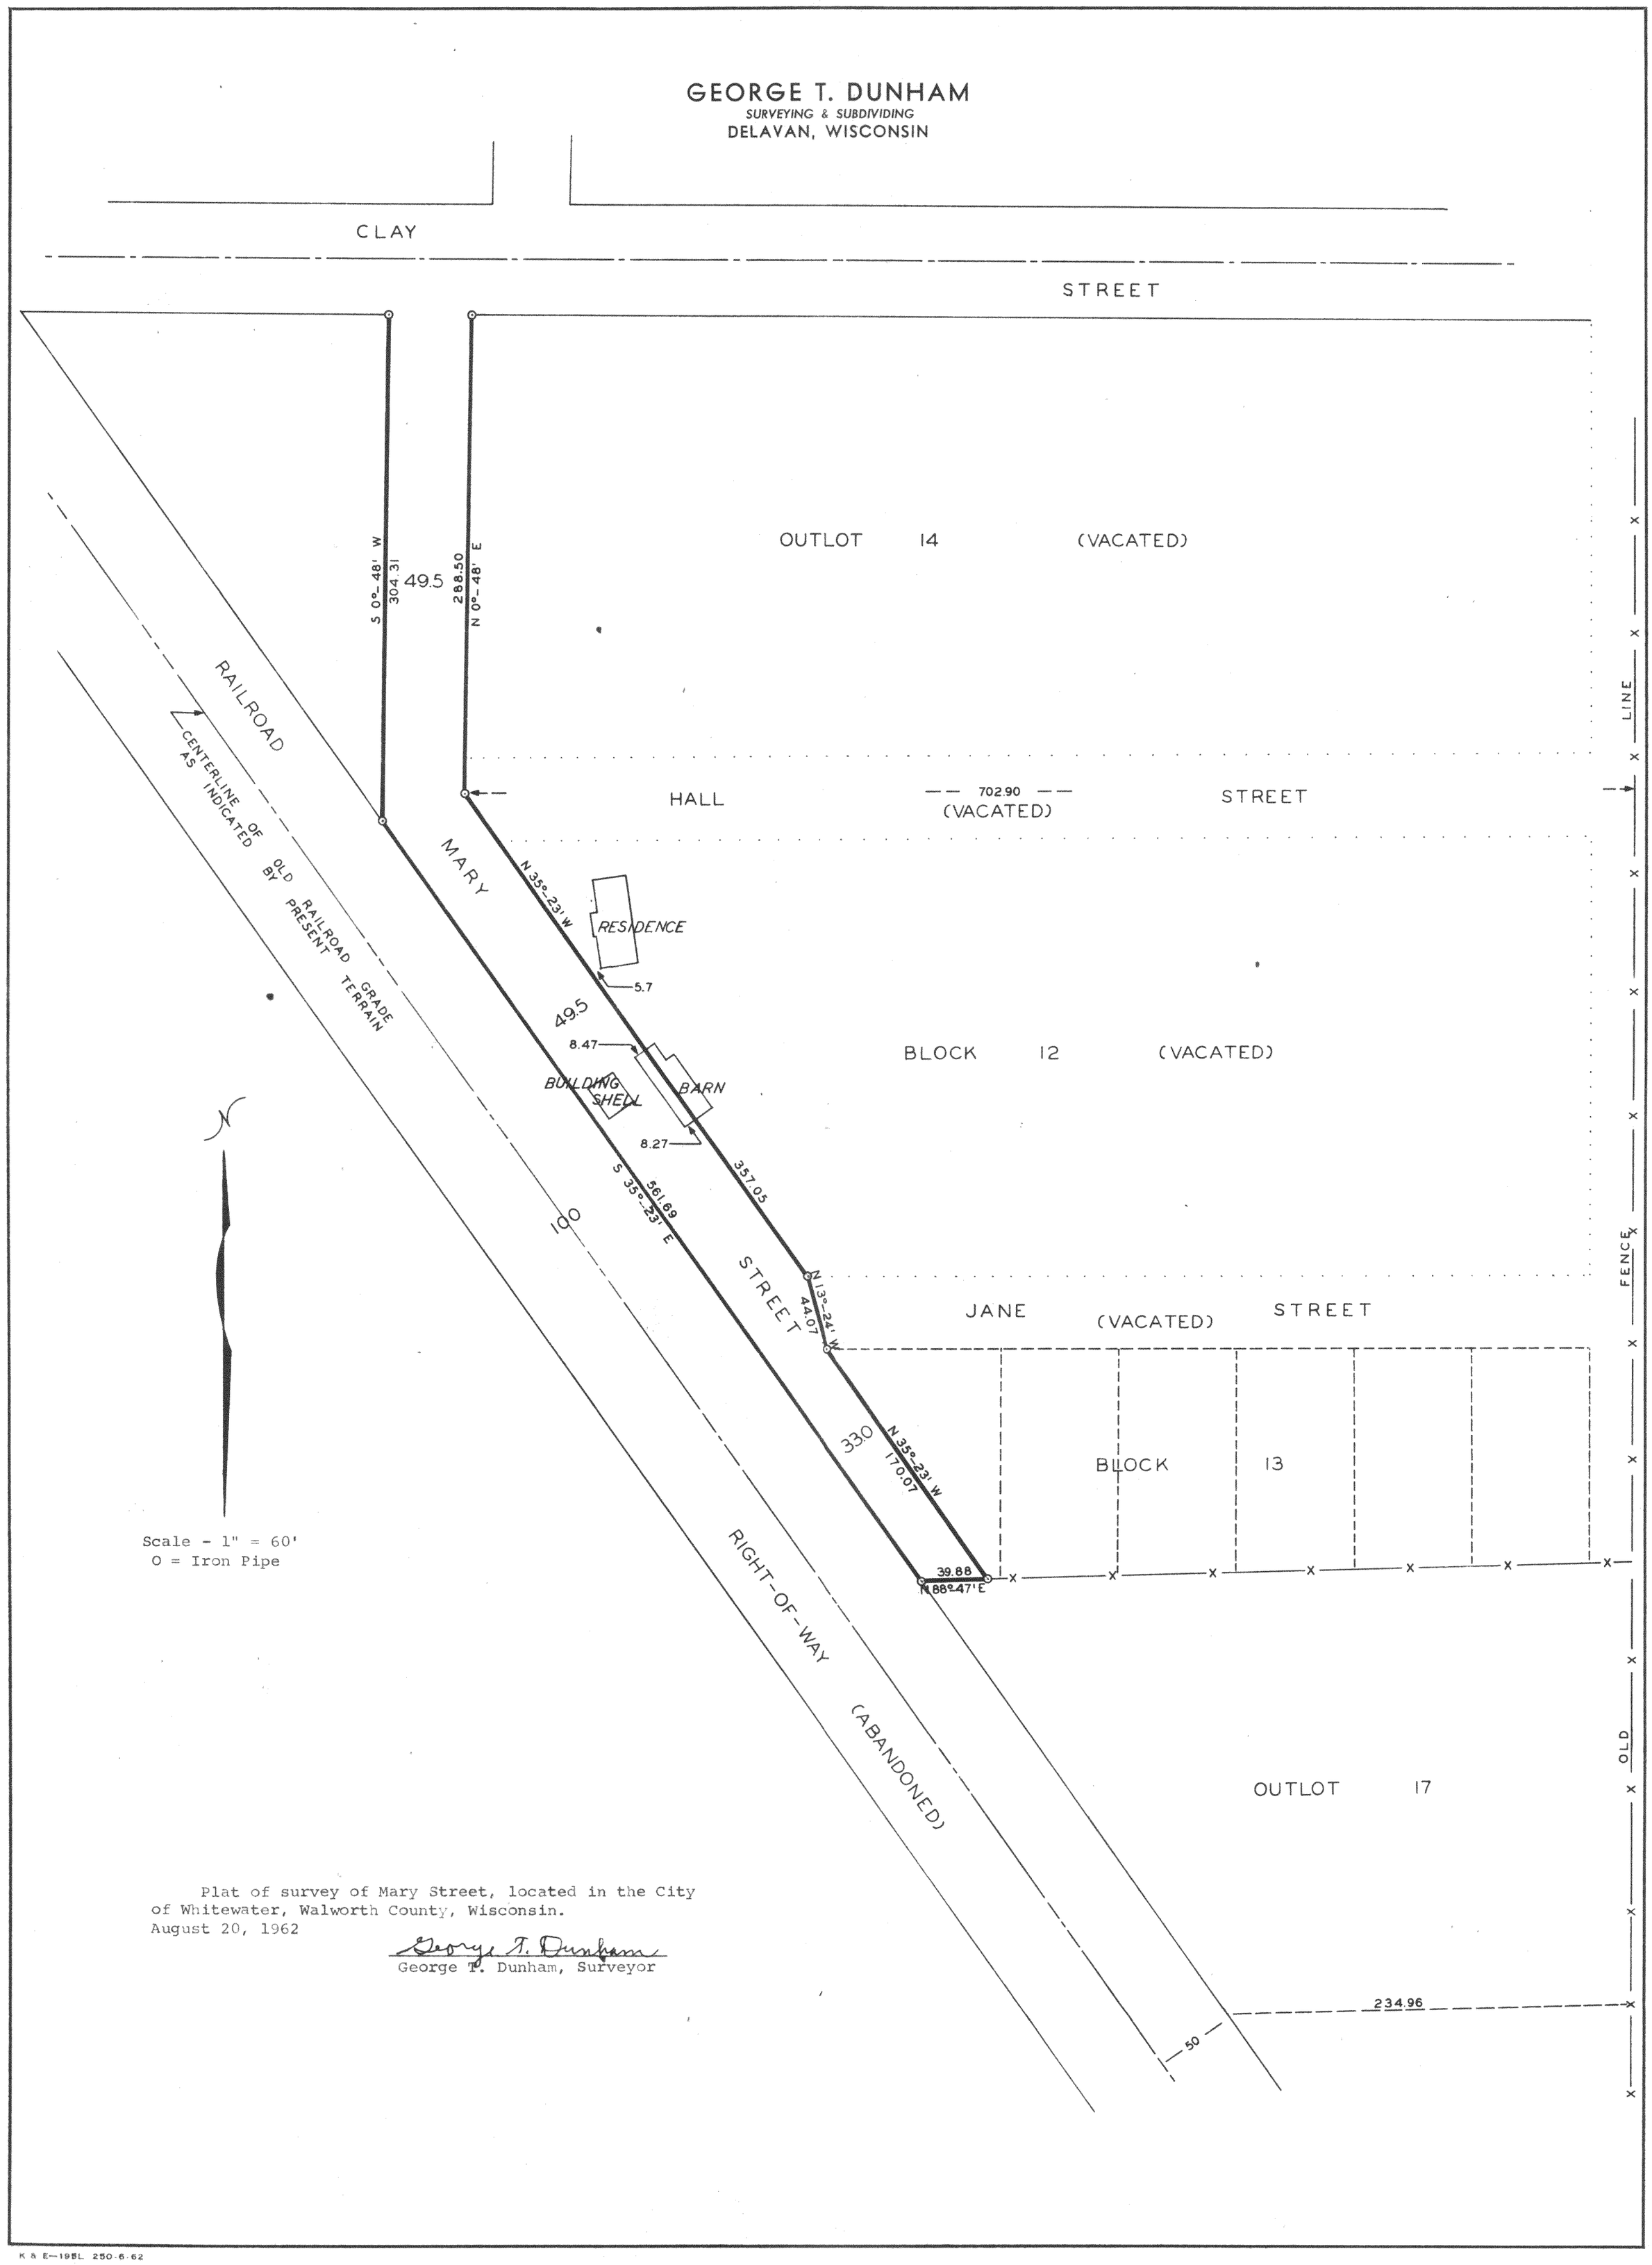

Plat of survey of Mary Street, located in the City of Whitewater, Walworth County, Wisconsin.
August 20, 1962

George T. Dunham
George T. Dunham, Surveyor

K & E—195L 250-6-62

10-71