2

4039

Job No. 6156

HOWARD E. HANSEN

Wisconsin Land Surveyor

1632 DOUGLAS AVENUE

RACINE, WISCONSIN


Res. Phone MElrose 4-0565

Office Phone MElrose 7-3346

PLAT OF SURVEY

OF PROPERTY OF THRIFTY BUILDERS INC.

described as follows: PART OF THE S. ½ OF THE N.W. ¼ OF SEC. 5, TN 4 N., R. 15 E., CITY OF WHITEWATER, WALWORTH Co., WIS.

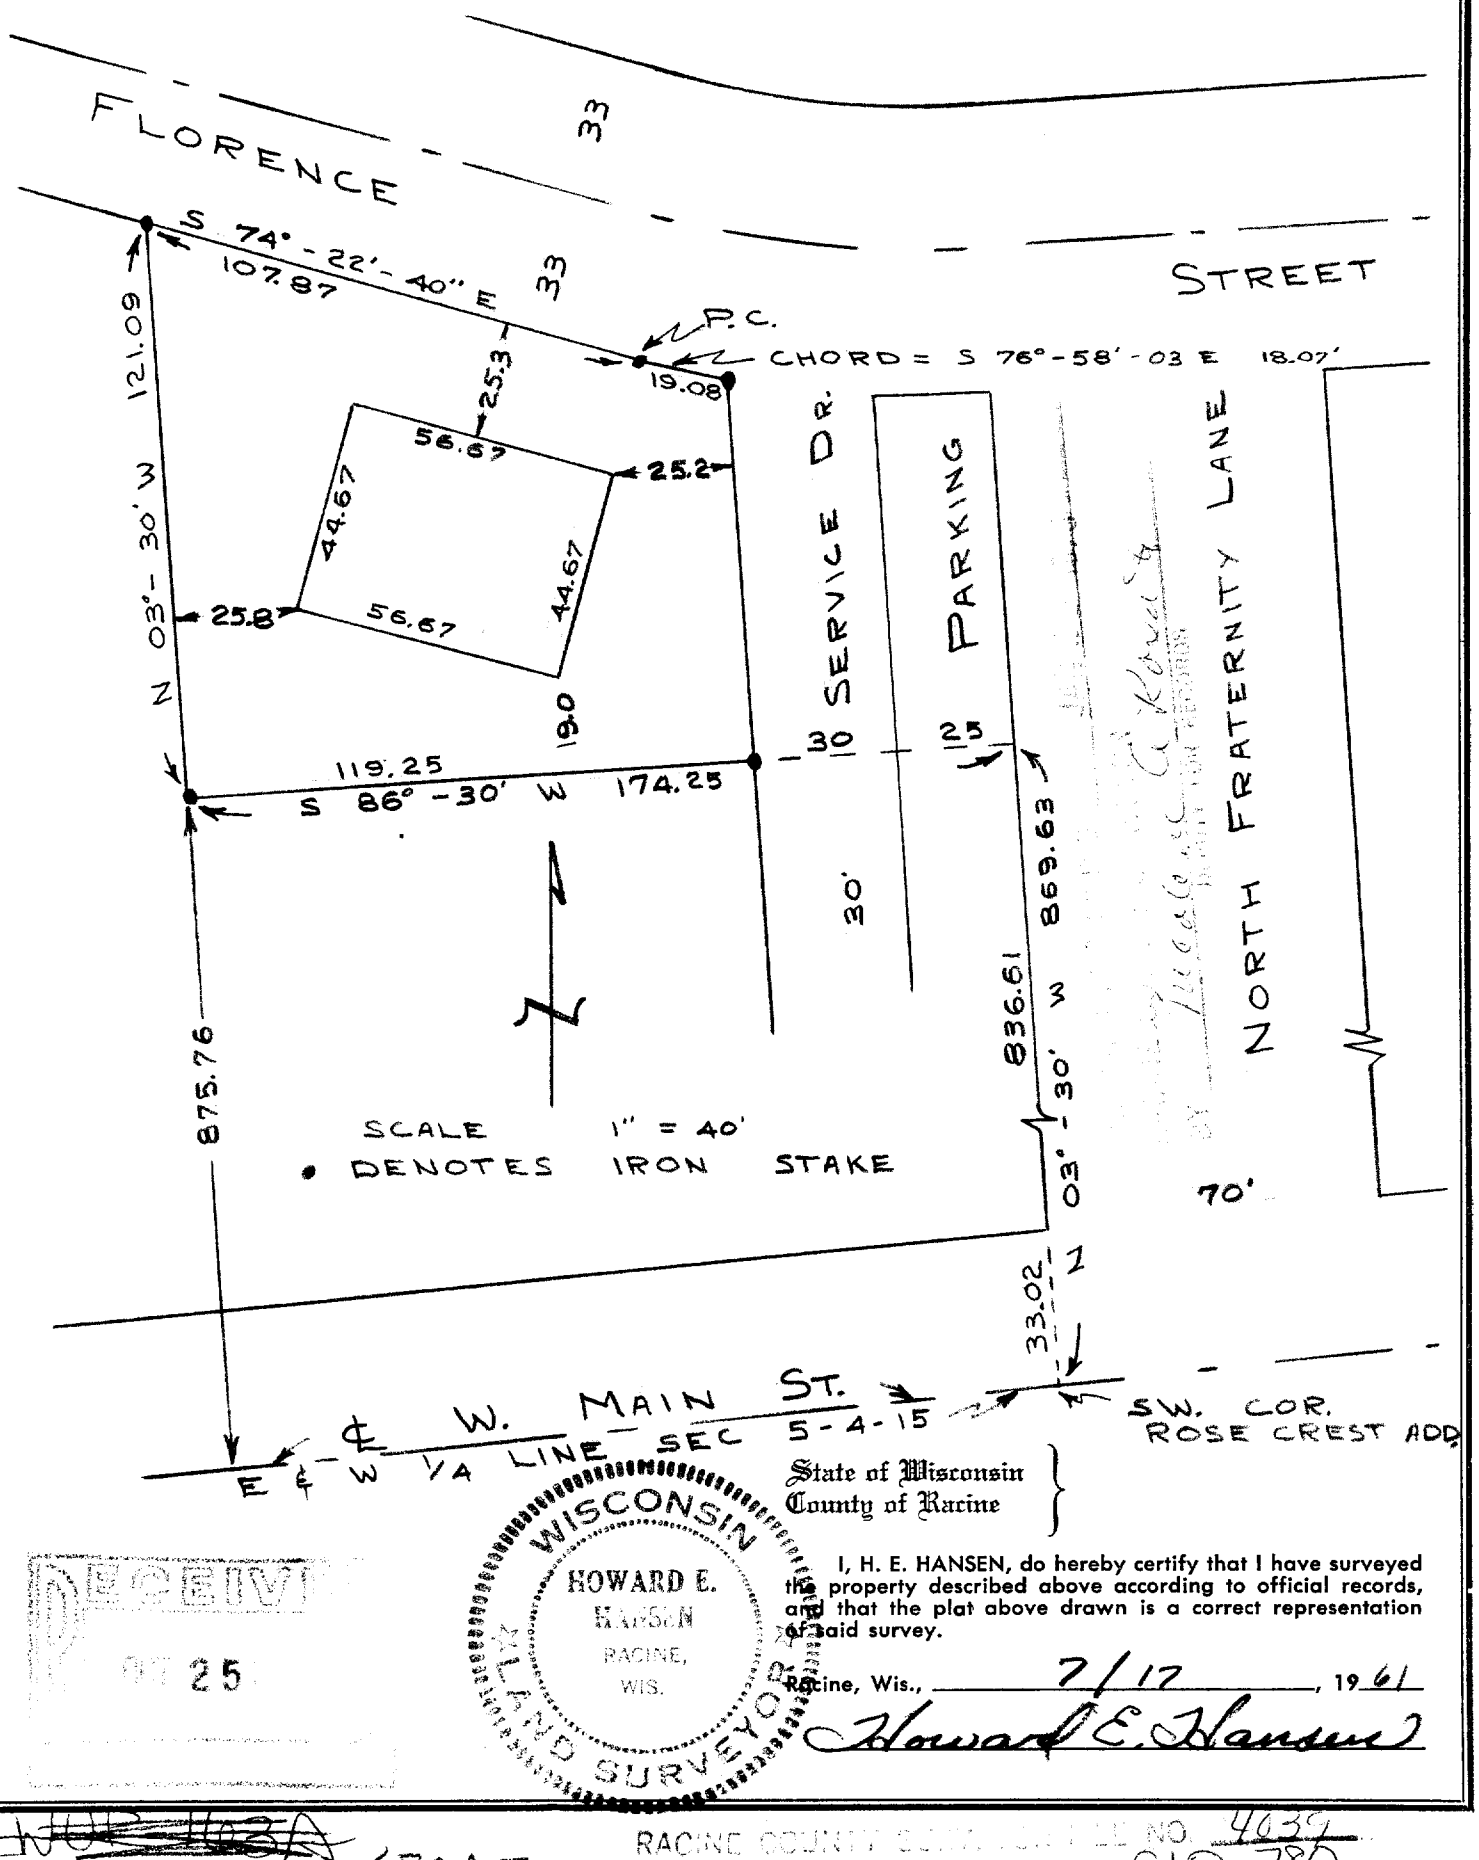

State of Wisconsin
County of Racine

I, H. E. HANSEN, do hereby certify that I have surveyed the property described above according to official records, and that the plat above drawn is a correct representation of said survey.

Racine, Wis., 7/17, 19 61

Howard E. Hansen

WISCONSIN HOWARD E. HANSEN RACINE, WIS. LAND SURVEYOR

RECEIVED OCT 25

HUR 1163A

RCA-7

RACINE COUNTY CLERK'S FILE NO. 4039

CIO-780