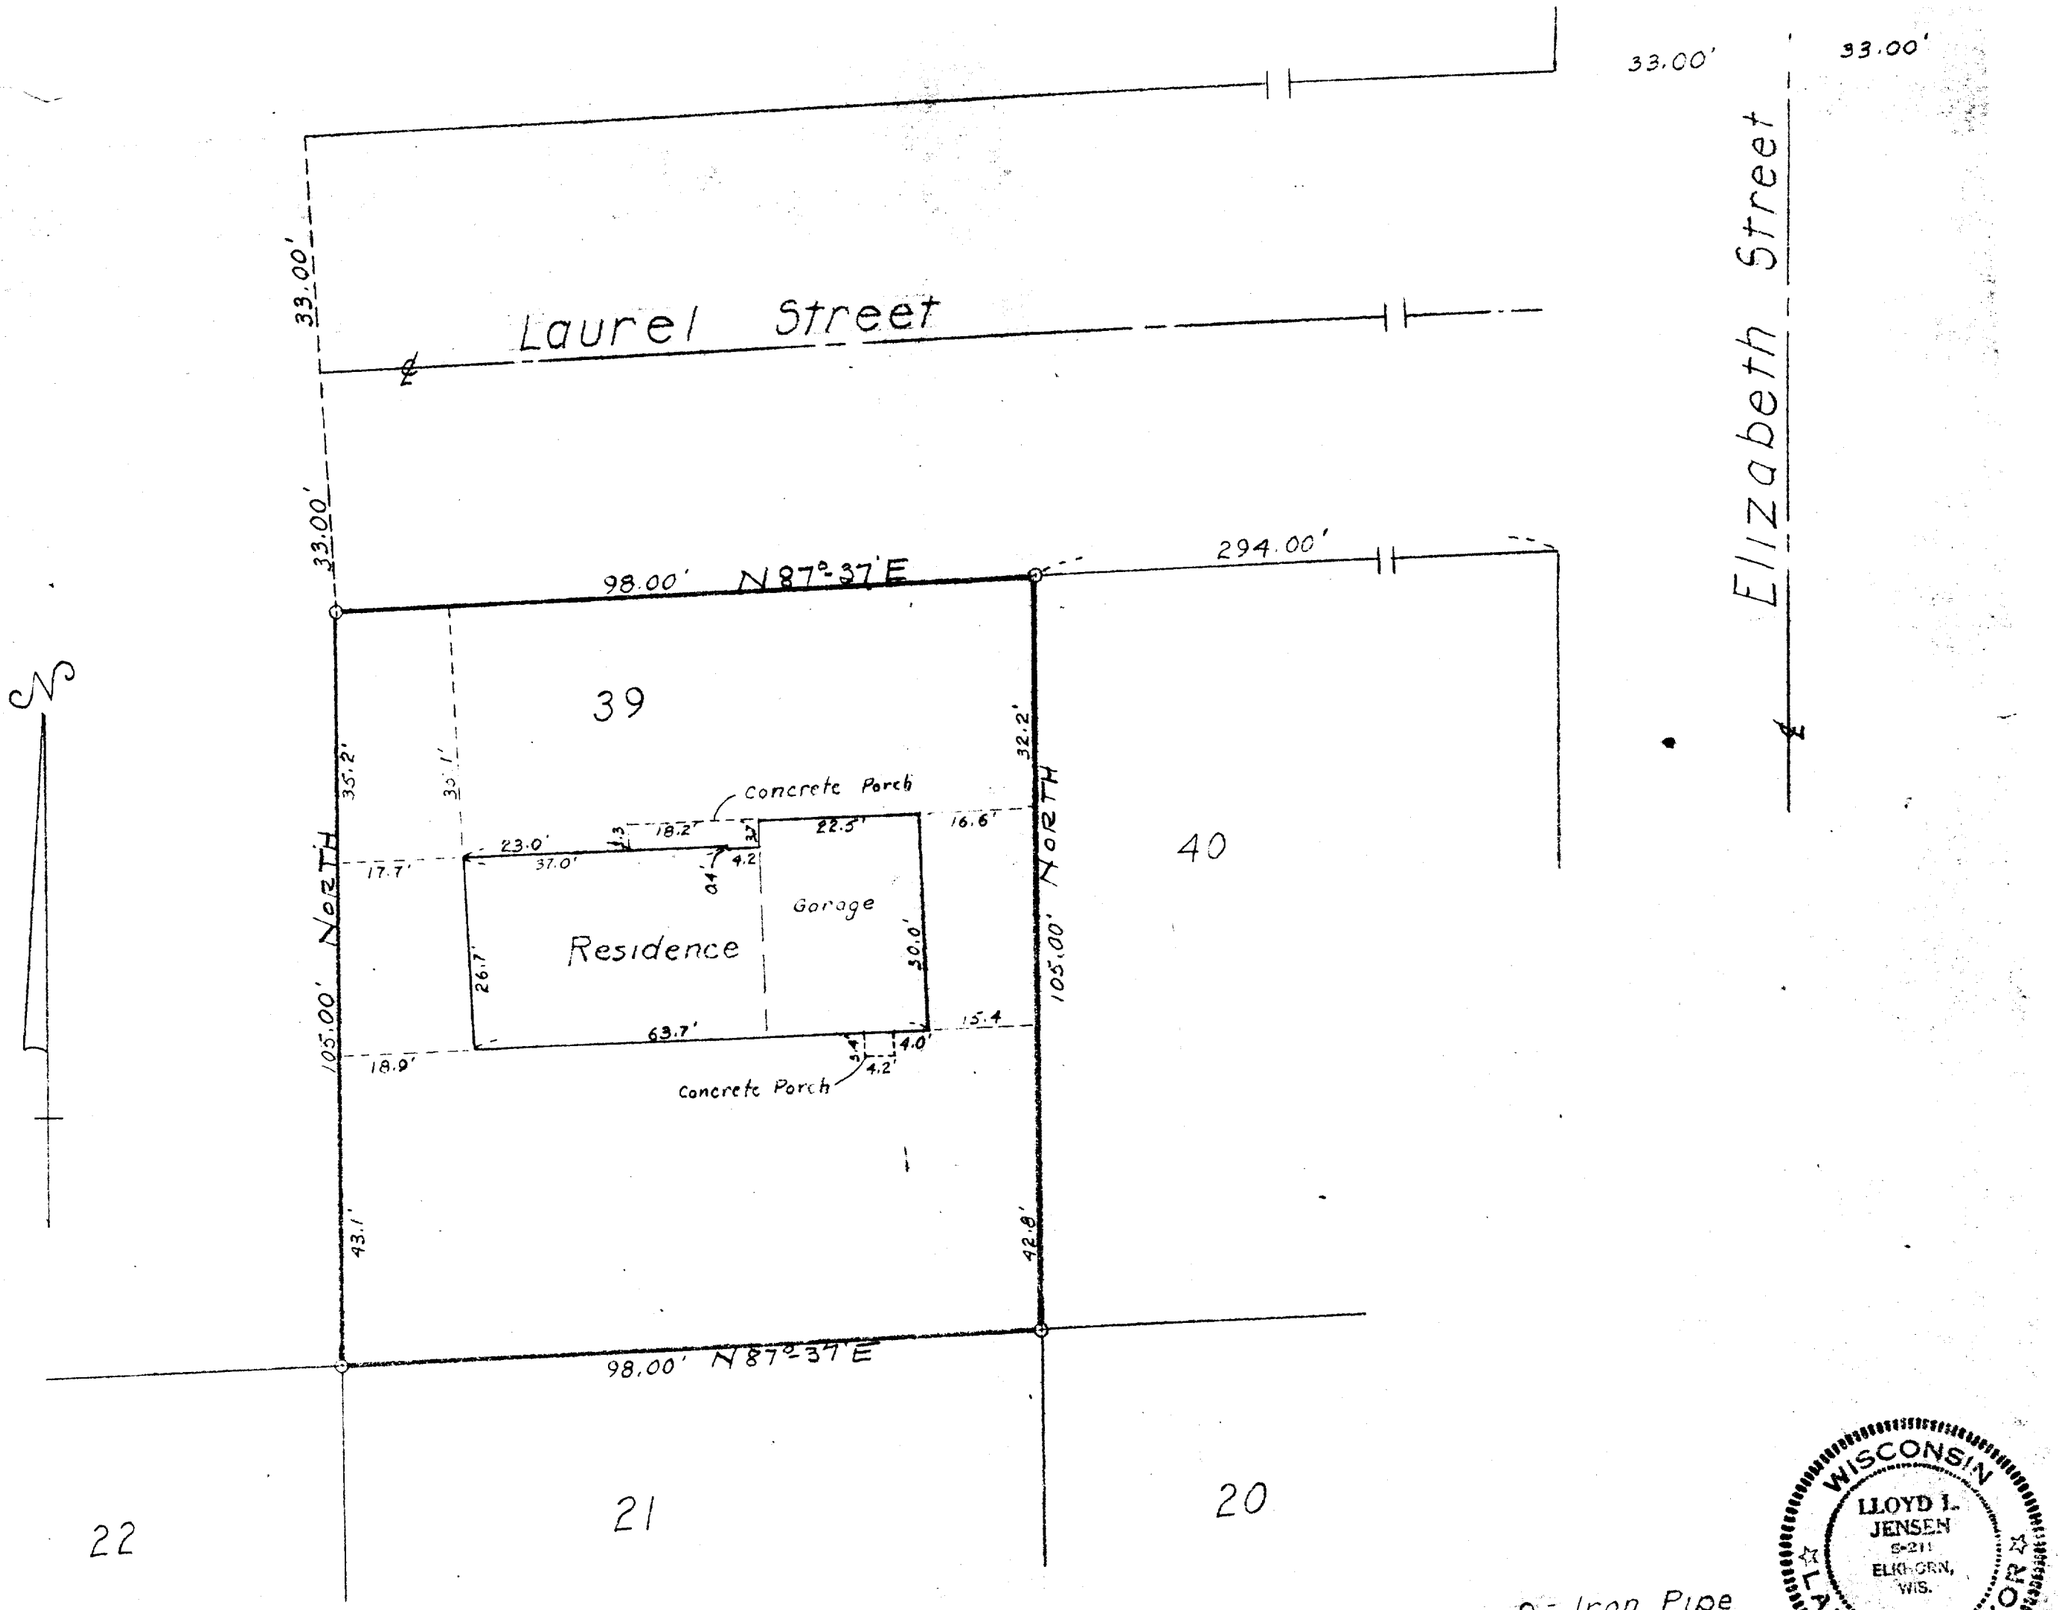


o - Iron Pipe

WISCONSIN
LLOYD L. JENSEN
S-211
ELKHORN, WIS.
LAND SURVEYOR

State of Wisconsin
County of Walworth

I, Lloyd L. Jensen, do hereby certify that I have surveyed the property hereon described according to the official records, and that the plat hereon is a correct representation of the lot lines and principal lines of the buildings thereon.

Lloyd L Jensen
Surveyor

March 1957

PLAT OF SURVEY
OF
Lot 39 of Westpark Addition
City of Whitewater,
Walworth County, Wisconsin

Lloyd L Jensen
SURVEYOR

SCALE 1" = 20 10-93 DATE March 1957