
KOLB LAND CONSULTING, INC.

LAND SURVEYING · SUBDIVIDING · LAND PLANNING

929 WILLIAMS STREET LAKE GENEVA, WISCONSIN 53147 414-248-3697

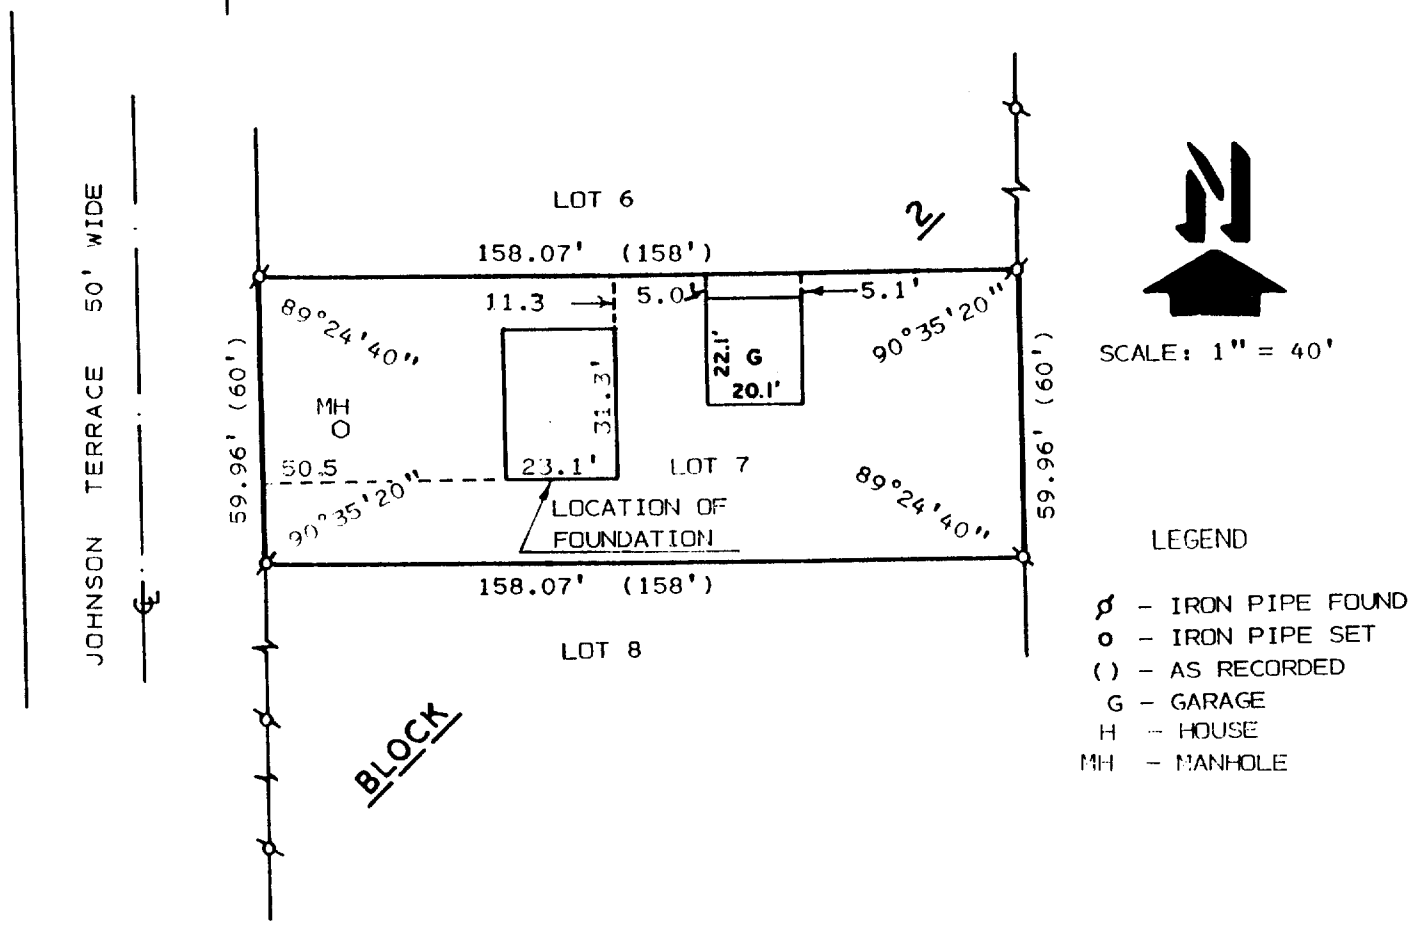

PLAT OF SURVEY OF

LOT 7, BLOCK 2 OF HARBOUR VIEW SUBDIVISION
LOCATED IN THE VILLAGE OF WILLIAMS BAY,
WALWORTH COUNTY, WISCONSIN.

NOTE: CONCRETE MANHOLE FOUND ON PREVIOUS SURVEY APPEARS TO BE COVERED WITH FROZEN FILL AND STATUS CAN'T BE DETERMINED.

ORDERED BY: SCHAUDER BUILDERS
115 N. U.S. HWY. 51
JANESVILLE, WIS. 53445

RECEIVED
NOV

I, HAROLD H. KOLB, DO HEREBY CERTIFY THAT I HAVE SURVEYED THE PROPERTY HEREON DESCRIBED ACCORDING TO THE OFFICIAL RECORDS AND THAT THE PLAT HEREON IS A CORRECT REPRESENTATION OF THE LOT LINES TO THE BEST OF MY KNOWLEDGE AND BELIEF.
SURVEY NOT VALID UNLESS SURVEYOR'S SIGNATURE IS IN RED.

HAROLD H. KOLB

WISCONSIN REGISTERED LAND SURVEYOR, S-187

DATE SEPTEMBER 24, 1991

REVISED FEBRUARY 18, 1993

REVISED

WMB-WHV-21

WHV-21

11-1069