ABERNATHY and ASSOCIATES
Kenneth B. Abernathy Jr.
Wisconsin Registered Land Surveyor S-1594

W4056 Bray Road
Elkhorn, Wisconsin 53121
Phone: (414) 723-4260 (office)
(414) 723-4813 (residence)

PLAT OF SURVEY

Lot 15 of Summer Haven Subdivision, located in part of the Southeast 1/4 of Section 1, Town 1 North, Range 16 East, Village of Williams Bay, Walworth County, Wisconsin.

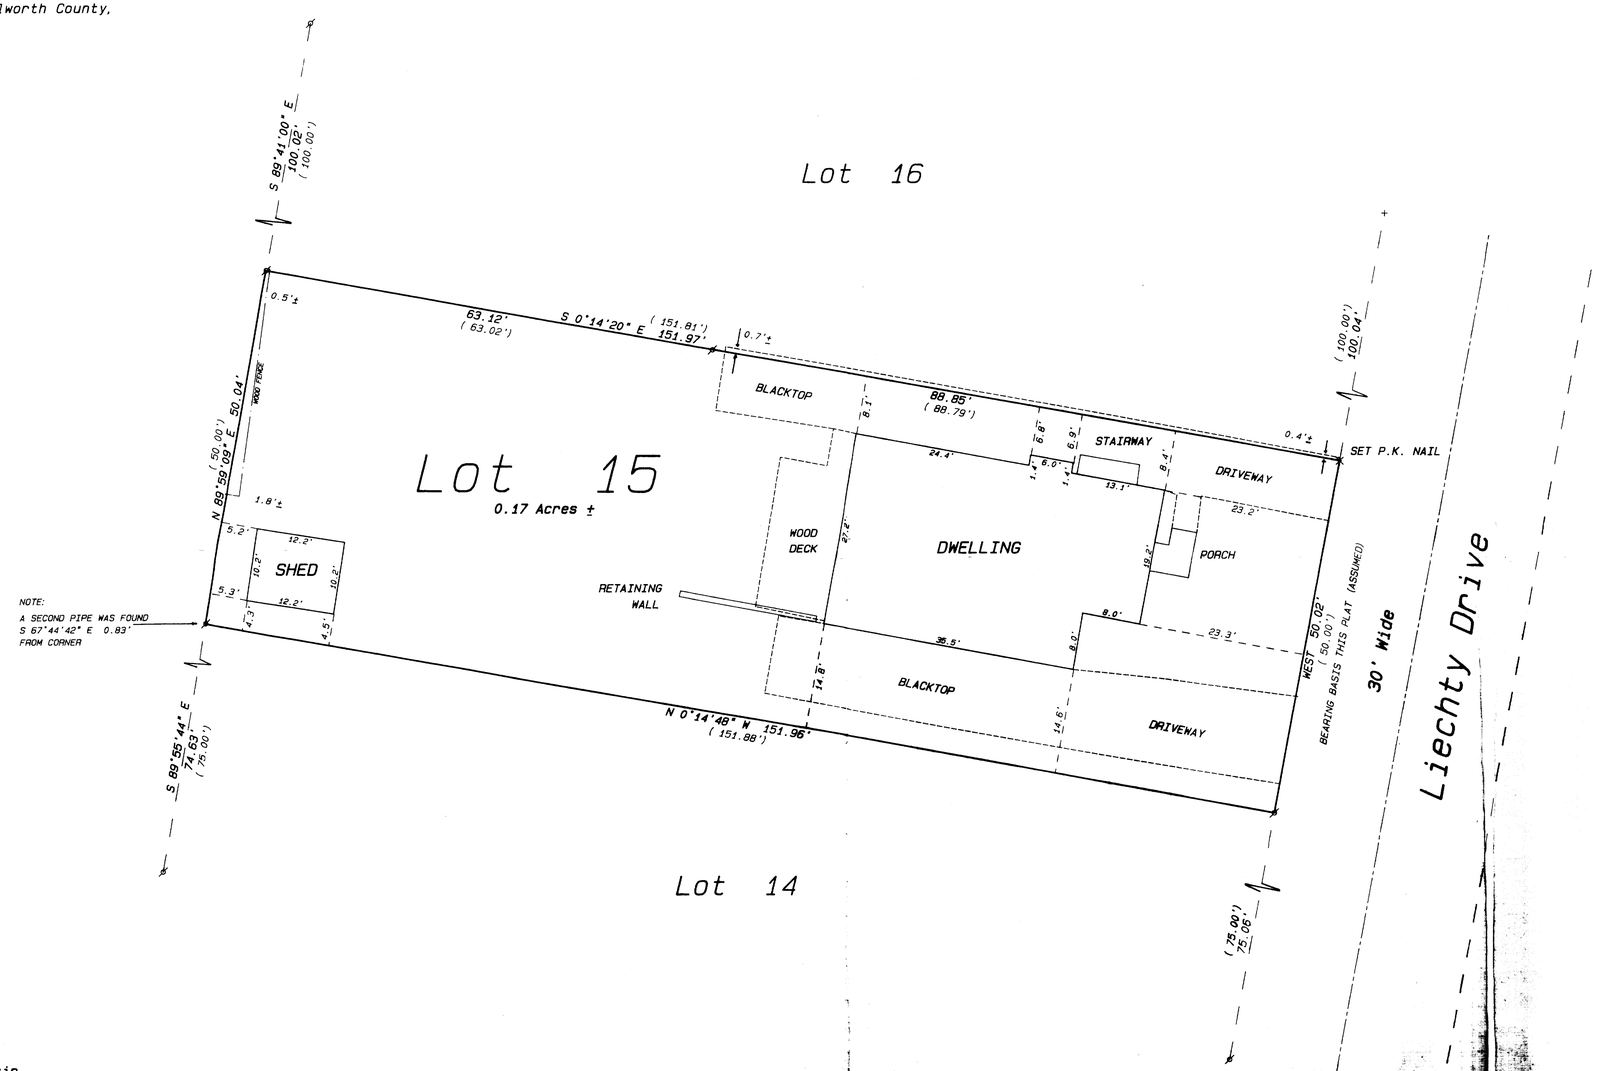

Owner: Elizabeth Schneider
50 Liechty Drive
Williams Bay, Wisconsin
53191

Ordered by: Kari Sue Clark
Office Manager
Home Design Manufacturing
Post Office Box 527
Fontana, Wisconsin
53125

RECEIVED
MAR 21 1996

Legend

- FOUND IRON PIPE
- FOUND IRON ROD
- FOUND BRASS CAPPED MONUMENT
- FOUND CONCRETE MONUMENT
- CHISEL CUT IN CONCRETE
- SET IRON ROD, 24" LONG, WEIGHING 1.5 LBS./LINEAL FT., 3/8" DIA.
- SET IRON ROD, 30" LONG, WEIGHING 4.3 LBS./LINEAL FT., 1-11/16" DIA.
- (xx) RECORDED AS DIMENSION
- EXISTING FENCE

SCALE: 1" = 10 FEET

"I hereby certify that the above-described property has been surveyed by me or under my direction and that the above map is a true representation thereof and shows the size and location of the property, its exterior boundaries, the location of all visible structures and dimensions of all principal buildings thereon, boundary fences, apparent easements, roadways and visible encroachments, if any."

"This survey is made for the use of the present owner of the property, and also those who purchase, mortgage, or guarantee the title within one year from date hereof."

WISCONSIN KENNETH B. ABERNATHY, JR. S-1594 WAUKESHA, WI LAND SURVEYOR

KENNETH B. ABERNATHY, JR.
WISCONSIN REGISTERED LAND SURVEYOR
S-1594

Date: March 5, 1996 Job No. 1085.217

WSU-18
11-1136

DESIGN PRODUCTS 07731