
HAROLD H. KOLB

REGISTERED PROFESSIONAL LAND SURVEYOR
LAKE GENEVA, WISCONSIN

PLAT OF SURVEY OF

Lot 134, Second Addition to Cedar Point Park, Village of Williams Bay, Walworth County Wisconsin.

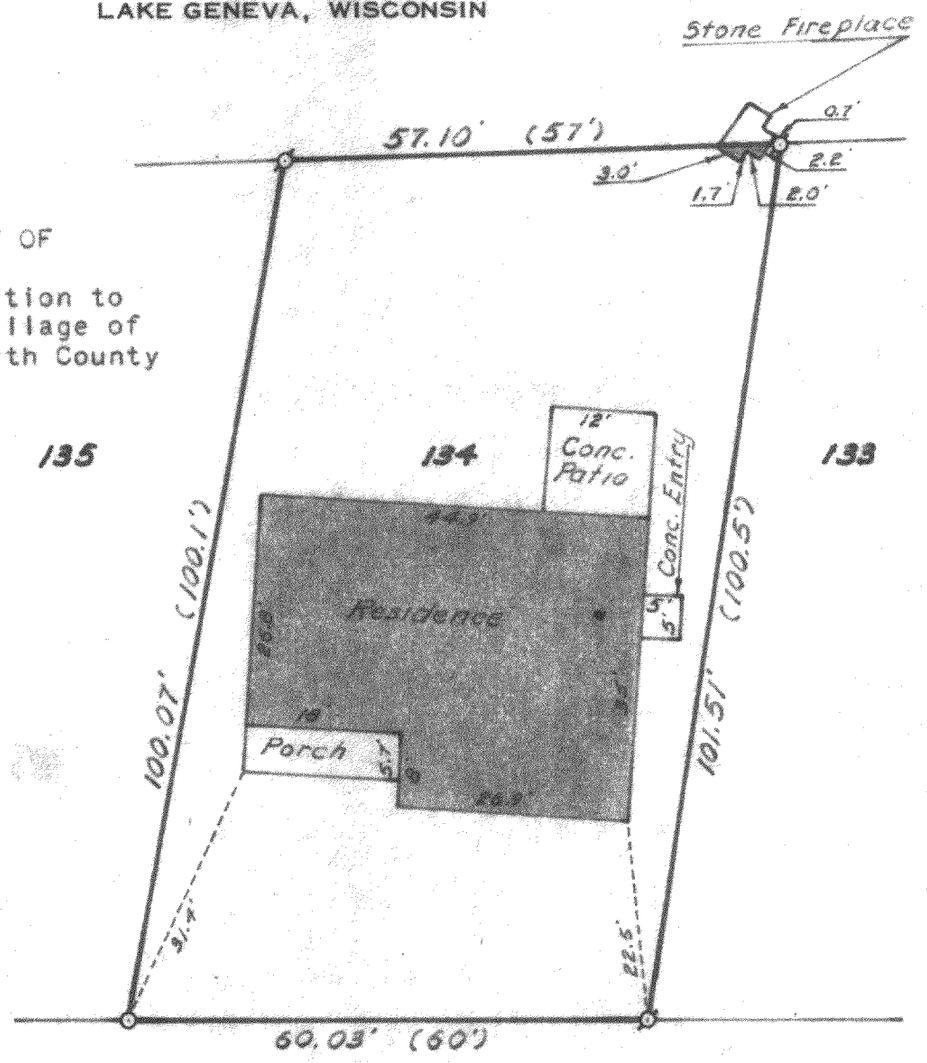

N

SCALE: 1" = 20'

LEGEND

- ⌀ — IRON PIPE FOUND
- ○ — IRON PIPE PLACED
- ● — CONCRETE MONUMENT
- x — SPIKE
- ( )—Recorded distance

I, HAROLD H. KOLB, DO HEREBY CERTIFY THAT I HAVE SURVEYED THE PROPERTY HEREON DESCRIBED ACCORDING TO THE OFFICIAL RECORDS, AND THAT THE PLAT HEREON IS A CORRECT REPRESENTATION OF THE LOT LINES, and the principle lines of the buildings thereon.

Harold H. Kolb

HAROLD H. KOLB
WISCONSIN REGISTERED LAND SURVEYOR, S—187
DATE May 8, 1967

Lot P2-33

11-125