
Services Offered
Commercial Site Development
Subdivision Design and Platting
Planning and Plan Review
Streets and Highway Design
Drainage Studies
Water Distribution Systems
Sewer Collection Systems
Construction Surveying and Stake-out Services
GPS Surveying
Certified Soil Testing

Nienow Engineering Assoc.
Consulting Engineers and Surveyors
229 E. Main Street
Waterford, WI 53185
(414) 534-9190 Fax (414) 534-9192

962997
962997S1.DWG

PLAT OF SURVEY

LOT 6, BLOCK 3 OF LAKEWOOD TRAILS, BEING A SUBDIVISION LOCATED IN THE NORTHEAST 1/4 & NORTHWEST 1/4 OF THE NORTHWEST 1/4 OF SECTION 1, TOWN 1 NORTH, RANGE 16 EAST, VILLAGE OF WILLIAMS BAY, WALWORTH COUNTY, WISCONSIN

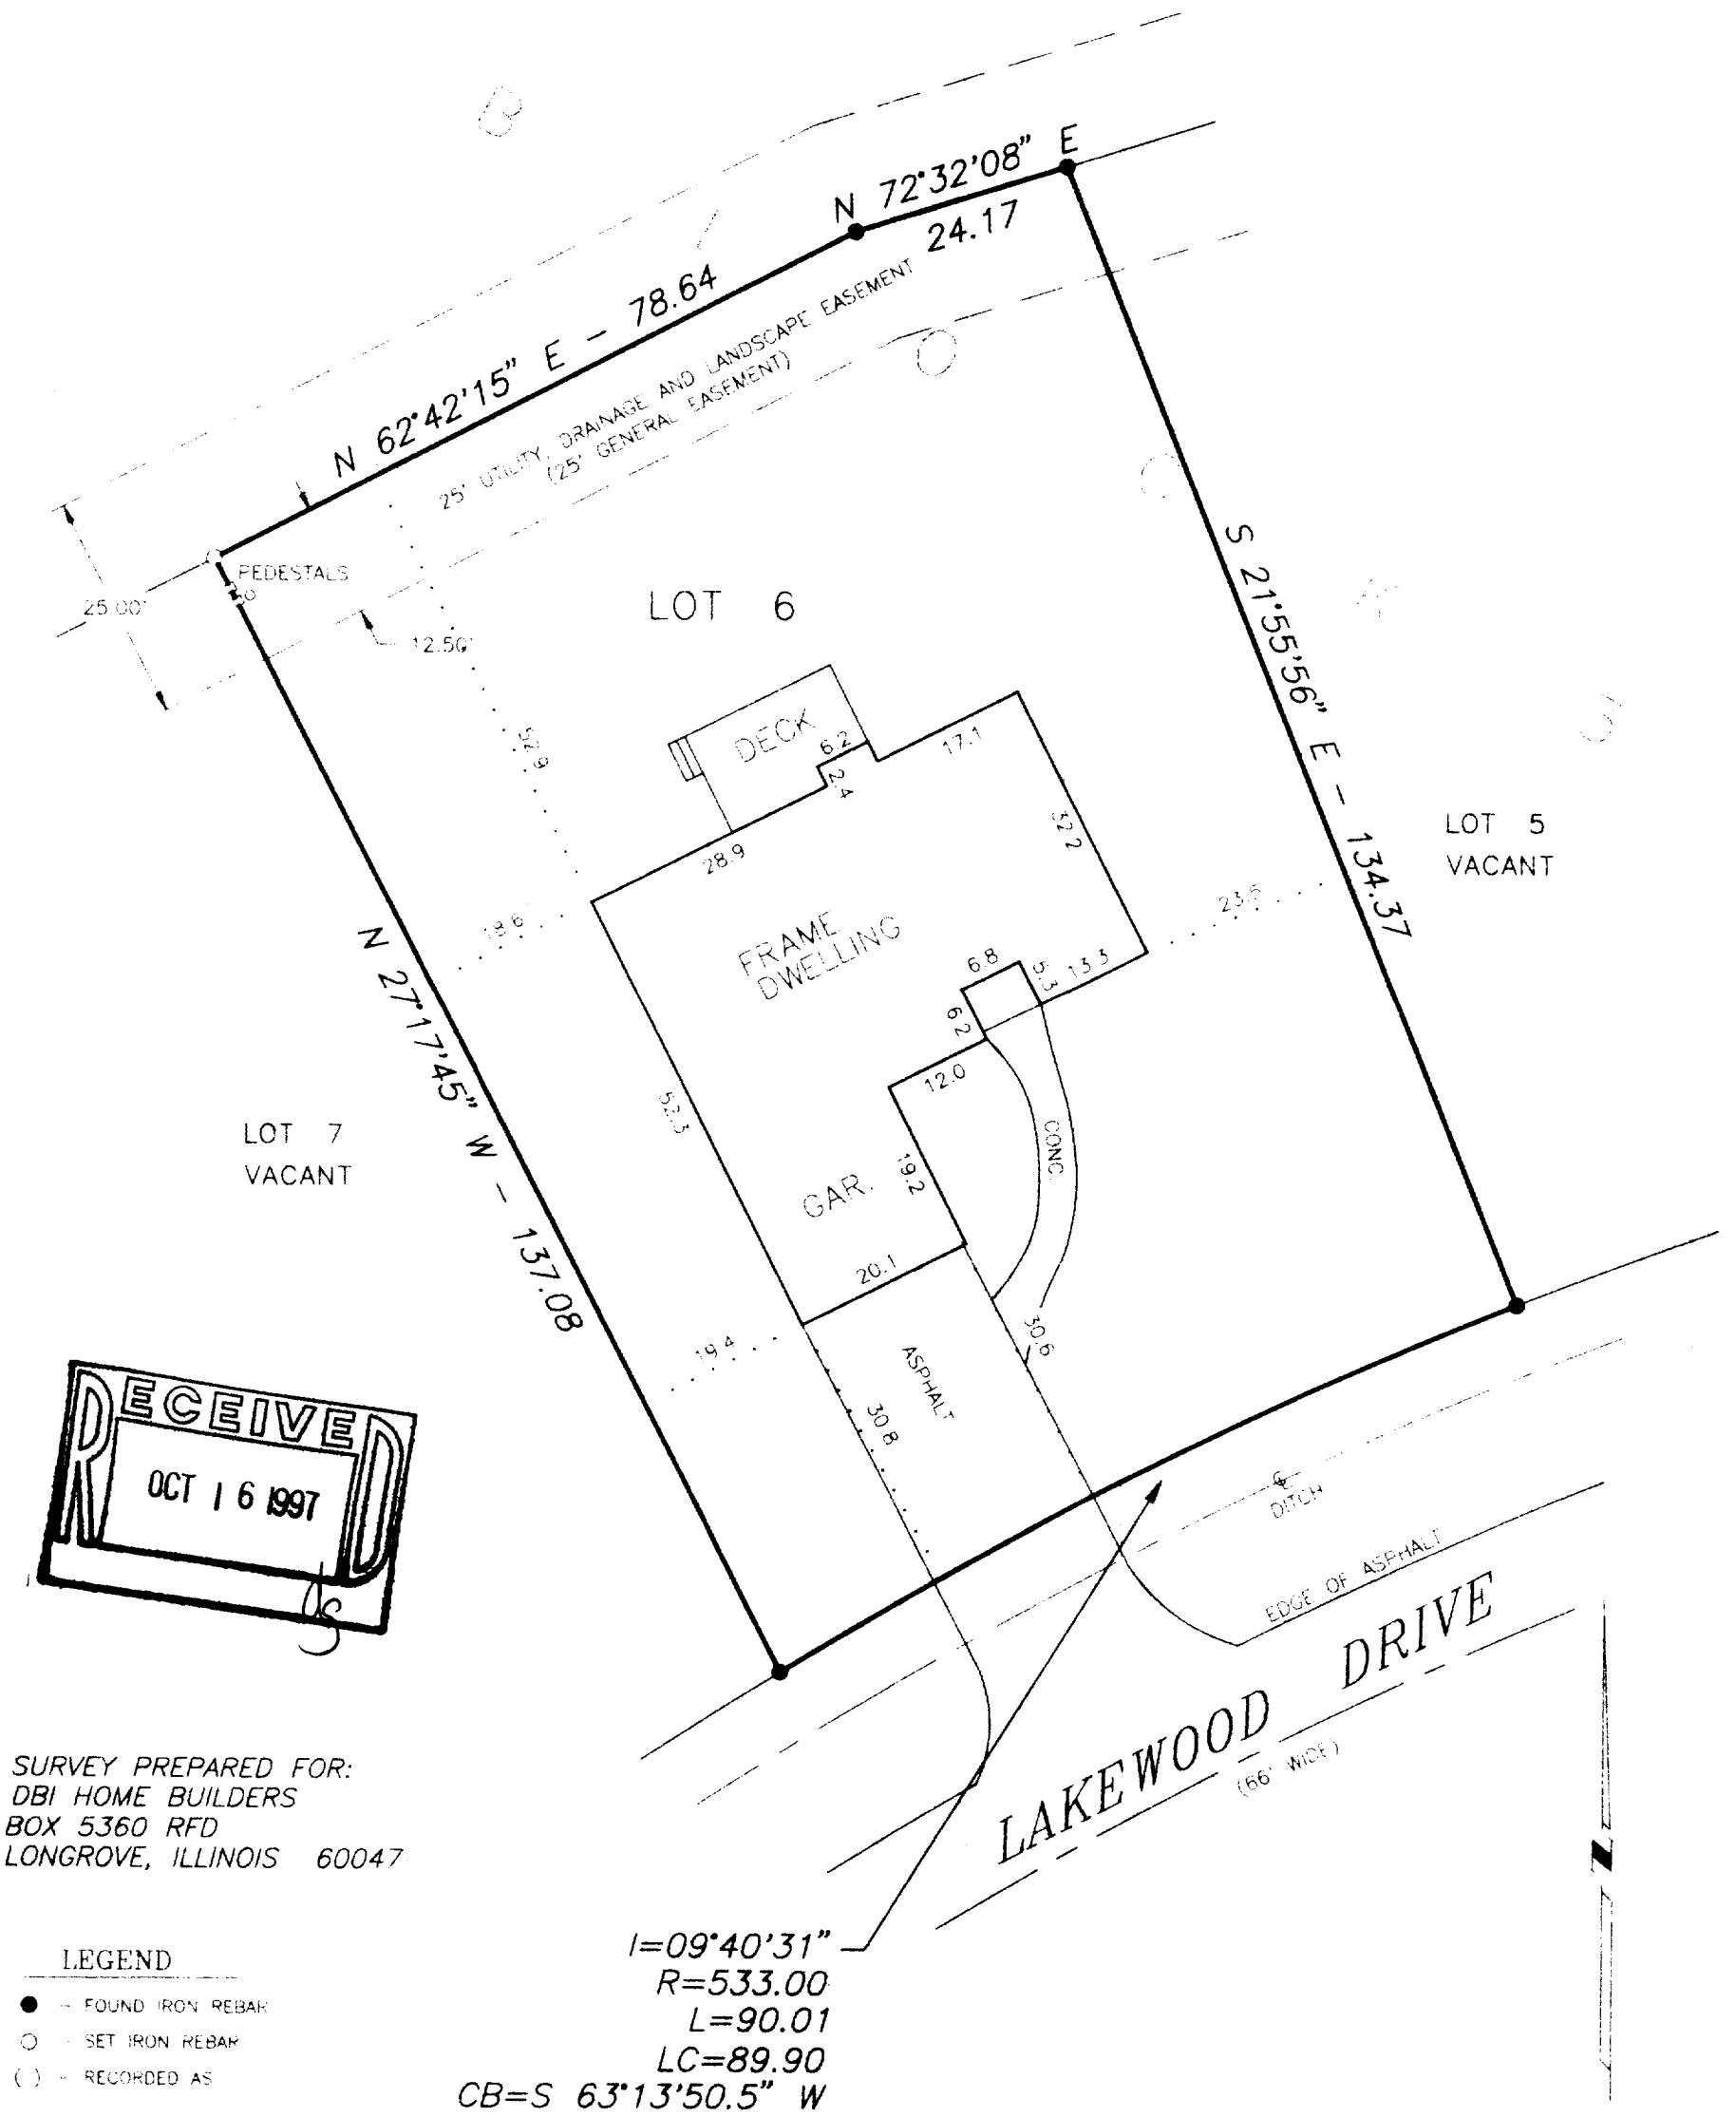

RECEIVED
OCT 16 1997

SURVEY PREPARED FOR:
DBI HOME BUILDERS
BOX 5360 RFD
LONGROVE, ILLINOIS 60047

LEGEND
● - FOUND IRON REBAR
○ - SET IRON REBAR
( ) - RECORDED AS

SCALE: 1" = 20'
BEARINGS BASE AS RECORDED AS.

WISCONSIN
GARY B. FOAT
S-1598
Waterford, Wis.
LAND SURVEYOR

STATE OF WISCONSIN)
RACINE COUNTY)

I HEREBY CERTIFY THAT I HAVE SURVEYED THE ABOVE DESCRIBED PROPERTY AND THE ABOVE MAP IS A TRUE REPRESENTATION THEREOF AND SHOWS THE SIZE AND LOCATION OF THE PROPERTY, THE LOCATION OF ALL VISIBLE STRUCTURES AND DIMENSIONS OF ALL PRINCIPAL BUILDINGS THEREON, BOUNDARY FENCES, APPARENT EASEMENTS, ROADWAY AND VISIBLE ENCROACHMENTS, IF ANY.

THIS SURVEY IS MADE FOR THE PRESENT OWNERS OF THE PROPERTY, AND ALSO THOSE WHO PURCHASE, OR GUARANTEE THE TITLE THERETO WITHIN (1) YEAR FROM THE DATE HEREOF.

DATED AT WATERFORD THIS 7TH DAY OF OCTOBER, 19 96

RECERTIFIED July 21, 1997

Gary B. Foat

N28961

WLAK-37
011-1256