FARRIS, HANSEN & ASSOCIATES, INC.


ENGINEERING, ARCHITECTURE, SURVEYING

7 RIDGEWAY COURT – P.O. BOX 437, ELKHORN, WISCONSIN, 53121

PHONE: (414) 723–2098 FAX: (414) 723–5886

PLAT OF SURVEY

LOTS 45 & 46 OF LOCKWOODS SUBDIVISION
LOCATED IN THE VILLAGE OF WILLIAMS BAY
WALWORTH COUNTY, WISCONSIN

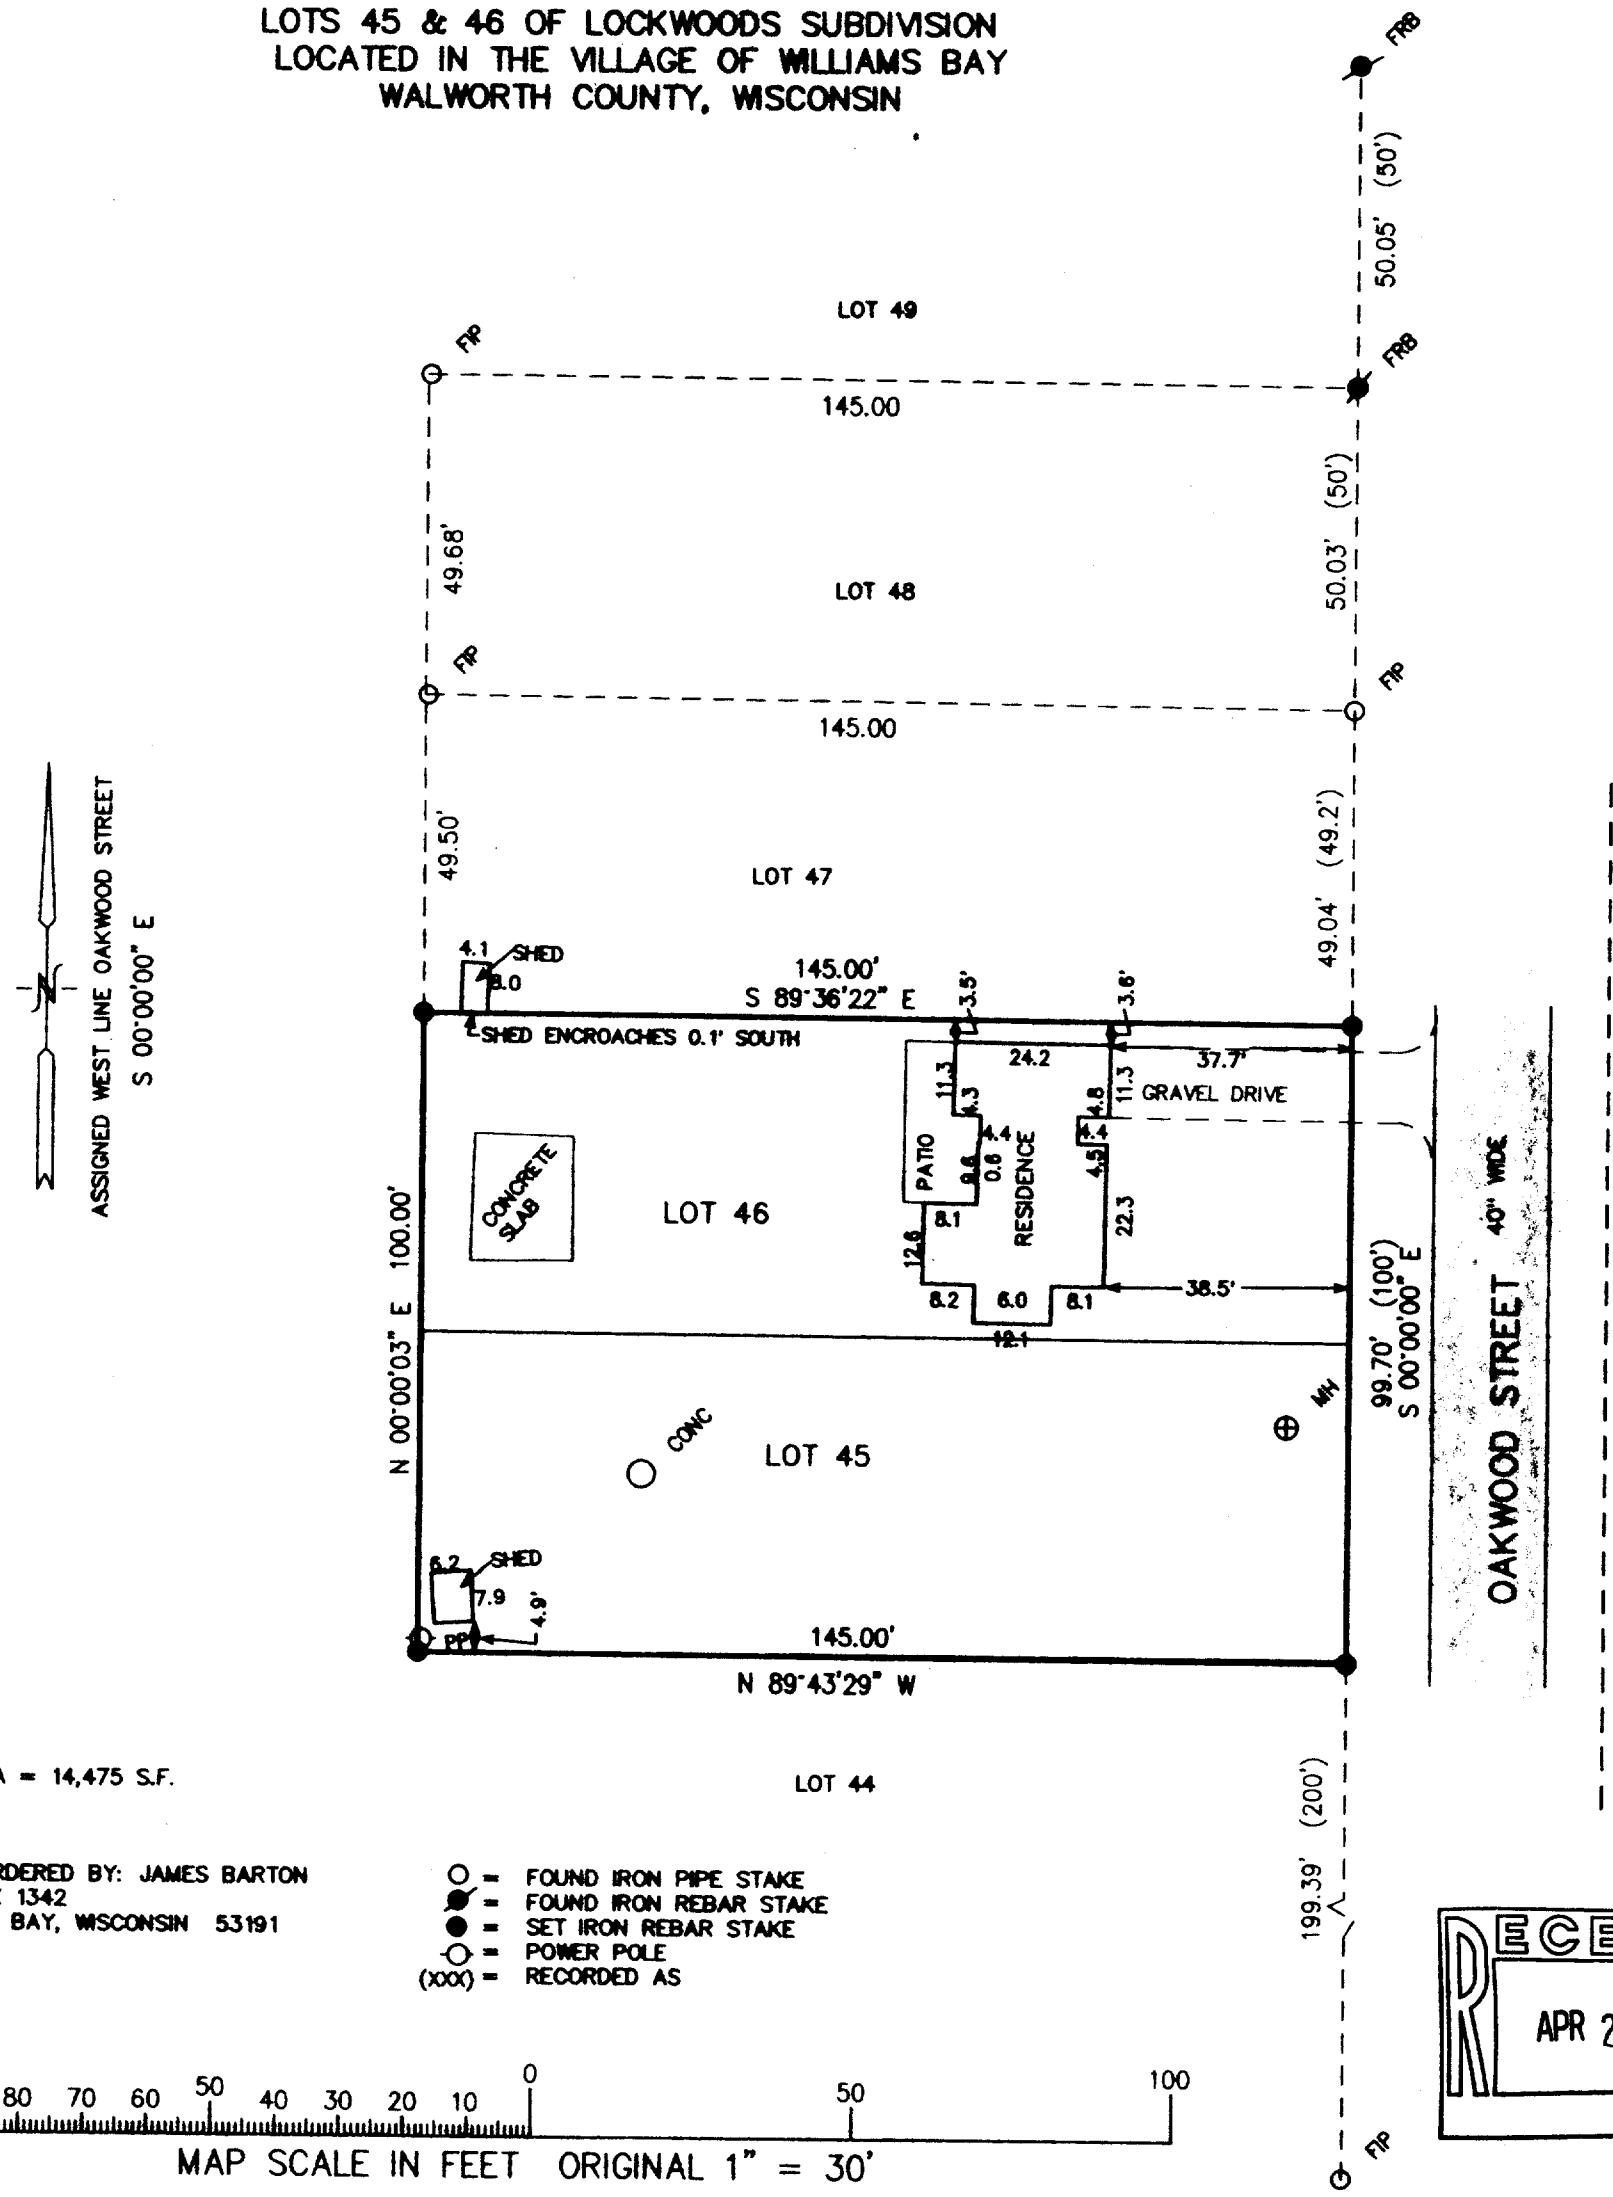

NET AREA = 14,475 S.F.

WORK ORDERED BY: JAMES BARTON
P.O. BOX 1342
WILLIAMS BAY, WISCONSIN 53191

- ○ = FOUND IRON PIPE STAKE
- ◐ = FOUND IRON REBAR STAKE
- ● = SET IRON REBAR STAKE
- -○- = POWER POLE
- (xxx) = RECORDED AS

100 90 80 70 60 50 40 30 20 10 0 50 100

MAP SCALE IN FEET ORIGINAL 1" = 30'

RECEIVED
APR 24 1998

NOTE: COPIES OF THIS MAP TO WHICH THE FOLLOWING CERTIFICATE WILL APPLY ARE BLUE LINE PRINTS SHOWING SURVEYOR'S ORIGINAL SEAL AND SIGNATURE IN BLACK INK. COPIES BY ANY OTHER MEANS MAY HAVE ALTERATIONS WHICH DO NOT REPRESENT THE SURVEYOR'S WORK PRODUCT.

I HEREBY CERTIFY THAT THE ABOVE DESCRIBED PROPERTY HAS BEEN SURVEYED UNDER MY DIRECTION AND THAT THE ABOVE MAP IS A TRUE REPRESENTATION THEREOF AND SHOWS THE SIZE AND LOCATION OF THE PROPERTY AND ITS EXTERIOR BOUNDARIES. THIS SURVEY IS MADE FOR THE USE OF THE PRESENT OWNERS OF THE PROPERTY, AND ALSO THOSE WHO PURCHASE, MORTGAGE, OR GUARANTEE THE TITLE THERETO WITHIN ONE YEAR FROM THE DATE HEREOF.

DATED: 3/27/98

PETER S. GORDON R.L.S. 2101

WISCONSIN
PETER S. GORDON
S-2101
ELKHORN, WI
LAND SURVEYOR

PROJECT 4965

SHEET 1 OF 1

JLW3-33
11-1294