PLAT OF SURVEY

PATHFINDER SURVEYING
FORMERLY KOLB LAND CONSULTING
929 WILLIAMS STREET LAKE GENEVA, WI. 53147
(414) 248-3697


DATE: 4-15-1998

ORDERED BY:

JUDITH HIRSCH
148 BIRCH WALNUT
WILLIAMS BAY , WI. 53191

DESCRIPTON:

LOTS 40 AND 41 OF CEDAR POINT PARK 1ST ADDITION LOCATED IN SECTION 6, T 1 N , R 17 E. , VILLAGE OF WILLIAMS BAY , WALWORTH COUNTY , WISCONSIN.

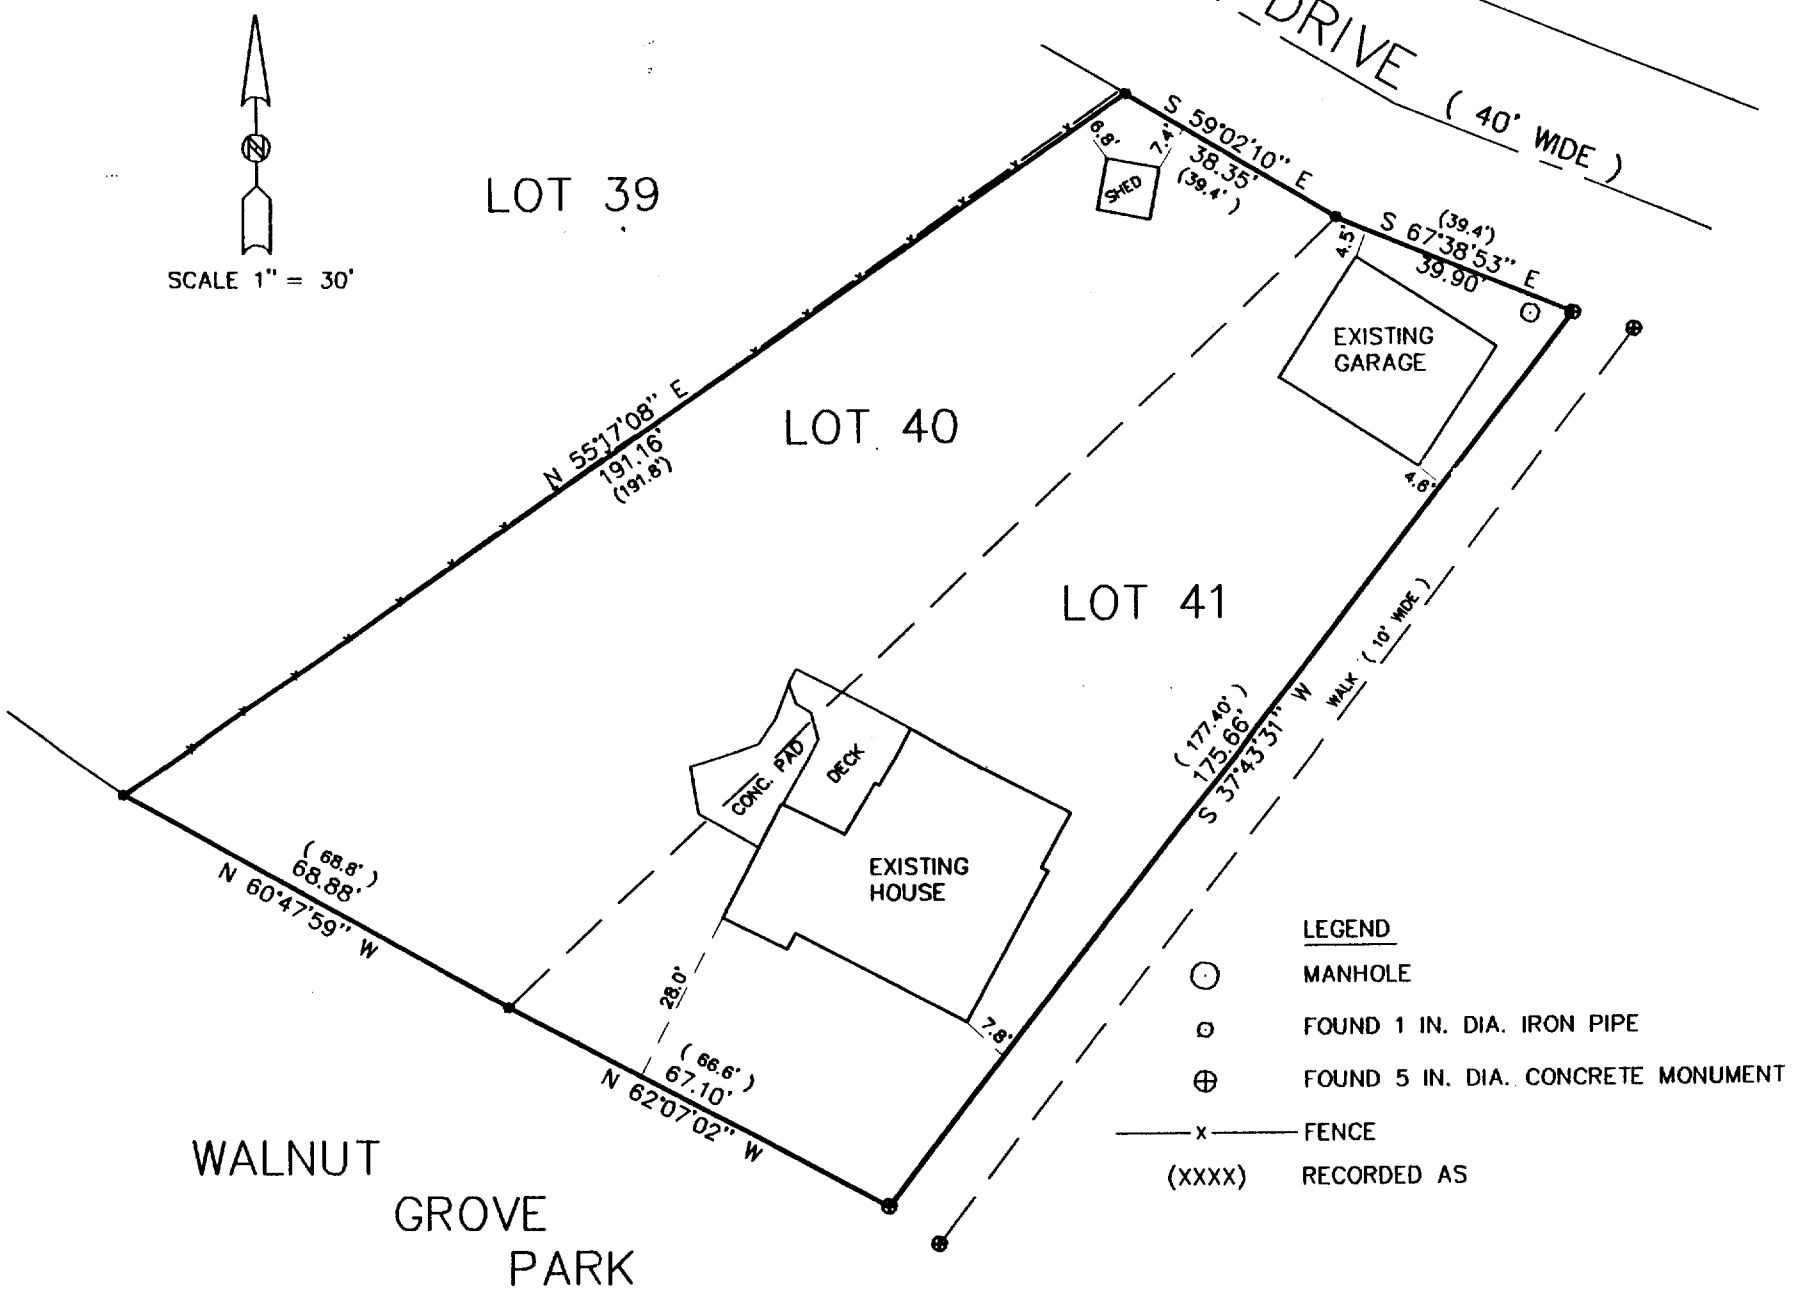

BEARINGS REFERENCED TO PREVIOUS SURVEY OF RECORD

THE ABOVE MAP IS A TRUE REPRESENTATION THEREOF AND SHOWS THE SIZE AND LOCATION OF ALL THE PROPERTY, EXTERIOR BOUNDARIES, THE LOCATION OF ALL VISIBLE BOUNDARY FENCES , APPARENT EASEMENTS , ROADWAYS AND VISIBLE ENCROACHMENTS , IF ANY

THIS SURVEY IS MADE FOR THE USE OF THE PRESENT OWNERS OF THE PROPERTY , AND ALSO THOSE WHO PURCHASE , MORTGAGE OR GURANTEE TITLE THERETO WITHIN ONE (1) YEAR FROM DATE HERETO.

John P Krott

JOHN P. KROTT , R.L.S. 2258

RECEIVED
MAY 26 1998

WISCONSIN
JOHN P. KROTT
S-2258
MUKWONAGO, WIS.
LAND SURVEYOR

NOTE: THIS IS NOT A CERTIFIED COPY UNLESS SEAL IS IN RED.

JOB NUMBER: WCP100036&37 98053

WCP1-36
WCP1-37 011-1298