
#654-69

SPRING ST.

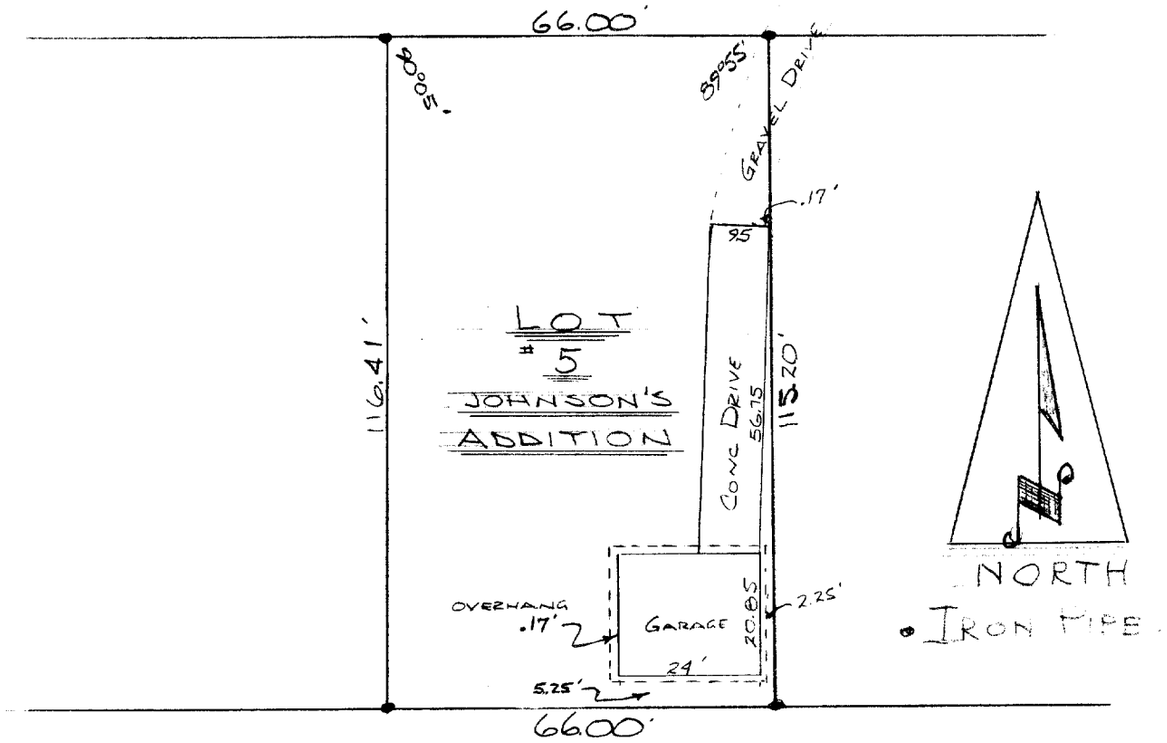


DESCRIPTION:

Lot 5, Johnson's Addition to the Village of Williams Bay, Walworth County, Wisconsin.

CERTIFICATE:

I, James F. Biagi, Surveyor do hereby certify that I have surveyed the property hereon described.

Dated August 7th 1964.

James F. Biagi. RLS 272
Elkhorn, Wisconsin.

WISCONSIN
JAMES F.
BIAGI
MILWAUKEE,
WIS.
LAND SURVEYOR

WSB-4

11-12B