
HAROLD H. KOLB
REGISTERED PROFESSIONAL LAND SURVEYOR
LAKE GENEVA, WISCONSIN

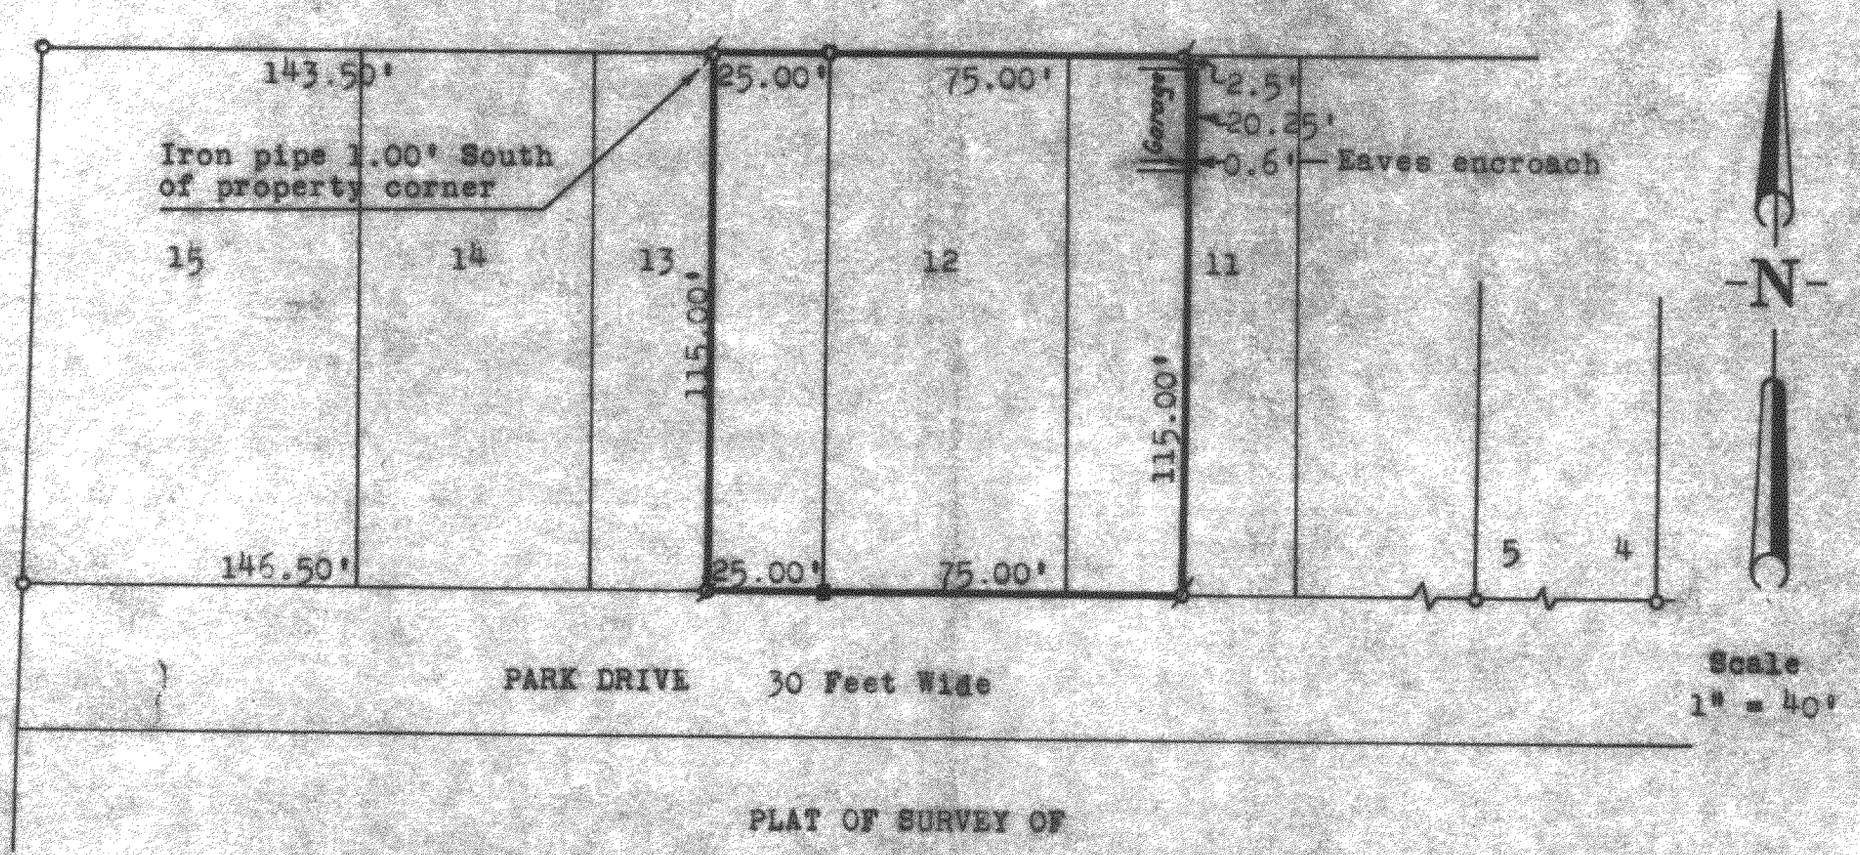

PLAT OF SURVEY OF

A parcel of land being the East 1/2 of Lot 13, all of Lot 12, and the West 1/2 of Lot 11, of Loch Vista Club Subdivision Number 1, Village of Williams Bay, Walworth County, Wisconsin.

Harold H. Kolb
Harold H. Kolb, Wisconsin Surveyor, S-187
Date: April 20,1964

- ◻ Found wood stake mark
- ■ Found wood Stake
- ○ Found iron pipe
- ⊠ Set iron pipe

WLV-10

11-133