PLAT OF SURVEY


PATHFINDER SURVEYING
FORMERLY KOLB LAND CONSULTING
929 WILLIAMS STREET LAKE GENEVA, WI. 53147
(414) 248-3697

ORDERED BY: THE RAULAND AGENCY, INC.
P.O. BOX 159
WALWORTH, WI. 53184

DATE: 4-26-1999

DESCRIPTION: LOT 4 OF BETHEL BLOCK, A SUBDIVISON LOCATED IN THE VILLAGE OF WILLIAMS BAY, WALWORTH COUNTY, WISCINSIN.

SCALE 1"=20"
BEARINGS REFERNCED TO RECORD PLAT OF BETHEL BLOCK SUB.

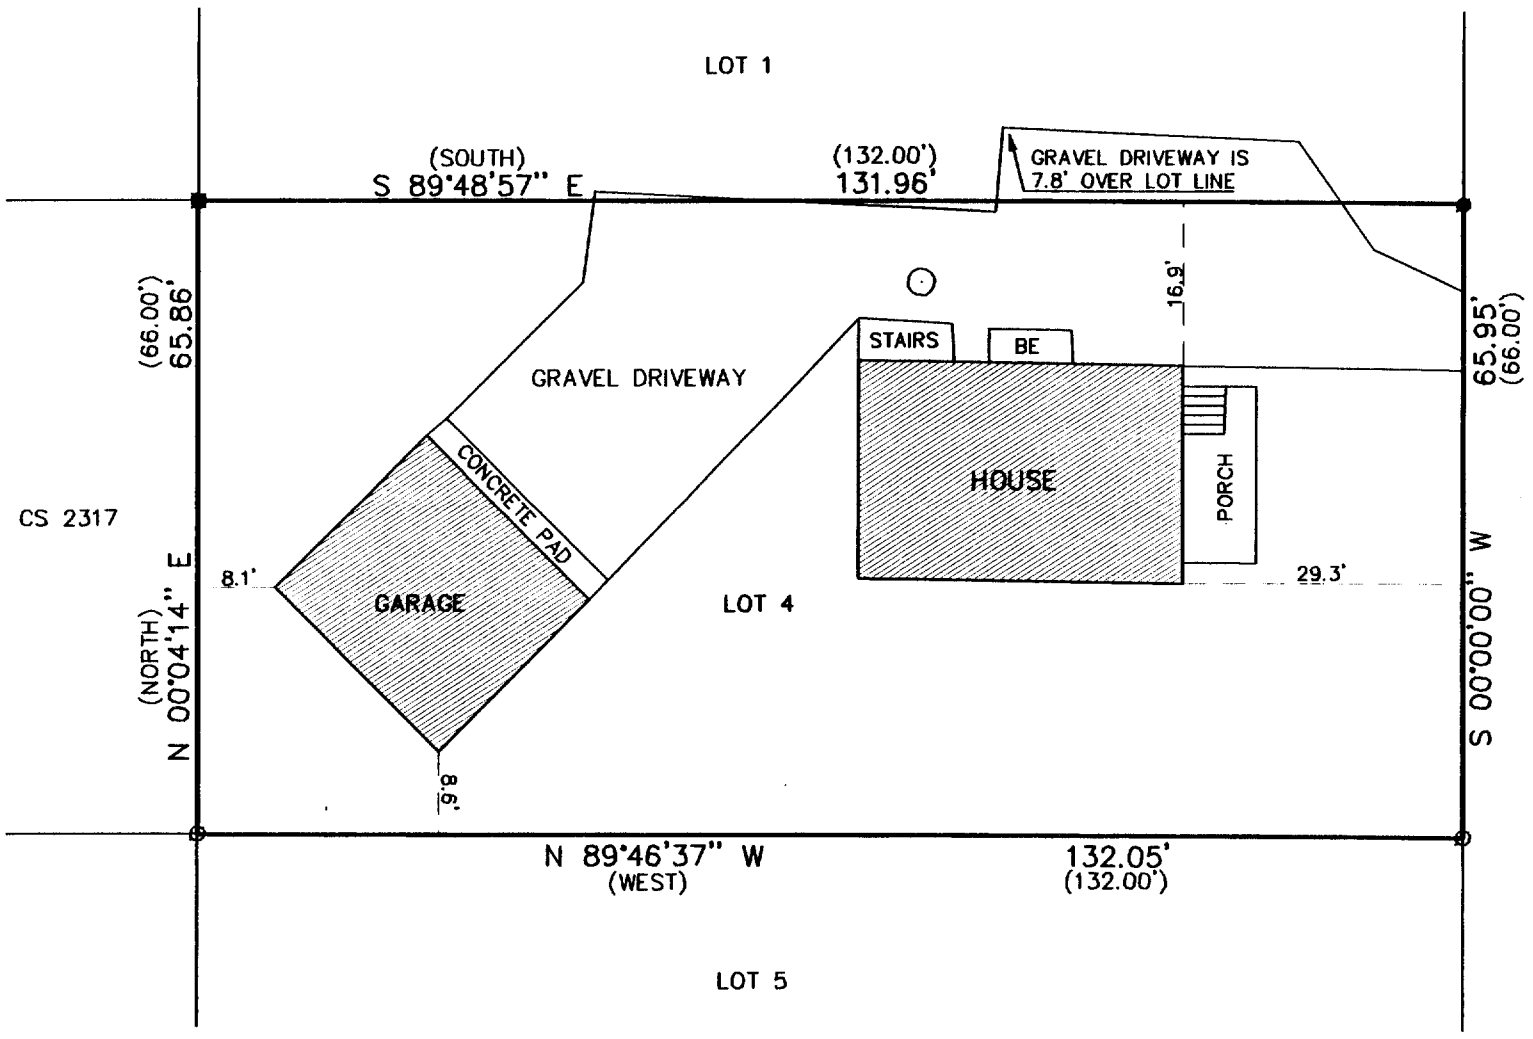

LEGEND

⊙	FOUND IRON PIPE
●	SET IRON PIPE
■	FOUND IRON PIN
BE	BASEMENT ENTRANCE
(XXX)	RECORDED AS
Ⓜ	MANHOLE

THE ABOVE MAP IS A TRUE REPRESENTATION THEREOF AND SHOWS THE SIZE AND LOCATION OF ALL THE PROPERTY, EXTERIOR BOUNDARIES, THE LOCATION OF ALL VISIBLE BOUNDARY FENCES , APPARENT EASEMENTS , ROADWAYS AND VISIBLE ENCROACHMENTS , IF ANY

THIS SURVEY IS MADE FOR THE USE OF THE PRESENT OWNERS OF THE PROPERTY , AND ALSO THOSE WHO PURCHASE , MORTGAGE OR GURANTEE TITLE THERETO WITHIN ONE (1) YEAR FROM DATE HERETO.

RECEIVED
JUN 24 1999

WISCONSIN
JOHN P. KROTT
S-2258
MUKWONAGO, WIS.
LAND SURVEYOR

John P Krott
JOHN P. KROTT , R.L.S. 2258

NOTE: THIS IS NOT A CERTIFIED COPY UNLESS SEAL IS IN RED.

JOB NUMBER 99086 WBX 00004

WBX-4 011-1381