
PLAT OF SURVEY

LOT 9 OF CEDAR POINT PARK FIRST ADDITION
LOCATED IN PART OF THE SOUTHEAST 1/4 OF
SECTION 6, TOWN 1 NORTH, RANGE 17 EAST,
VILLAGE OF WILLIAMS BAY,
WALWORTH COUNTY, WISCONSIN

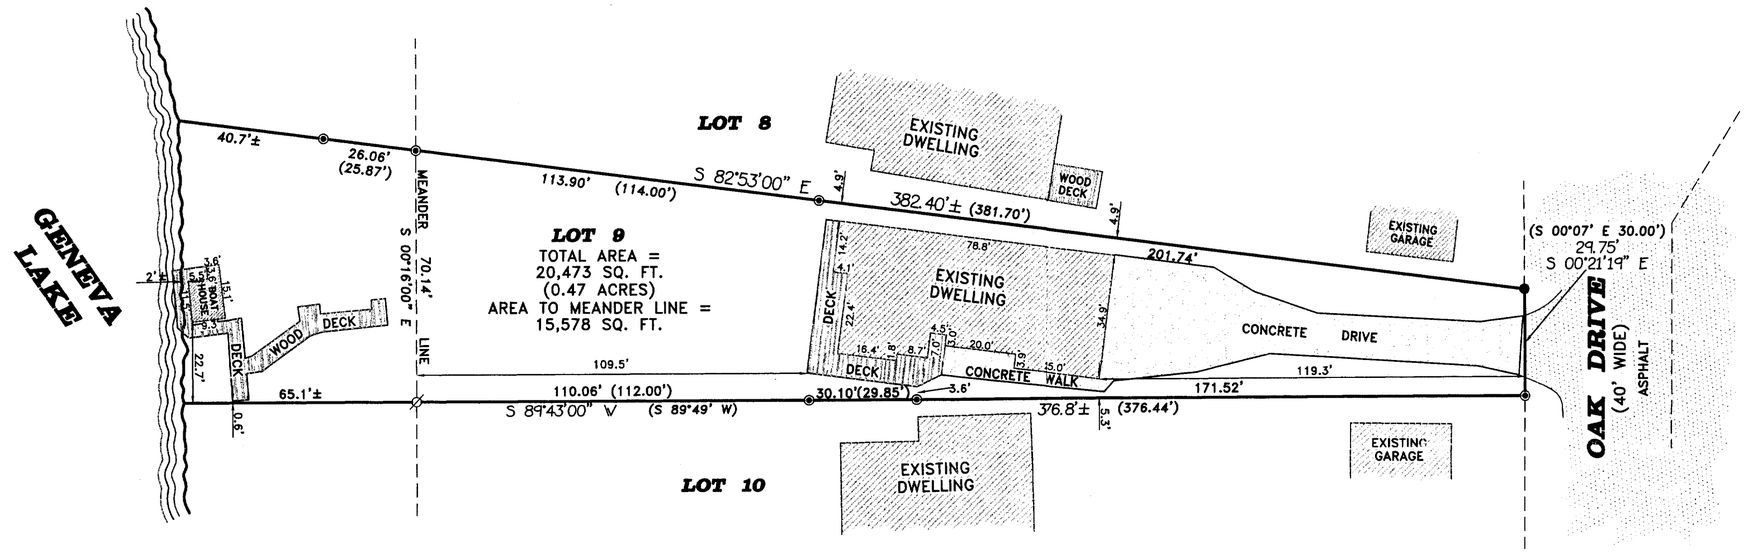

LEGEND

- ◉ – FOUND IRON PIPE
- ● – FOUND IRON REBAR
- ⌀ – SET IRON REBAR
- ( ) – RECORDED AS

30' 15' 0 30' 60'

SCALE: 1" = 30'

BEARING BASE: AS RECORDED

WISCONSIN
RANDAL J. MATHWICK
S-2411
ELKHORN
WI
LAND SURVEYOR

RECEIVED
OCT 2 9 1999

NOTE: COPIES OF THIS MAP TO WHICH THE FOLLOWING CERTIFICATE WILL APPLY ARE PRINTS SHOWING SURVEYOR'S ORIGINAL SEAL AND SIGNATURE IN RED INK. COPIES BY ANY OTHER MEANS MAY HAVE ALTERATIONS WHICH DO NOT REPRESENT THE SURVEYOR'S WORK PRODUCT.

I HEREBY CERTIFY THAT THE ABOVE DESCRIBED PROPERTY HAS BEEN SURVEYED UNDER MY DIRECTION AND THAT THE ABOVE MAP IS A TRUE REPRESENTATION THEREOF AND SHOWS THE SIZE AND LOCATION OF THE PROPERTY AND ITS EXTERIOR BOUNDARIES. THIS SURVEY IS MADE FOR THE USE OF THE PRESENT OWNERS OF THE PROPERTY, AND ALSO THOSE WHO PURCHASE, MORTGAGE, OR GUARANTEE THE TITLE THERETO WITHIN ONE YEAR FROM THE DATE HEREOF.

DATED: SEPTEMBER 9, 1999

RANDAL J. MATHWICK R.L.S. 2411

FARRIS, HANSEN & ASSOCIATES, INC.
ENGINEERING • ARCHITECTURE • SURVEYING
7 RIDGWAY COURT
P.O. BOX 437
ELKHORN, WI 53121
OFFICE: (414)723-2098
FAX: (414)723-5886

PLAT OF SURVEY
64 OAK DRIVE
WILLIAMS BAY, WISCONSIN
LOT 9 CEDAR POINT PARK 1ST ADD'N.
PART OF THE SE1/4 OF SEC. 6, T1N., R.17E.,
VILLAGE OF WILLIAMS BAY
WALWORTH COUNTY, WISCONSIN

WORK ORDERED BY:
DAVE CURRY
GENEVA LAKEFRONT REALTY
40 WEST GENEVA
WILLIAMS BAY, WISCONSIN

REVISIONS

SCALES: 1" = 30'
DATE: 8-09-99
PROJECT NO. 5385
SHEET NO. 1 of 1

$11-1389 WCP1-8