
PLAT OF SURVEY

LOT 138

BAYWOOD HEIGHTS ADDITION NO. 2

LOCATED IN THE VILLAGE OF WILLIAMS BAY, WALWORTH COUNTY, WISCONSIN, AND RECORDED WITH THE WALWORTH COUNTY REGISTER OF DEEDS IN CABINET B OF PLATS ON SLIDE 97 AS DOCUMENT NO. 197248.

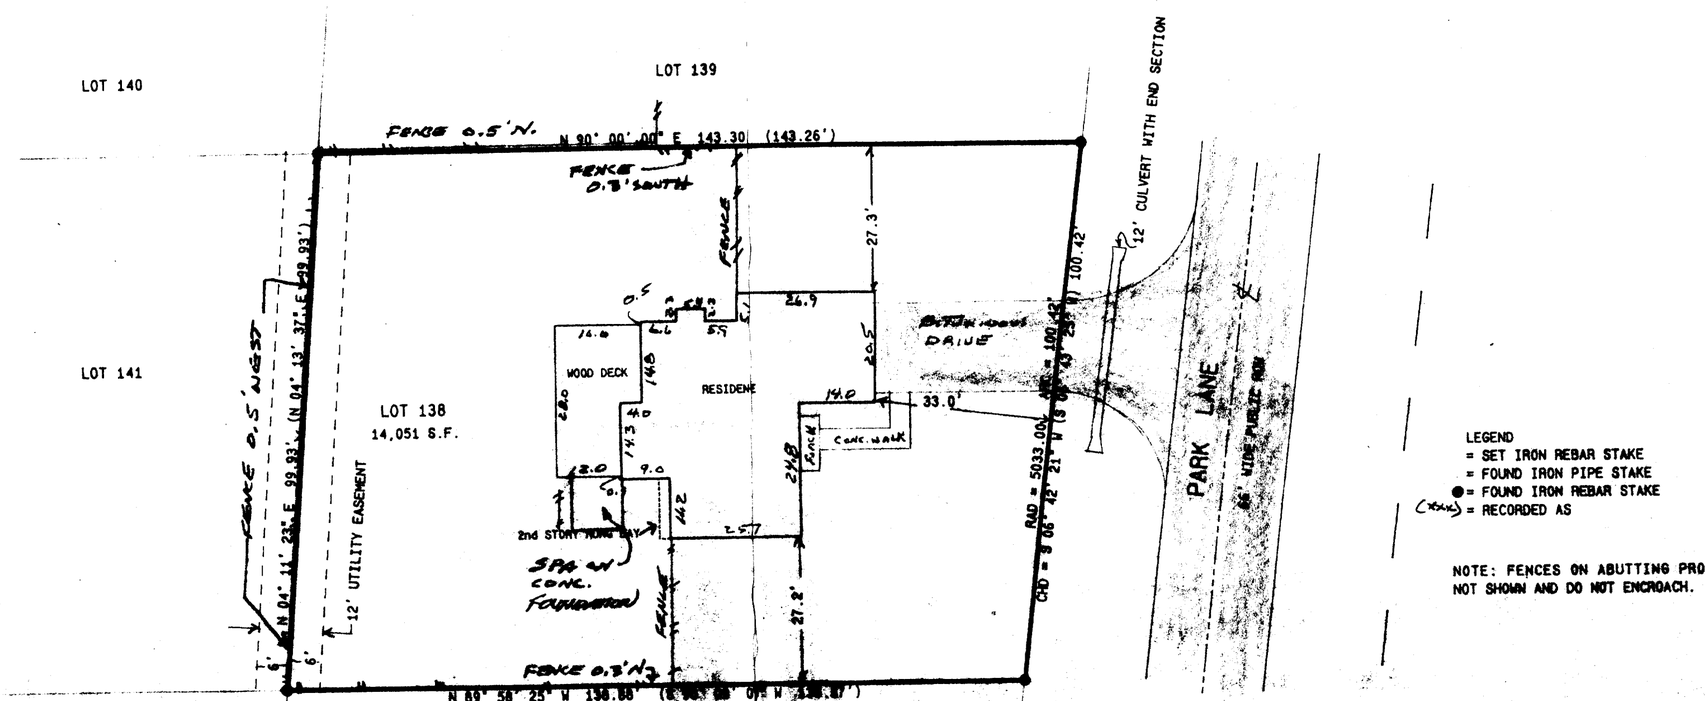

LEGEND
= SET IRON REBAR STAKE
= FOUND IRON PIPE STAKE
● = FOUND IRON REBAR STAKE
(XXXX) = RECORDED AS

NOTE: FENCES ON ABUTTING PROPERTIES NOT SHOWN AND DO NOT ENCROACH.

1999 RESURVEY
ORDERED BY:
GENEVA LAKEFRONT REALTY
P.O. BOX 901
WILLIAMS BAY, WI. 53191

MAP SCALE IN FEET ORIGINAL 1" = 20'

NOTE: COPIES OF THIS MAP TO WHICH THE FOLLOWING CERTIFICATE WILL APPLY ARE BLUE LINE PRINTS SHOWING SURVEYOR'S ORIGINAL SEAL AND SIGNATURE IN BLACK INK. COPIES BY ANY OTHER MEANS MAY HAVE ALTERATIONS WHICH DO NOT REPRESENT THE SURVEYOR'S WORK PRODUCT.

I HEREBY CERTIFY THAT THE ABOVE DESCRIBED PROPERTY HAS BEEN SURVEYED UNDER MY DIRECTION AND THAT THE ABOVE MAP IS A TRUE REPRESENTATION THEREOF AND SHOWS THE SIZE AND LOCATION OF THE PROPERTY AND ITS EXTERIOR BOUNDARIES. THIS SURVEY IS MADE FOR THE USE OF THE PRESENT OWNERS OF THE PROPERTY, AND ALSO THOSE WHO PURCHASE, MORTGAGE, OR GUARANTEE THE TITLE THERETO WITHIN ONE YEAR FROM THE DATE HEREOF.

WISCONSIN
PETER S. GORDON
S-2101
ELKHORN, WI
LAND SURVEYOR

DATED: 3/24/95

10-29-1999
RESURVEY & RECERTIFICATION

PETER S. GORDON R.L.S. 2101

RECEIVED
NOV 18 1999

LOT 138
BAYWOOD HEIGHTS
ADDITION NO. 2

WORK ORDERED BY: JOHN BAKKEN
PO BOX 217
LAKE GENEVA, WISCONSIN 53147

PARKS, NORDEEN & ASSOCIATES, INC.
Professional Surveying
P.O. Box 437
Elkhorn, WI 53121
(414) 723-4038
FAX (414) 723-2657

REVISIONS

PROJECT #
3828
DATE
03/24/95

WBW2-89
811-1405