


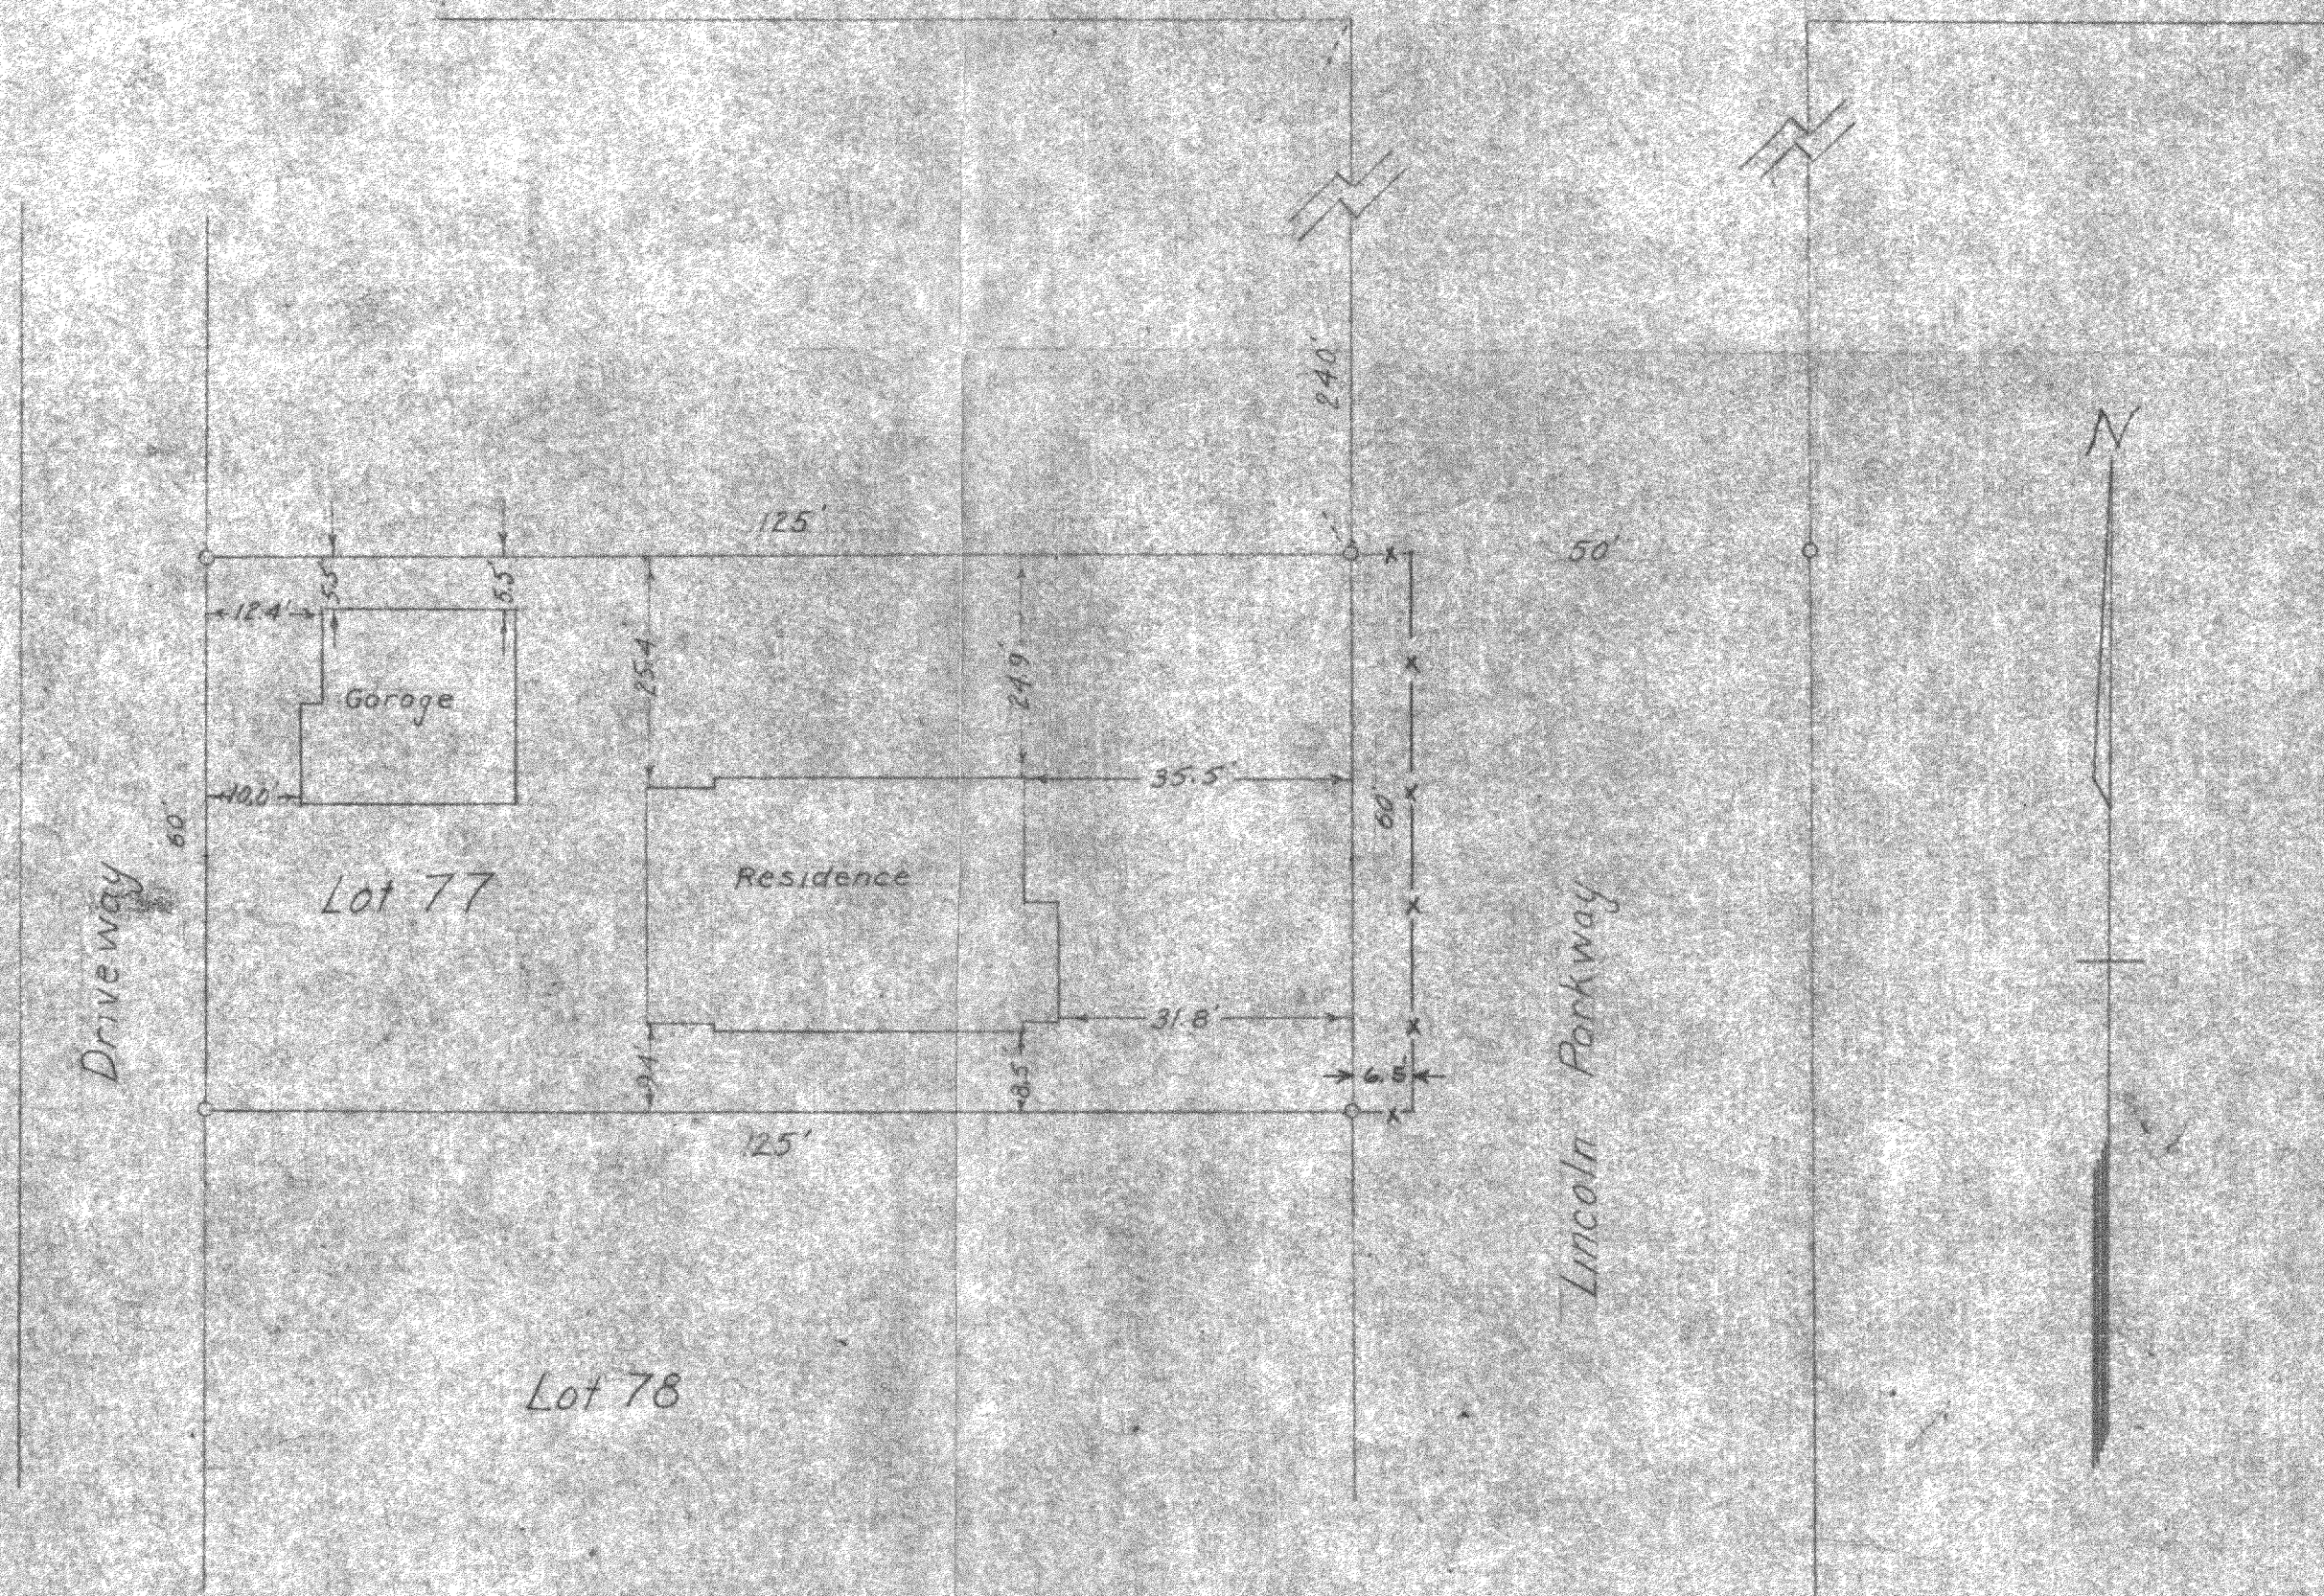

State of Wisconsin } 55
County of Walworth

I, Lloyd L. Jensen, do hereby certify that I have surveyed the property described hereon according to the official records, and that the plat hereon is a correct representation of the lot lines and principal lines of buildings thereon.

Elkhorn, Wisconsin
August 1956

Lloyd L. Jensen
Surveyor

o - Iron Pipe
x - Fence

PLAT OF SURVEY OF

Lot 77, Cedar Point Park Subdivision,
Sec. 6, T1N, R1E Williams Bay
Walworth County, Wisconsin

Lloyd L. Jensen
Surveyor

SCALE 1" = 20'

DATE August 1956