
ABELL
SURVEYING & MAPPING

1140 SEQUOIA STREET • DELAVAN, WISCONSIN 53115
262-728-6737

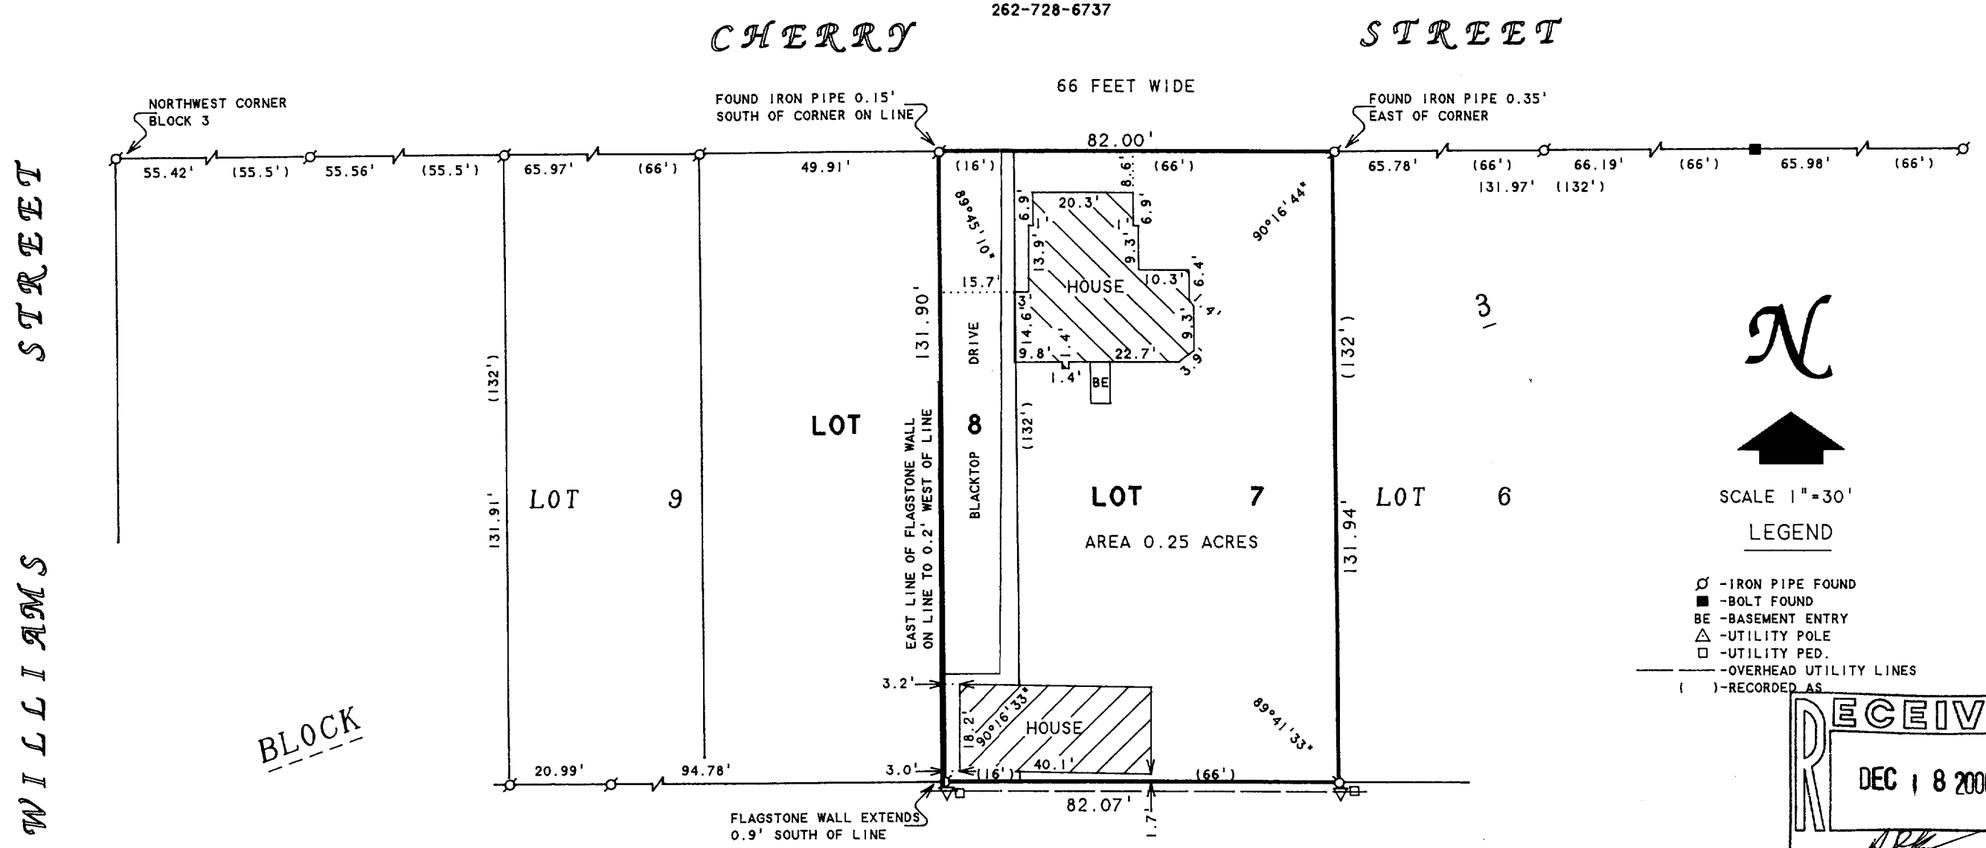

RECEIVED
DEC 18 2000

PLAT OF SURVEY OF

LOT 7 AND THE EAST 16 FEET OF LOT 8, BLOCK 3, ORIGINAL PLAT OF THE VILLAGE OF WILLIAMS BAY, WALWORTH COUNTY, WISCONSIN.

ORDERED BY: EQUIS CORPORATION
250 E. WISCONSIN AVENUE
MILWAUKEE, WI 53202

I HEREBY CERTIFY THAT I HAVE SURVEYED THE ABOVE ~~DESCRIBED PROPERTY AND THAT~~ THE ABOVE MAP IS A TRUE REPRESENTATION THEREOF AND SHOWS THE SIZE AND LOCATION OF THE PROPERTY, ITS EXTERIOR BOUNDARIES, THE LOCATION OF ALL VISIBLE STRUCTURES AND DIMENSIONS OF ALL PRINCIPAL BUILDINGS THEREON, BOUNDARY FENCES, APPARENT EASEMENTS, ROADWAYS AND VISIBLE ENCROACHMENTS, IF ANY, TO THE BEST OF MY KNOWLEDGE AND BELIEF.

THIS SURVEY IS MADE FOR THE USE OF THE PRESENT OWNERS OF THE PROPERTY, AND ALSO THOSE WHO PURCHASE, MORTGAGE, OR GUARANTEE THE TITLE THERETO WITHIN ONE (1) YEAR FROM DATE HEREON.

David F. Abell

DAVID F. ABELL
WISCONSIN REGISTERED LAND SURVEYOR, S-1596

August 28, 2000
DATE

JOB NUMBER - 00133

NOTE: THIS IS NOT A CERTIFIED COPY UNLESS SEALED.

Ø11-151Ø
WOP-37 NOW BY CSM 3341