
PLAT OF SURVEY

LOT 121 OF CEDAR POINT PARK SECOND ADDITION
LOCATED IN THE VILLAGE OF WILLIAMS BAY
WALWORTH COUNTY, WISCONSIN

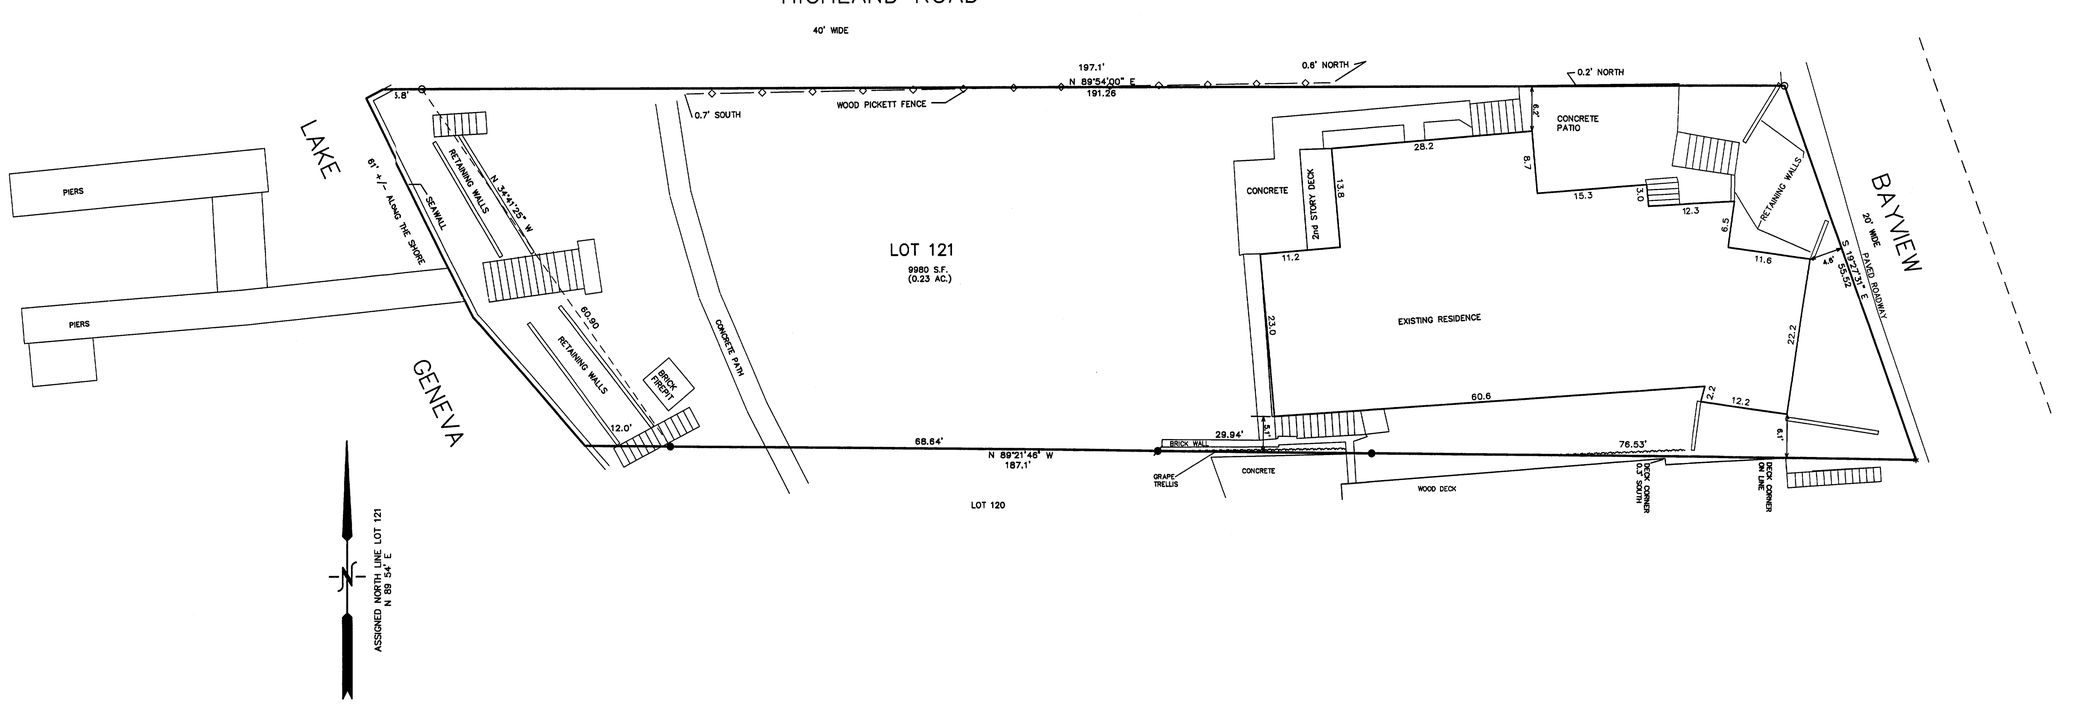

LEGEND

- ● = FOUND IRON REBAR STAKE
- ⌀ = SET IRON REBAR STAKE
- ○ = FOUND IRON PIPE STAKE 1" DIA.
- ∗ = FOUND PK NAIL IN PAVEMENT
- (xxx) = RECORDED AS

NOTE: COPIES OF THIS MAP TO WHICH THE FOLLOWING CERTIFICATE WILL APPLY SHOW SURVEYOR'S ORIGINAL SEAL AND SIGNATURE IN RED INK. COPIES BY ANY OTHER MEANS MAY HAVE ALTERATIONS WHICH DO NOT REPRESENT THE SURVEYOR'S WORK PRODUCT.

I HEREBY CERTIFY THAT THE ABOVE DESCRIBED PROPERTY HAS BEEN SURVEYED UNDER MY DIRECTION AND THAT THE ABOVE MAP IS A TRUE REPRESENTATION THEREOF AND SHOWS THE SIZE AND LOCATION OF THE PROPERTY AND ITS EXTERIOR BOUNDARIES. THIS SURVEY IS MADE FOR THE USE OF THE PRESENT OWNERS OF THE PROPERTY, AND ALSO THOSE WHO PURCHASE, MORTGAGE, OR GUARANTEE THE TITLE THERETO WITHIN ONE YEAR FROM THE DATE HEREOF.

DATED: NOV. 9, 2001

PETER S. GORDON R.L.S. 2101

RECEIVED
NOV 1 4 2001

NOV 0 9 2001

WORK ORDERED BY:
MIKE CILIO
1490 MARCUS CT. W.
PARK RIDGE, IL. 60068

FARRIS, HANSEN & ASSOCIATES, INC.
ENGINEERING – ARCHITECTURE – SURVEYING
7 RIDGWAY COURT P.O. BOX 437
ELKHORN, WISCONSIN 53121
OFFICE: (262) 723-2098 FAX: (262) 723-5886

REVISIONS

PROJECT NO. 5921
DATE 11-08-01
SHEET NO. 1 OF 1

WCP2-19 11-1579