
ABELL
SURVEYING & MAPPING
DELAVAN, WISCONSIN 53115
262-728-6737

RECEIVED
DEC 2 1 2001

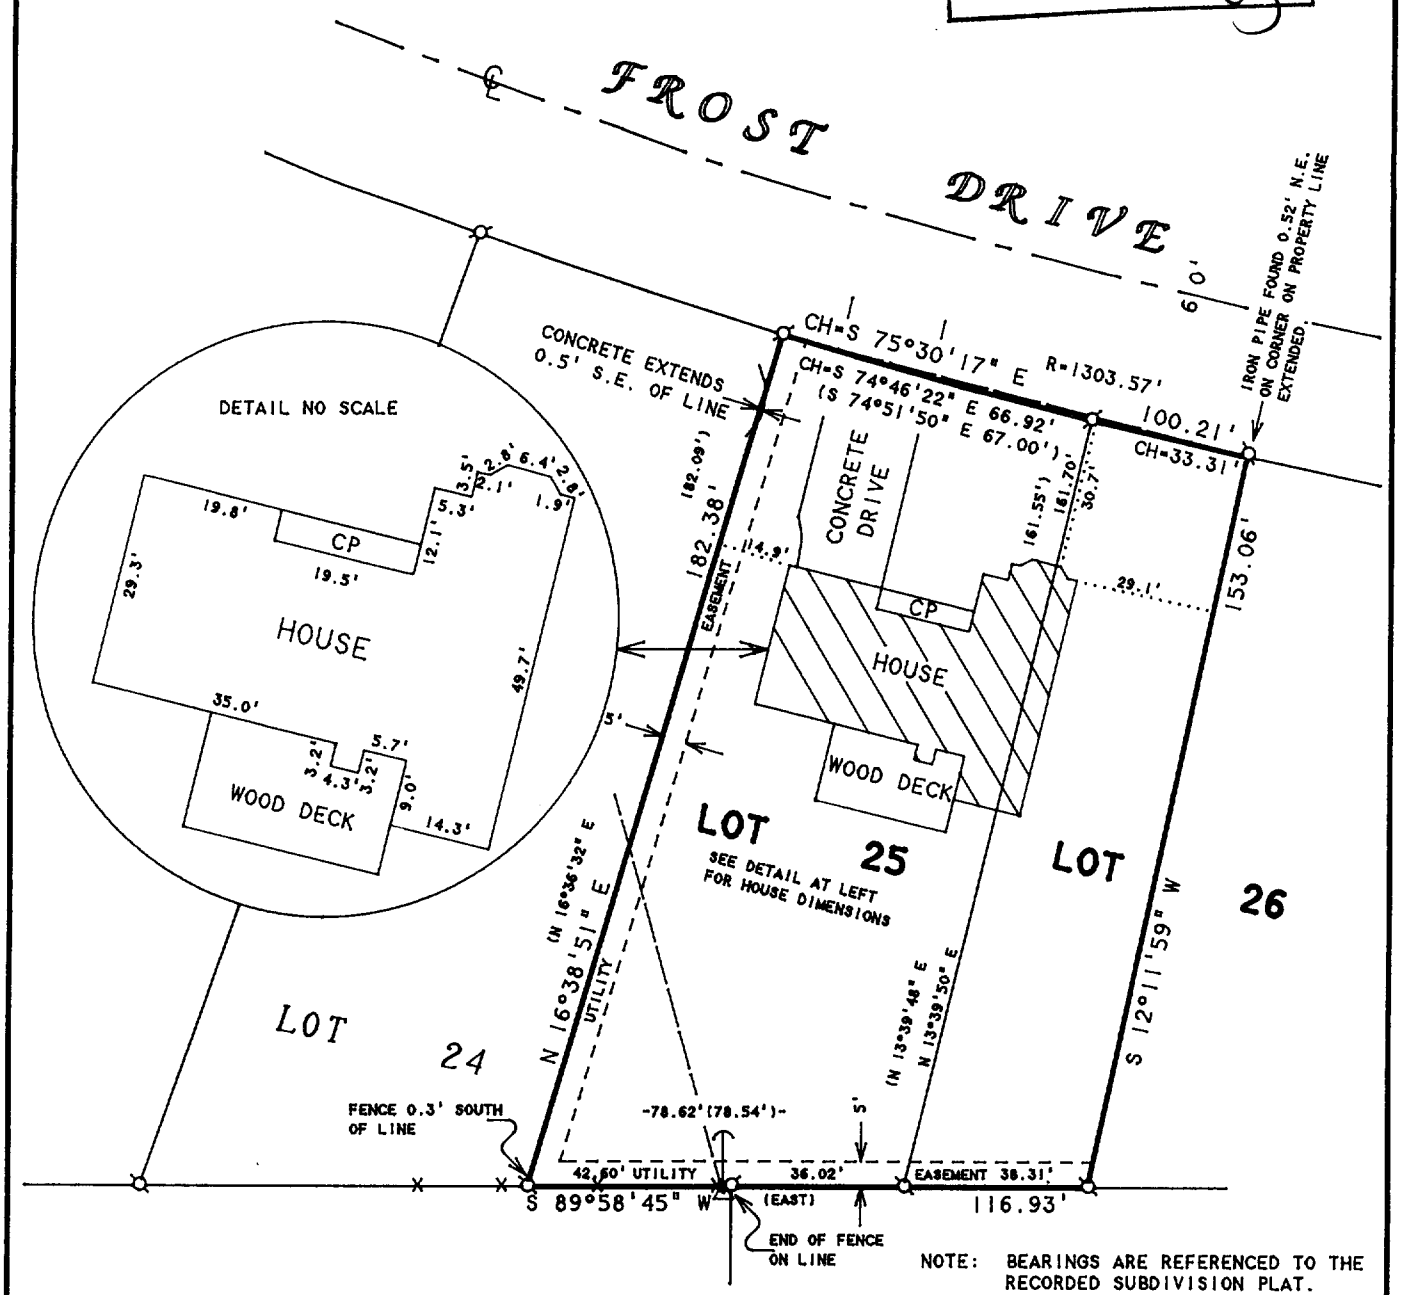

NOTE: BEARINGS ARE REFERENCED TO THE RECORDED SUBDIVISION PLAT.

ORDERED BY: KEEFE REAL ESTATE
P.O. BOX 460
LAKE GENEVA, WI 53147

PLAT OF SURVEY OF

LOT 25 AND THE WEST 1/2 OF LOT 26, BAYWOOD HEIGHTS ADDITION NO. 1, LOCATED IN THE VILLAGE OF WILLIAMS BAY, WALWORTH COUNTY, WISCONSIN.

N

SCALE 1"=40'

LEGEND

- ⌀ -IRON PIPE FOUND
- △ -UTILITY POLE
- → -GUY WIRE
- ———— -OVERHEAD UTILITY LINES
- ×——× -WIRE FENCE
- CP -CONCRETE PORCH
- ( )-RECORDED AS

I HEREBY CERTIFY THAT I HAVE SURVEYED THE ABOVE DESCRIBED PROPERTY AND THAT THE ABOVE MAP IS A TRUE REPRESENTATION THEREOF AND SHOWS THE SIZE AND LOCATION OF THE PROPERTY, ITS EXTERIOR BOUNDARIES, THE LOCATION OF ALL VISIBLE STRUCTURES AND DIMENSIONS OF ALL PRINCIPAL BUILDINGS THEREON, BOUNDARY FENCES, APPARENT EASEMENTS, ROADWAYS AND VISIBLE ENCROACHMENTS, IF ANY, TO THE BEST OF MY KNOWLEDGE AND BELIEF.

THIS SURVEY IS MADE FOR THE USE OF THE PRESENT OWNERS OF THE PROPERTY, AND ALSO THOSE WHO PURCHASE, MORTGAGE, OR GUARANTEE THE TITLE THERETO WITHIN ONE (1) YEAR FROM DATE HEREON.

David F. Abell

DAVID F. ABELL
WISCONSIN REGISTERED LAND SURVEYOR, S-1596

September 11, 2001

DATE JOB NUMBER - 96164C

NOTE: THIS IS NOT A CERTIFIED COPY UNLESS SEALED.

WBW1-5 11-1583