


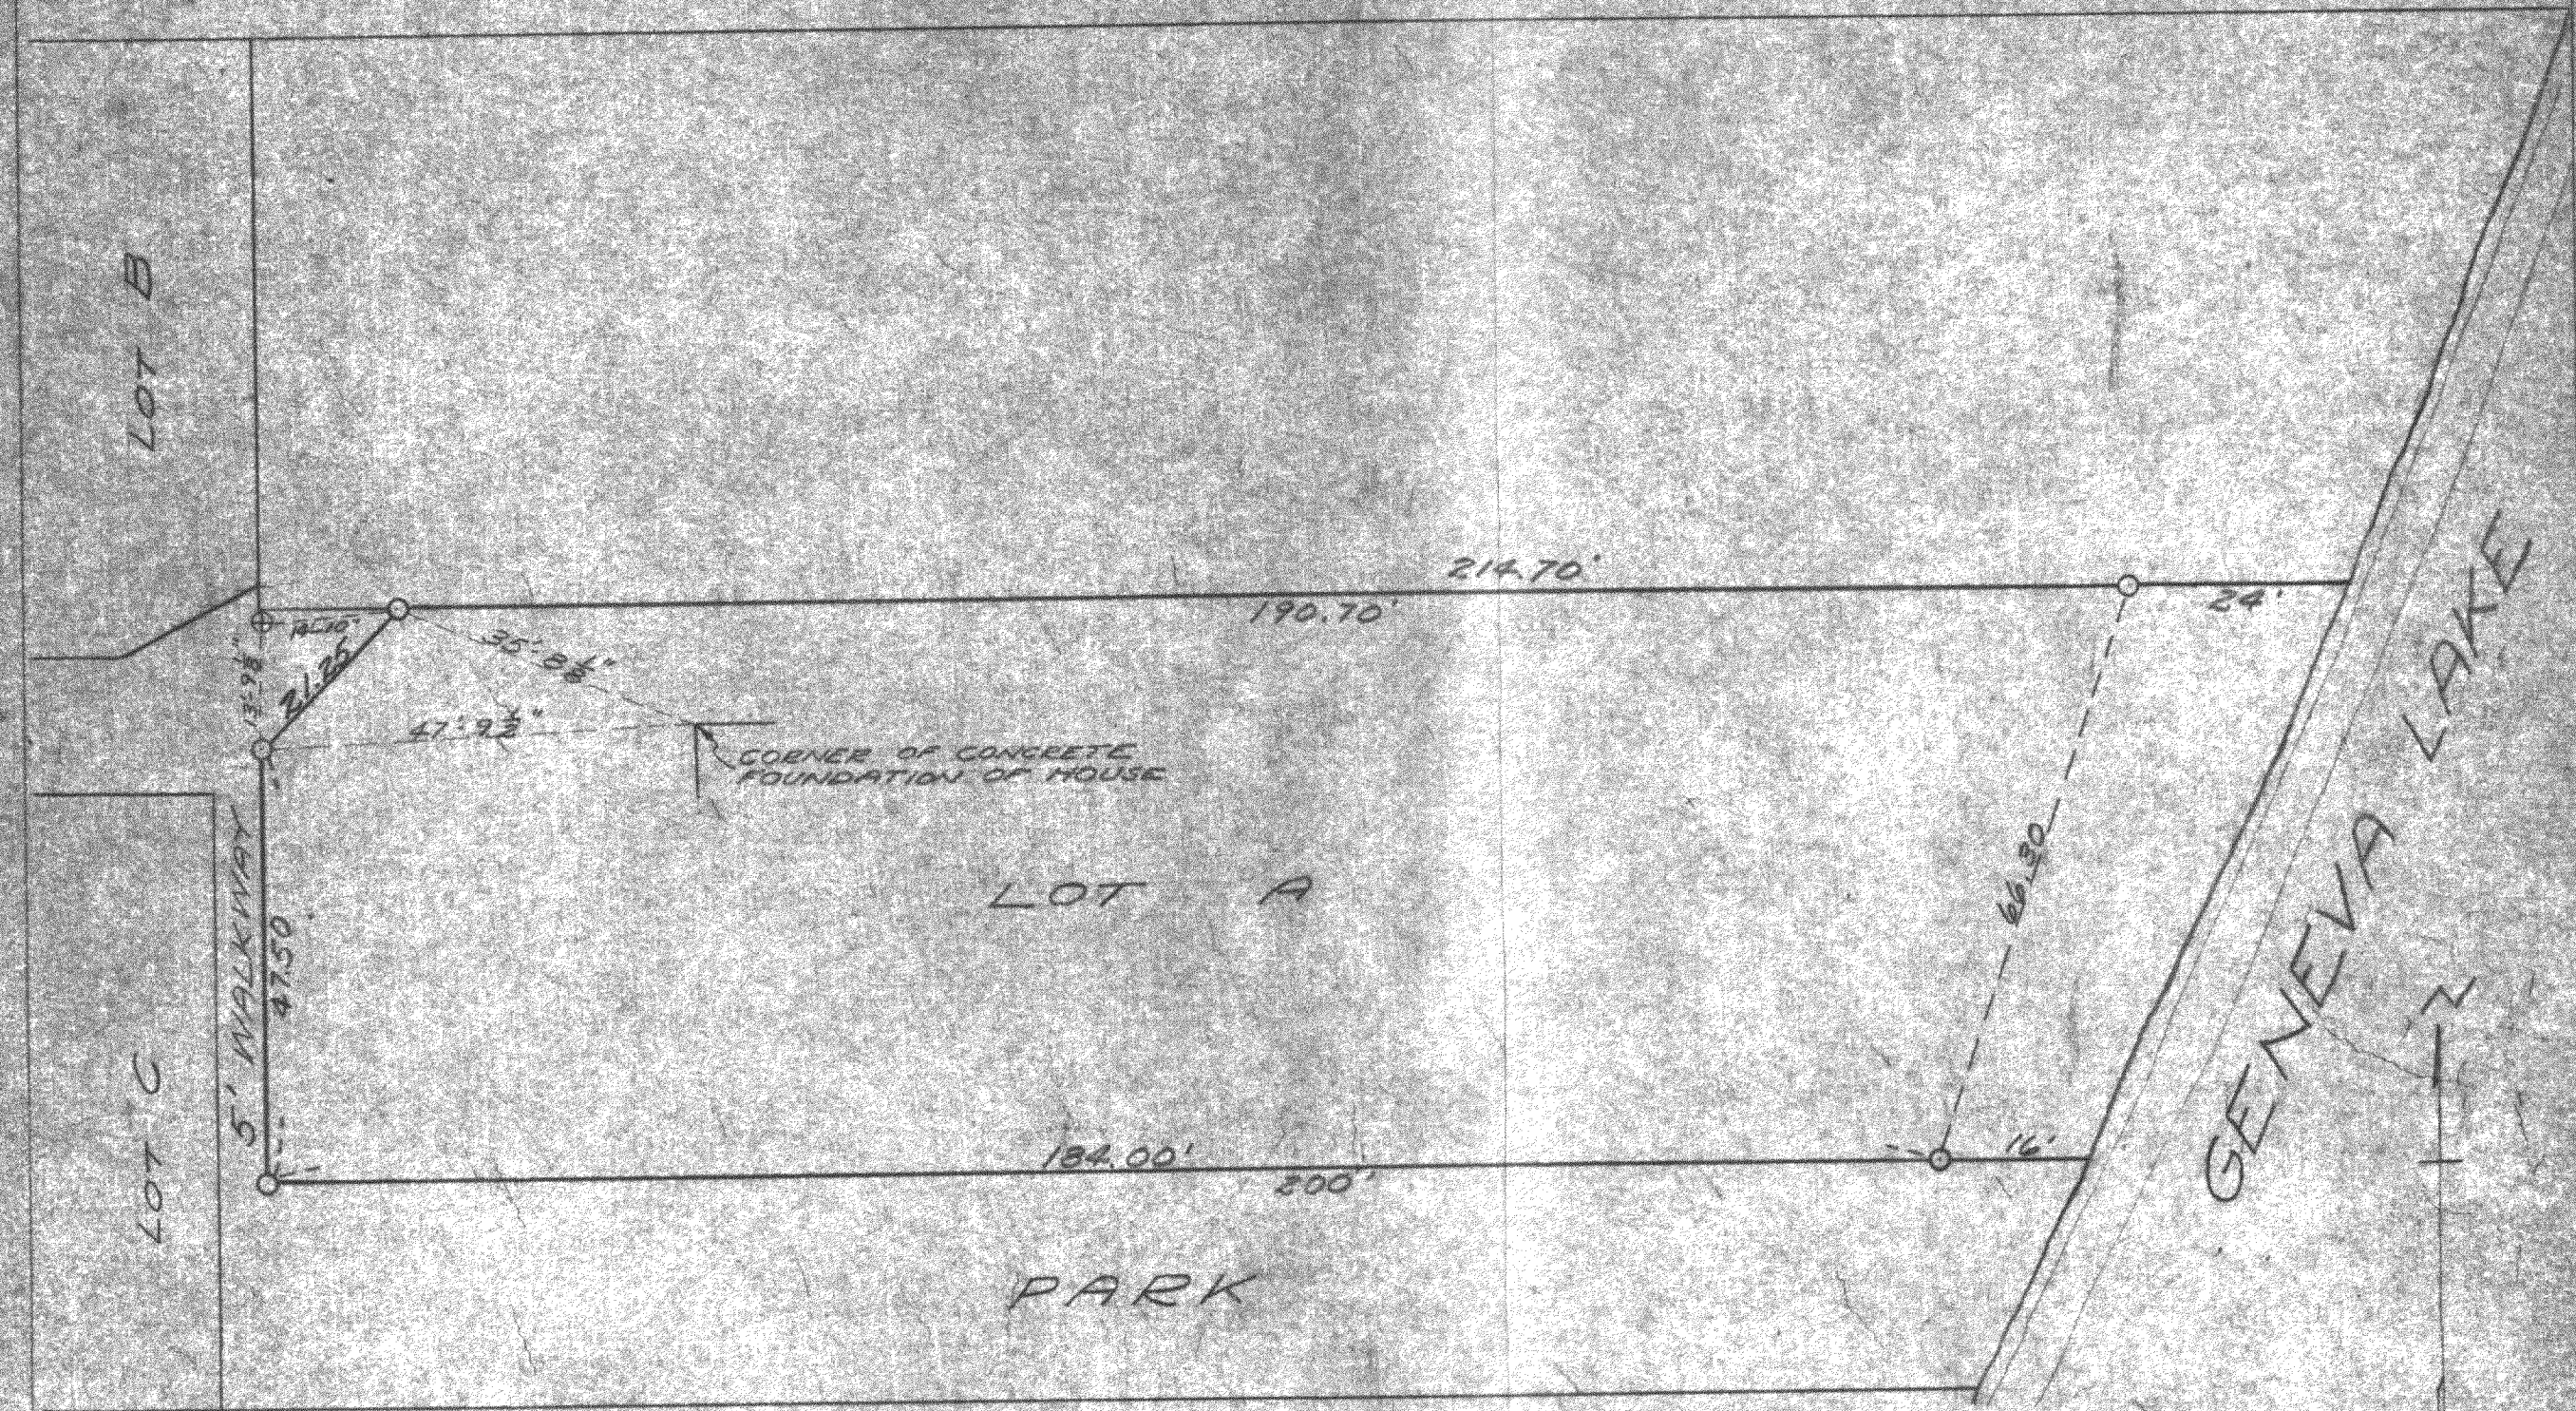

PLAT OF SURVEY OF LOT "A" OF LOCH VISTA SUBDIVISION NO. 2
IN THE VILLAGE OF WILLIAMS BAY, WALWORTH COUNTY, WISCONSIN.

OCTOBER 18, 1945

Ployd L. Jensen
COUNTY SURVEYOR

SCALE - 1" = 20'
O = IRON PIPE