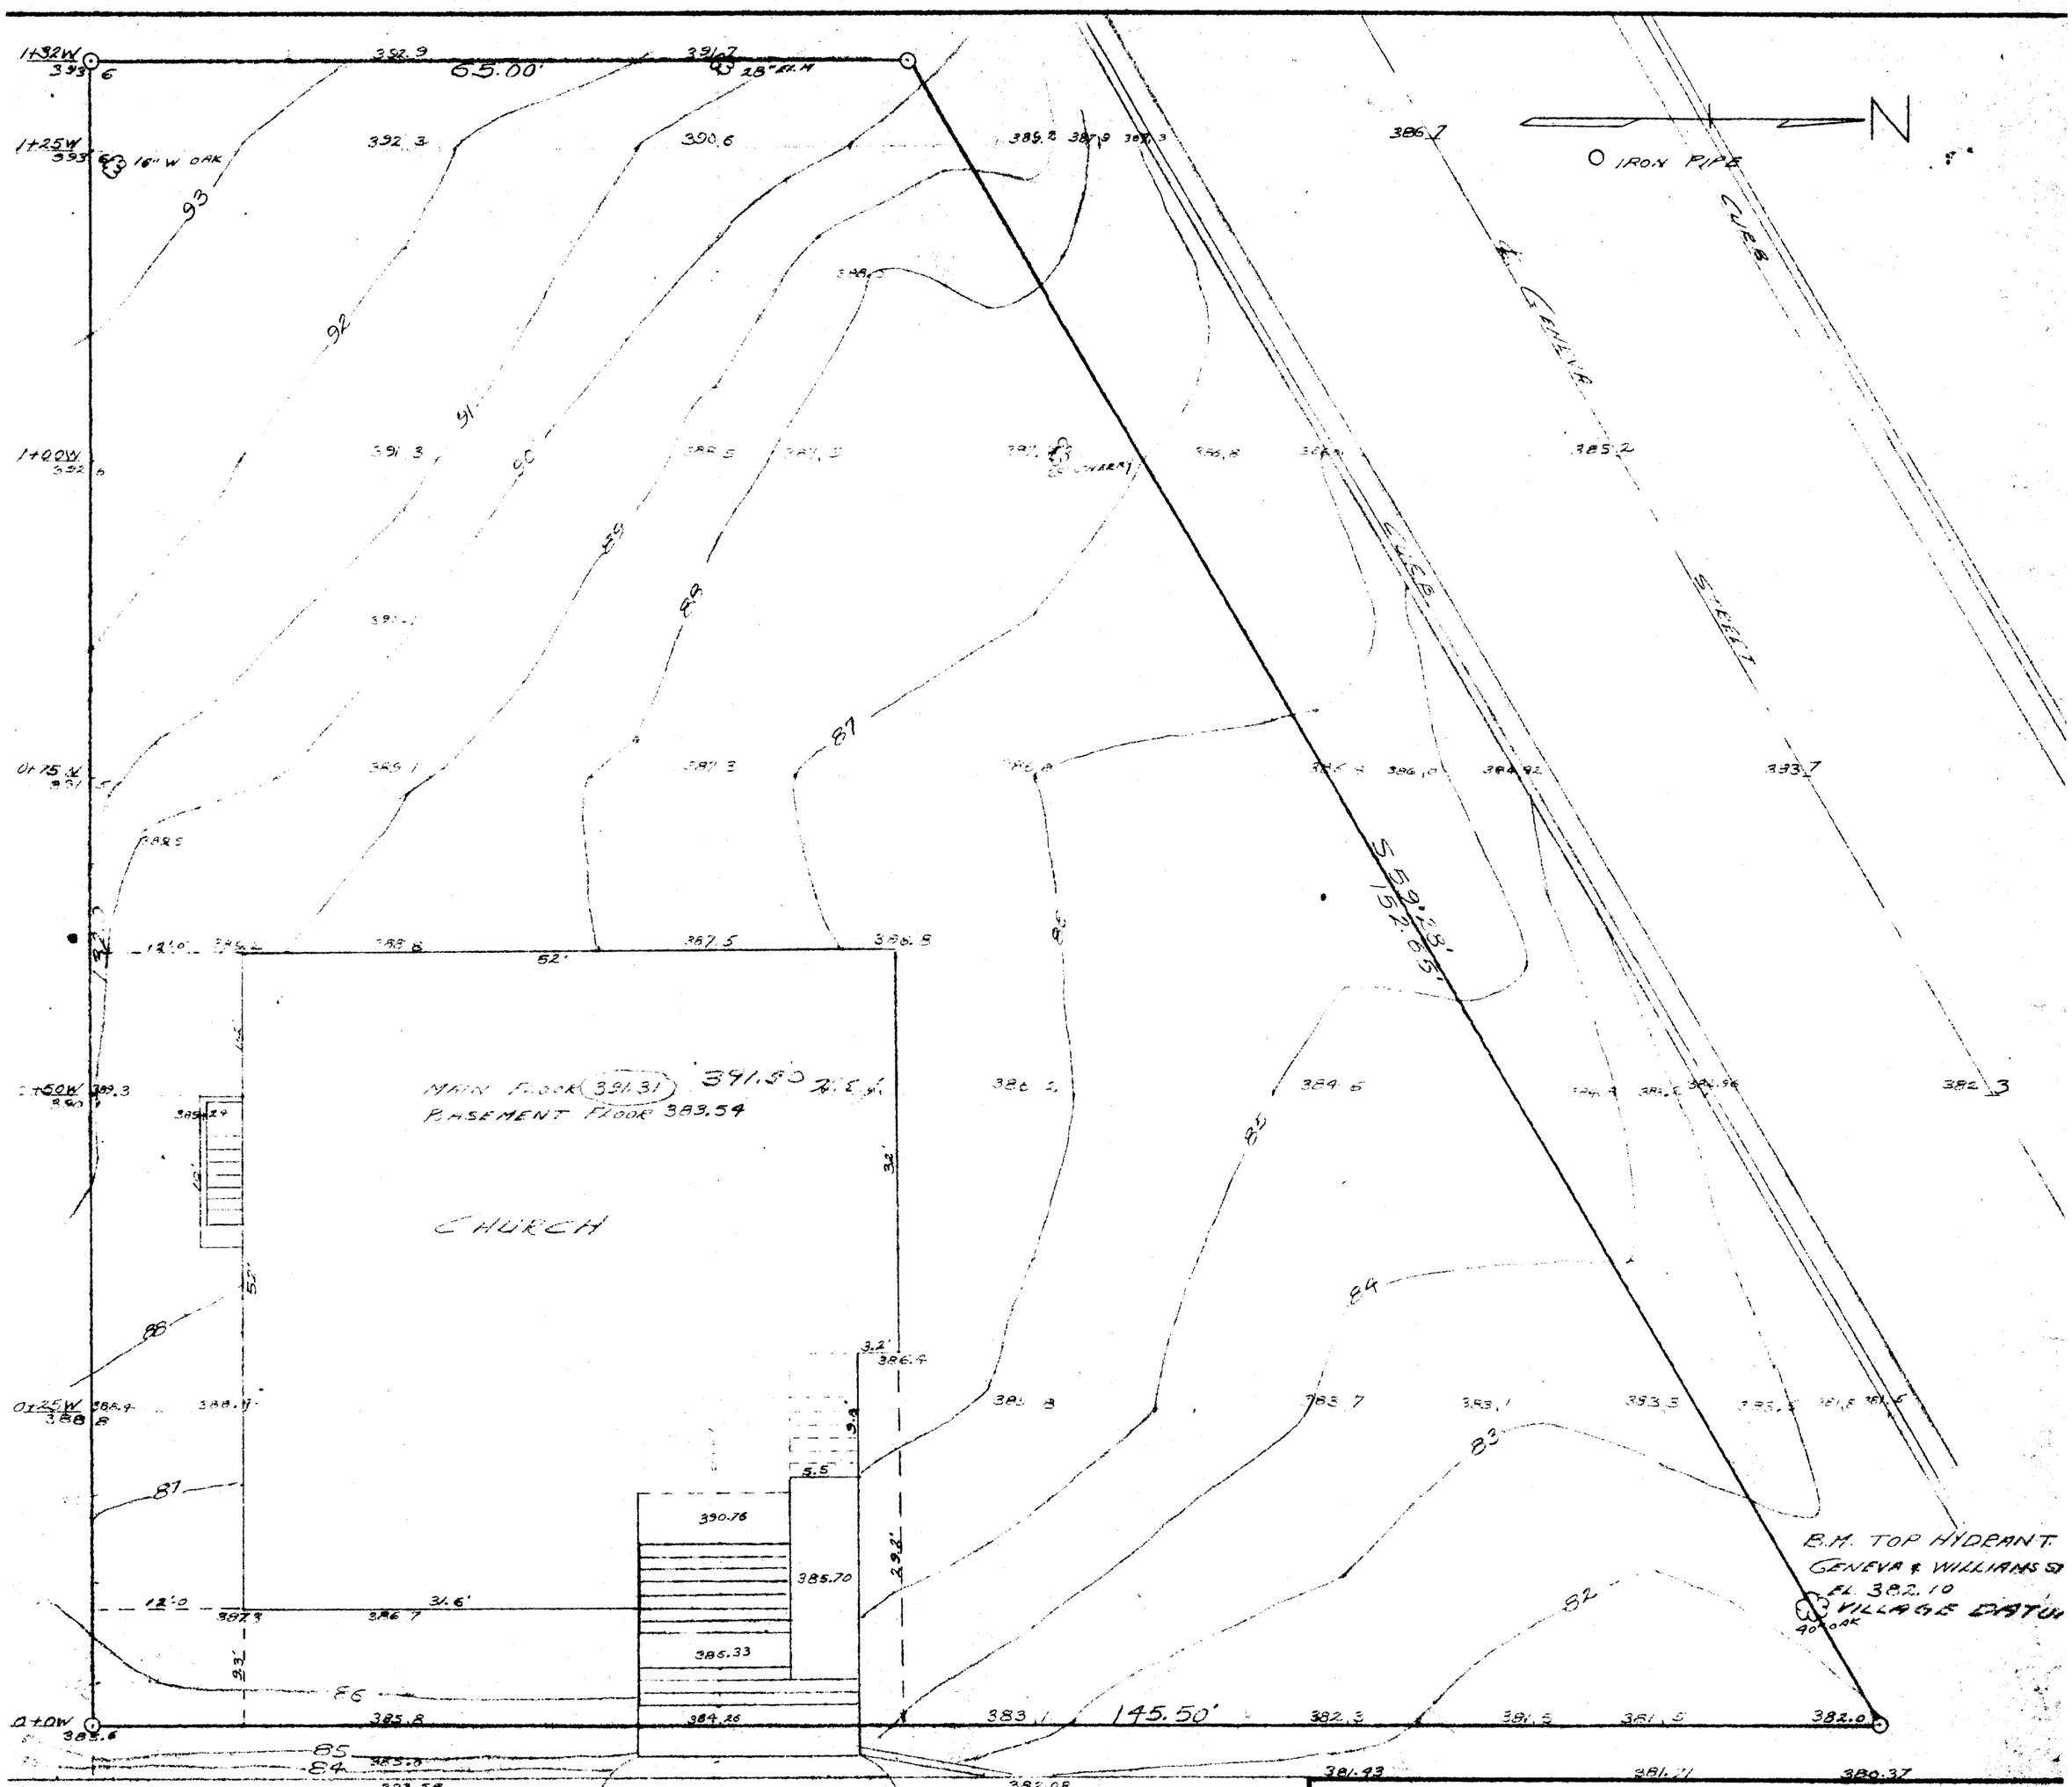

PLAT OF SURVEY
OF

LOT 1 BLOCK 5 OF ORIGINAL PLAT
VILLAGE OF WILLIAMS BAY
WALWORTH COUNTY WISCONSIN
ALSO SHOWING BUILDING LOCATION
AND TOPOGRAPHY

H. E. Johnson
SURVEYOR

SCALE 1" = 10'

DATE 3-26-59

Wop-68

11-169