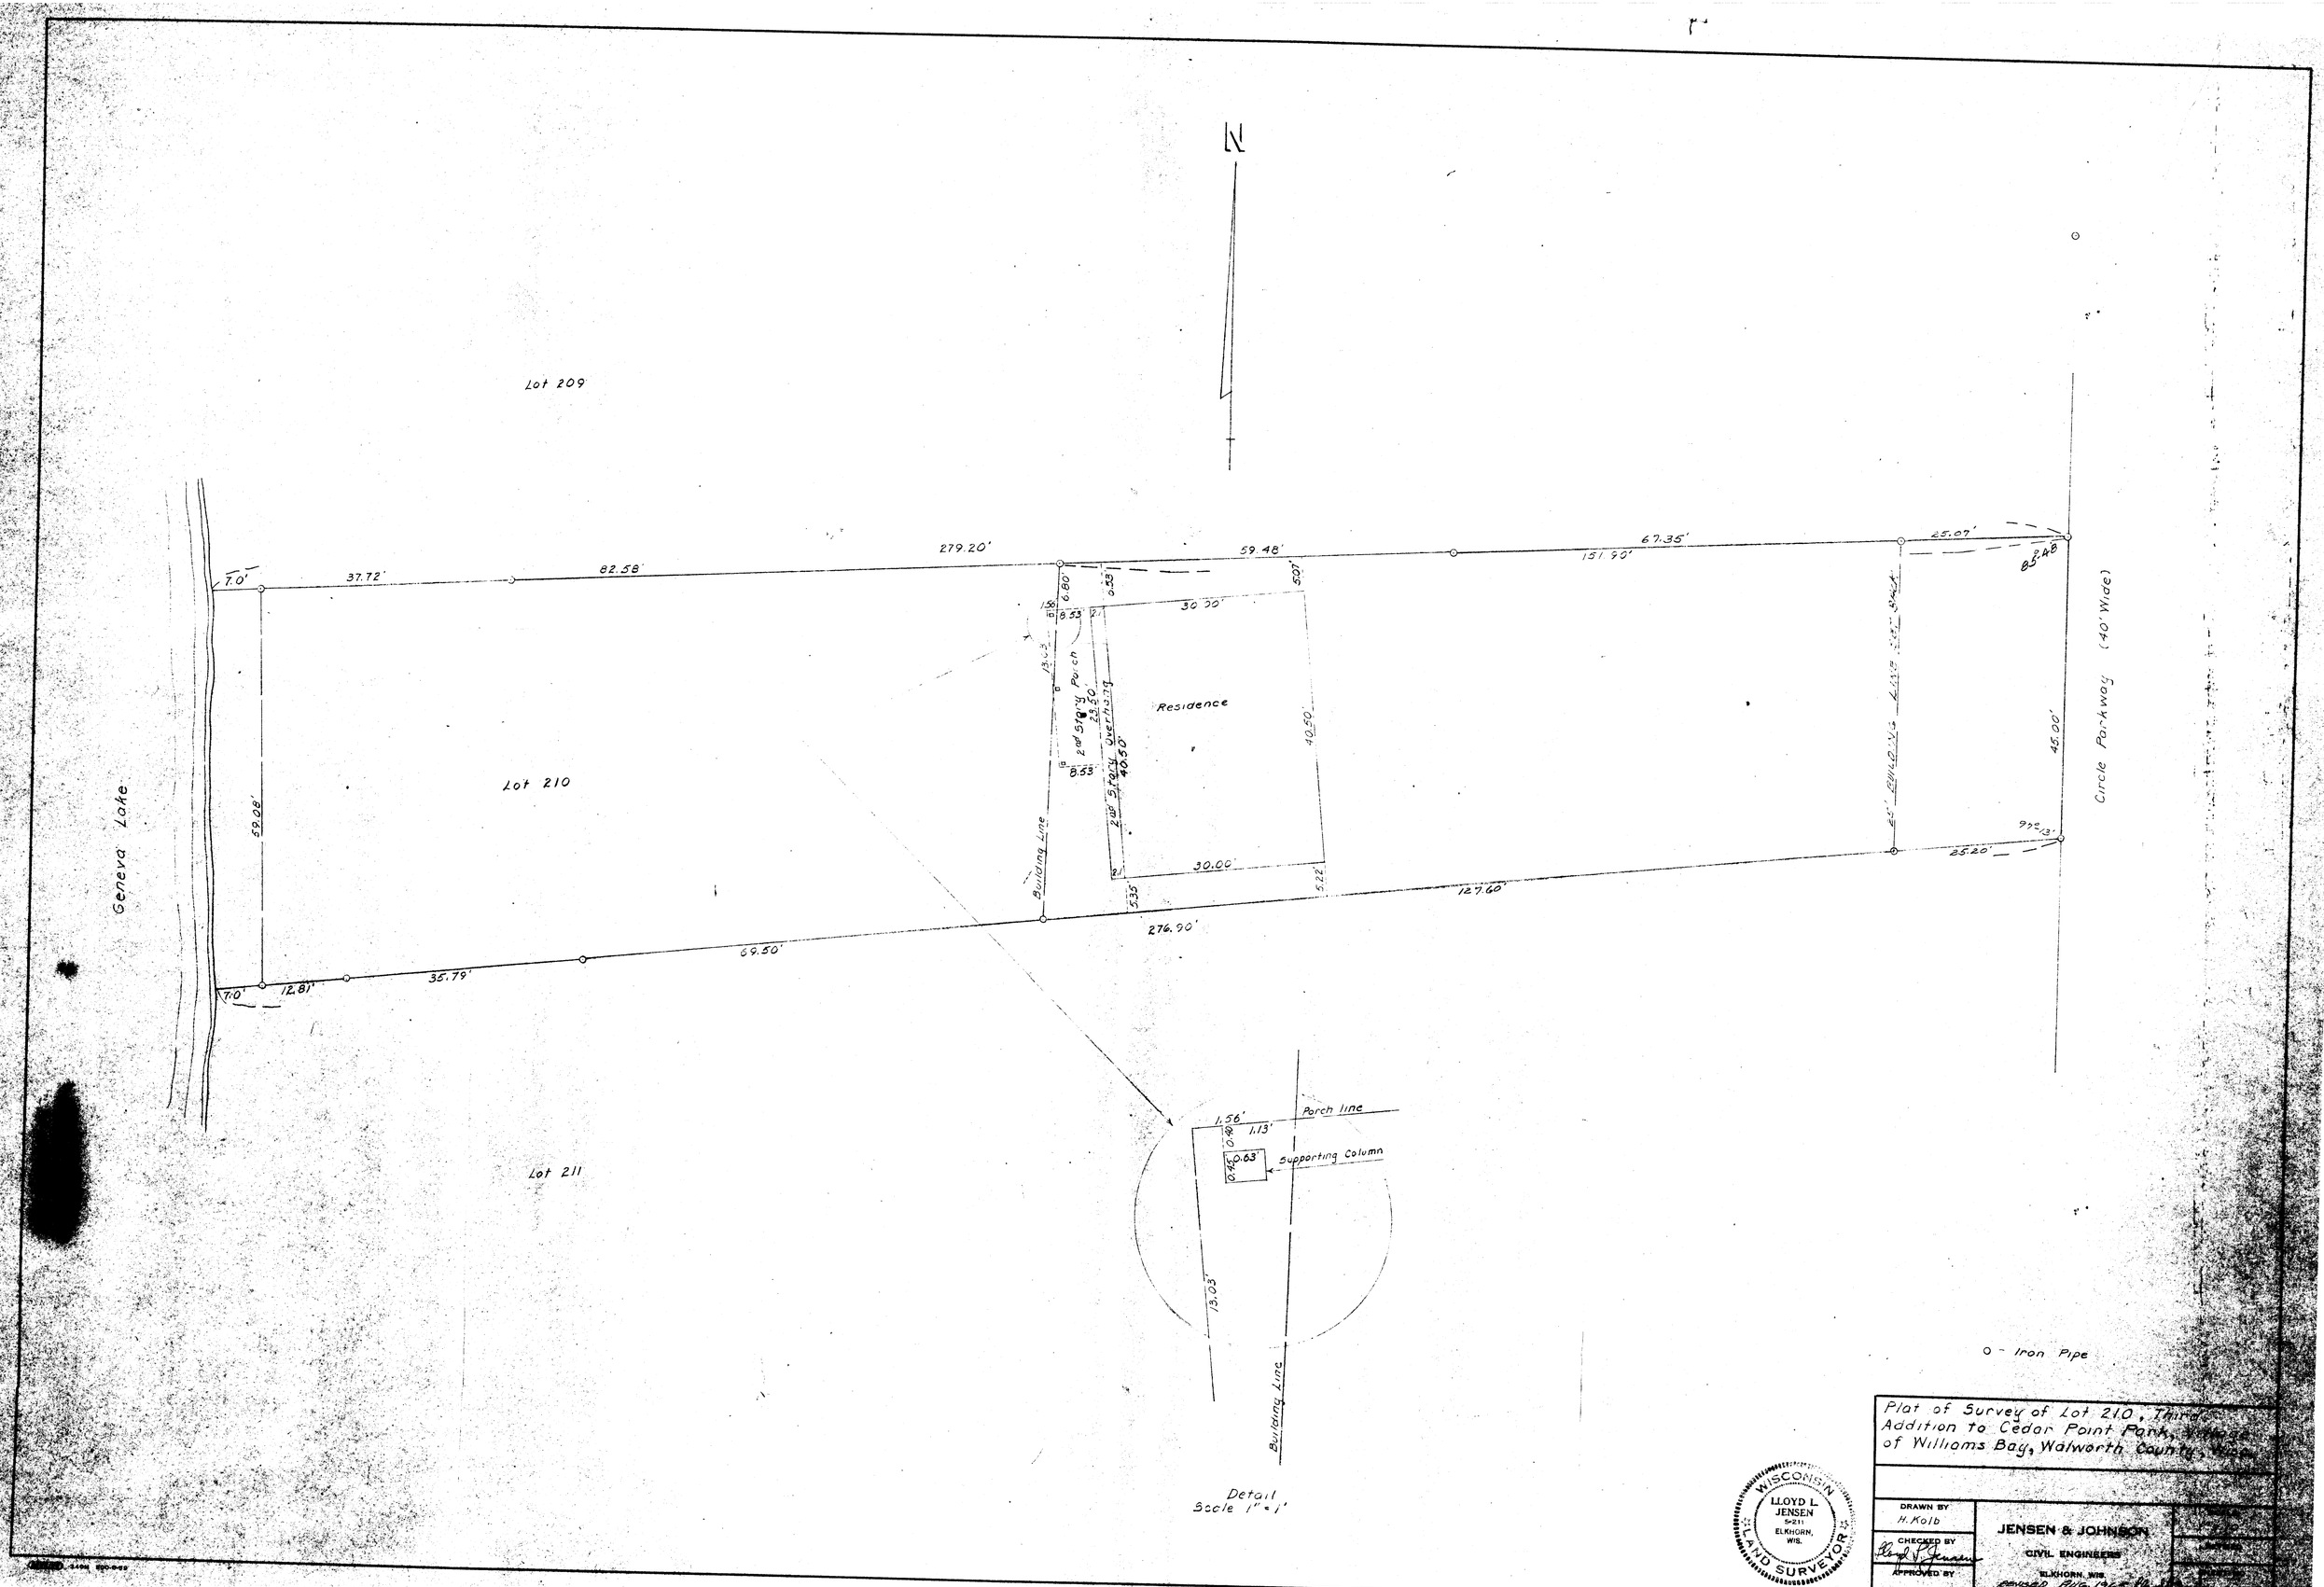
N
Lot 209
Lot 210
Lot 211
Geneva Lake
Circle Parkway (40' Wide)
Residence
2nd Story Porch
2nd Story Overhang
Building Line
7.0'
37.72'
82.58'
279.20'
59.48'
151.90'
67.35'
25.07'
85.48'
30.00'
5.07'
40.50'
6.80'
0.53'
8.53'
22.50'
40.50'
30.00'
5.22'
5.35'
127.60'
276.90'
69.50'
35.79'
12.81'
7.0'
59.08'
45.00'
9°20'13"
Porch line
1.56'
1.13'
0.80'
0.63'
Supporting Column
13.03'
Building Line
Detail
Scale 1" = 1'
O - Iron Pipe
WISCONSIN
LLOYD L. JENSEN
S-211
ELKHORN, WIS.
LAND SURVEYOR
Plat of Survey of Lot 210, Third Addition to Cedar Point Park, Village of Williams Bay, Walworth County, Wisc.
DRAWN BY
H. Kolb
CHECKED BY
APPROVED BY
JENSEN & JOHNSON
CIVIL ENGINEERS
ELKHORN, WIS.
DATE August, 1961