


PLAT OF SURVEY

OF

N $\frac{1}{2}$ LOT 234 AND LOT 235 EXCEPT THE NORTH 2 $\frac{1}{2}$ FEET THEREOF OF THE THIRD ADDITION TO CEDAR POINT PARK, VILLAGE OF WILLIAMS BAY, WALWORTH COUNTY WISCONSIN.

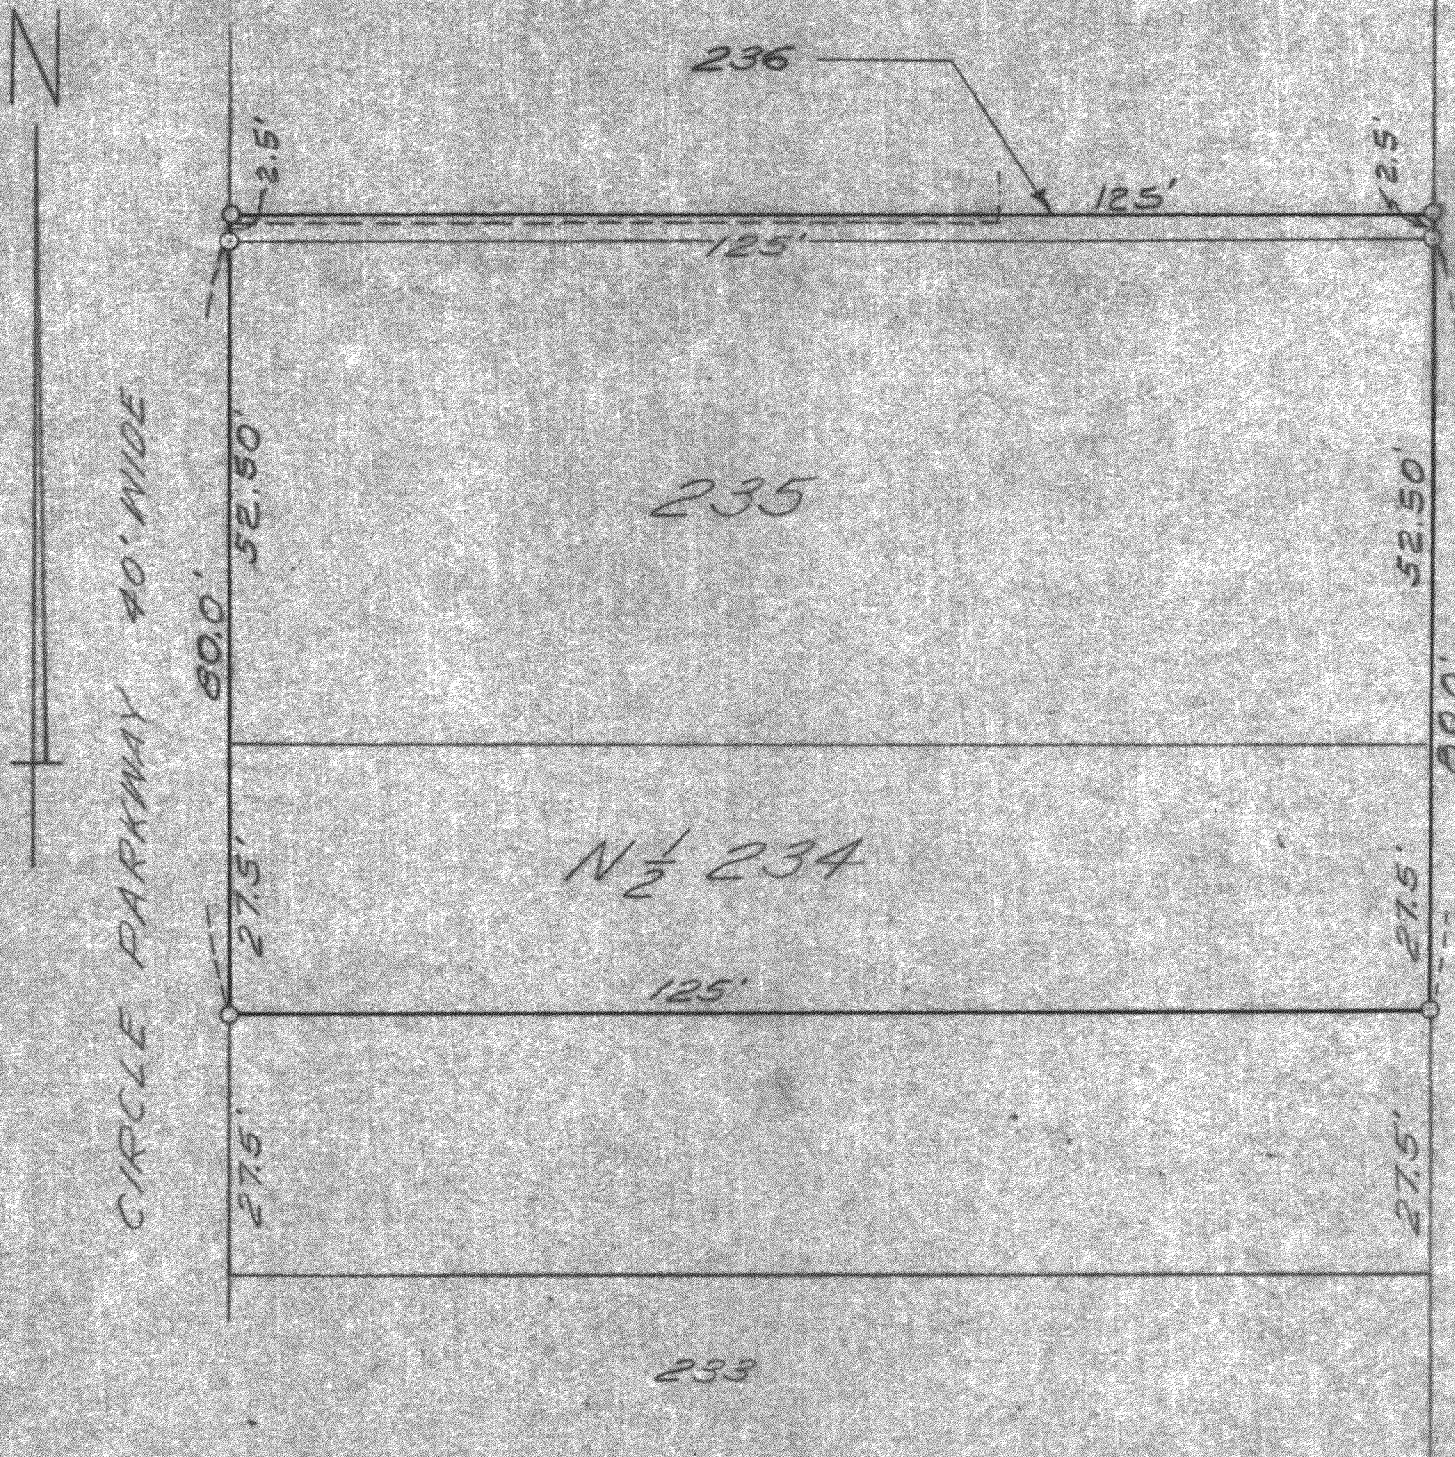

SURVEY AND PLAT BY
JENSEN & JOHNSON
 CIVIL ENGINEERS AND SURVEYORS
 Elkhorn, Wisconsin

LEGEND

- — Iron Pipe
 - — Concrete Monument
- Scale 1" = 20'

WE CERTIFY: That we have surveyed the above described property and that the plat shown hereon is an accurate survey and a true representation thereof and correctly shows the exterior boundary lines and all divisions of said property.

Date *MAY 1968*
 REVISED MAY 1970

Lloyd L. Jensen
 LLOYD L. JENSEN, Partner
 Wisconsin Registered Land Surveyor, No. S-211

WCP 330