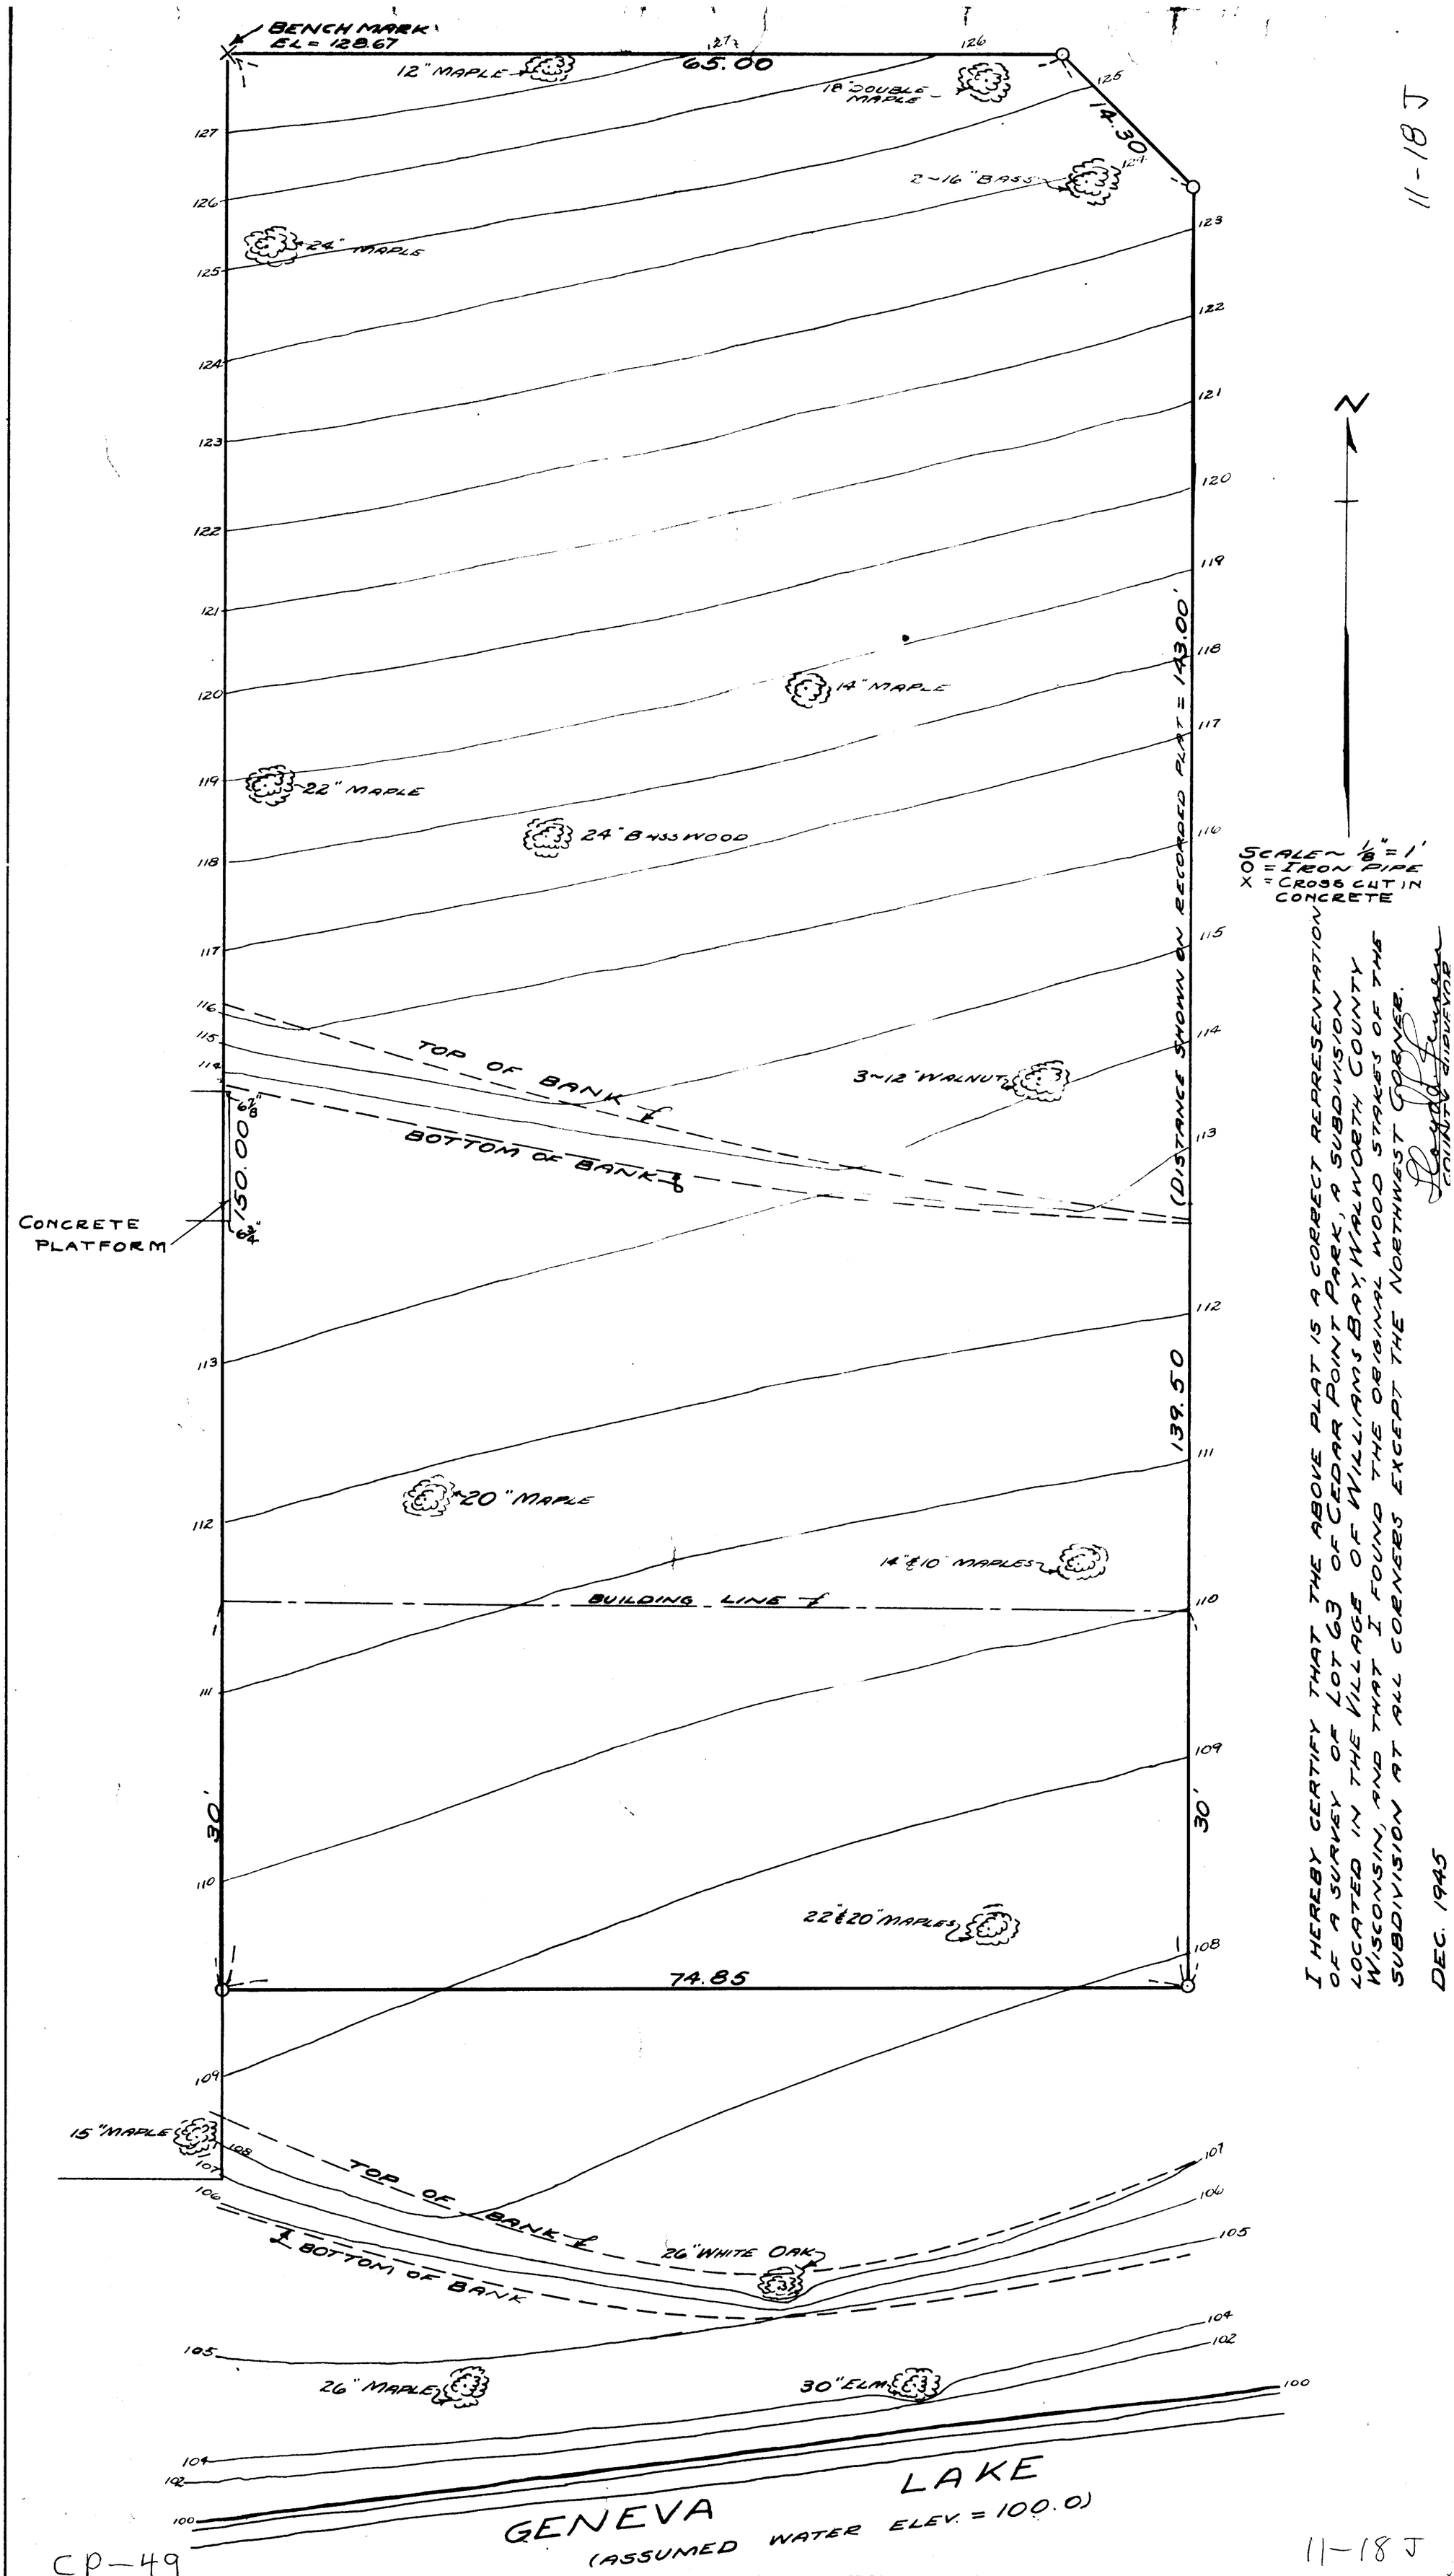

I HEREBY CERTIFY THAT THE ABOVE PLAT IS A CORRECT REPRESENTATION OF A SURVEY OF LOT 63 OF CEDAR POINT PARK, A SUBDIVISION LOCATED IN THE VILLAGE OF WILLIAMS BAY, WALWORTH COUNTY WISCONSIN, AND THAT I FOUND THE ORIGINAL WOOD STAKES OF THE SUBDIVISION AT ALL CORNERS EXCEPT THE NORTHWEST CORNER.

DEC. 1945

11-18 J

CP-49

11-18 J