
PLAT OF SURVEY

OF

LOTS 1 & 4 - BLOCK 11 WILLIAMS 2ND ADDITION TO THE VILLAGE OF WILLIAMS BAY WALWORTH COUNTY, WISCONSIN.

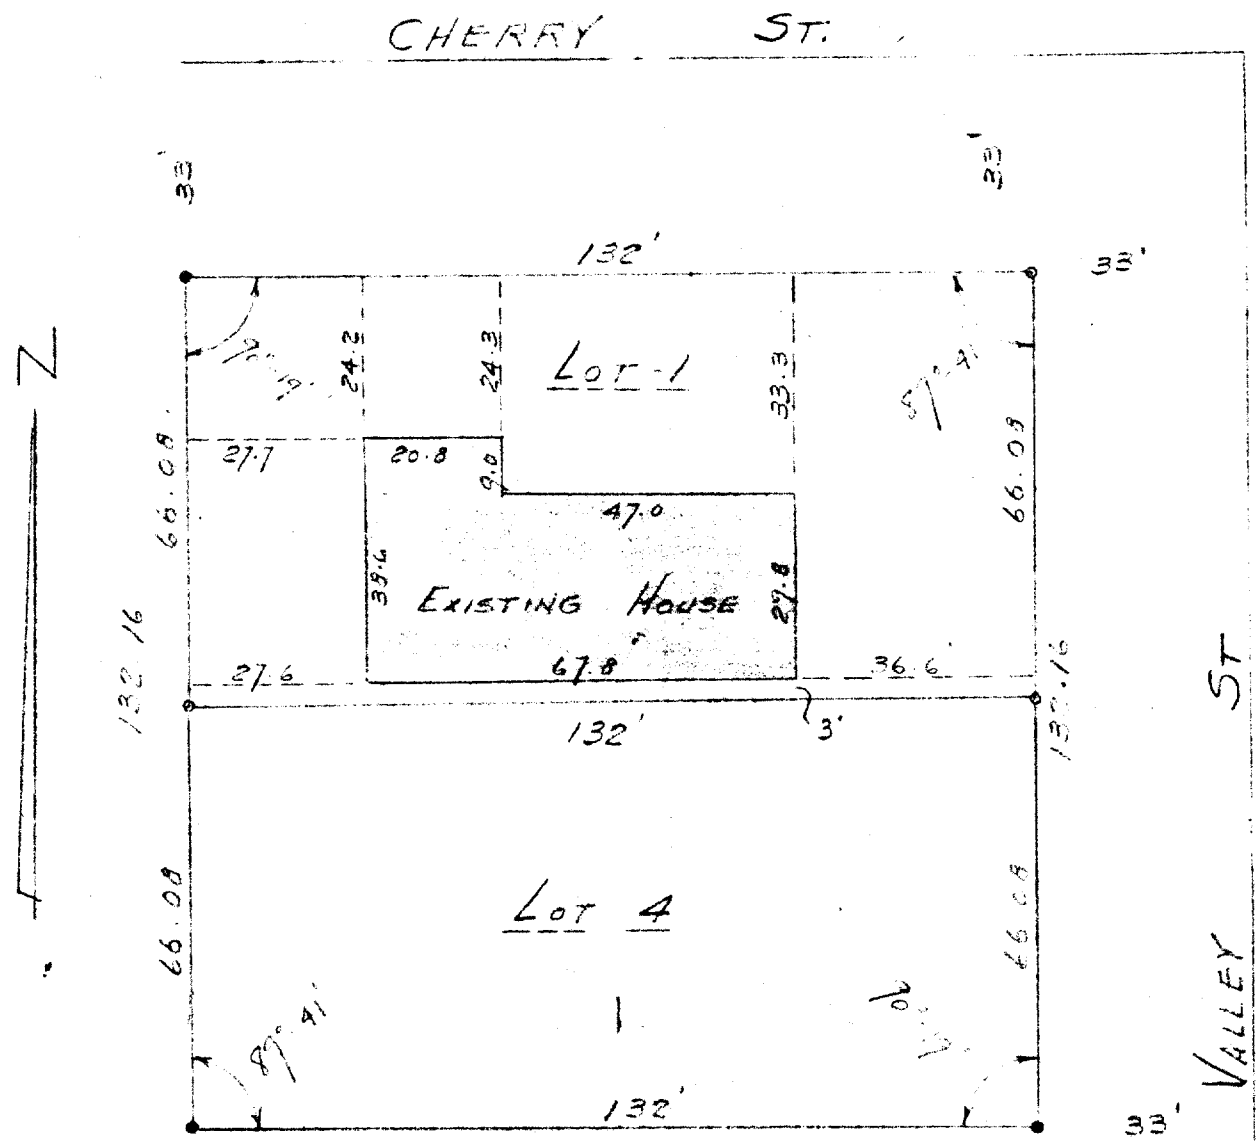

SURVEY AND PLAT BY

JENSEN & JOHNSON

CIVIL ENGINEERS AND SURVEYORS

Elkhorn, Wisconsin

LEGEND

o — Iron Pipe

● — Concrete Monument

Scale 1" = 30'

WE CERTIFY: That we have surveyed the above described property and that the plat shown hereon is an accurate survey and a true representation thereof and correctly shows the exterior boundary lines and all divisions of said property.

Date Oct. 1964

Lloyd L Jensen

LLOYD L. JENSEN, Partner

Wisconsin Registered Land Surveyor, No. S-211

061-11

Loop-154

NO. 1/5H—400—1-30-58

11-1907