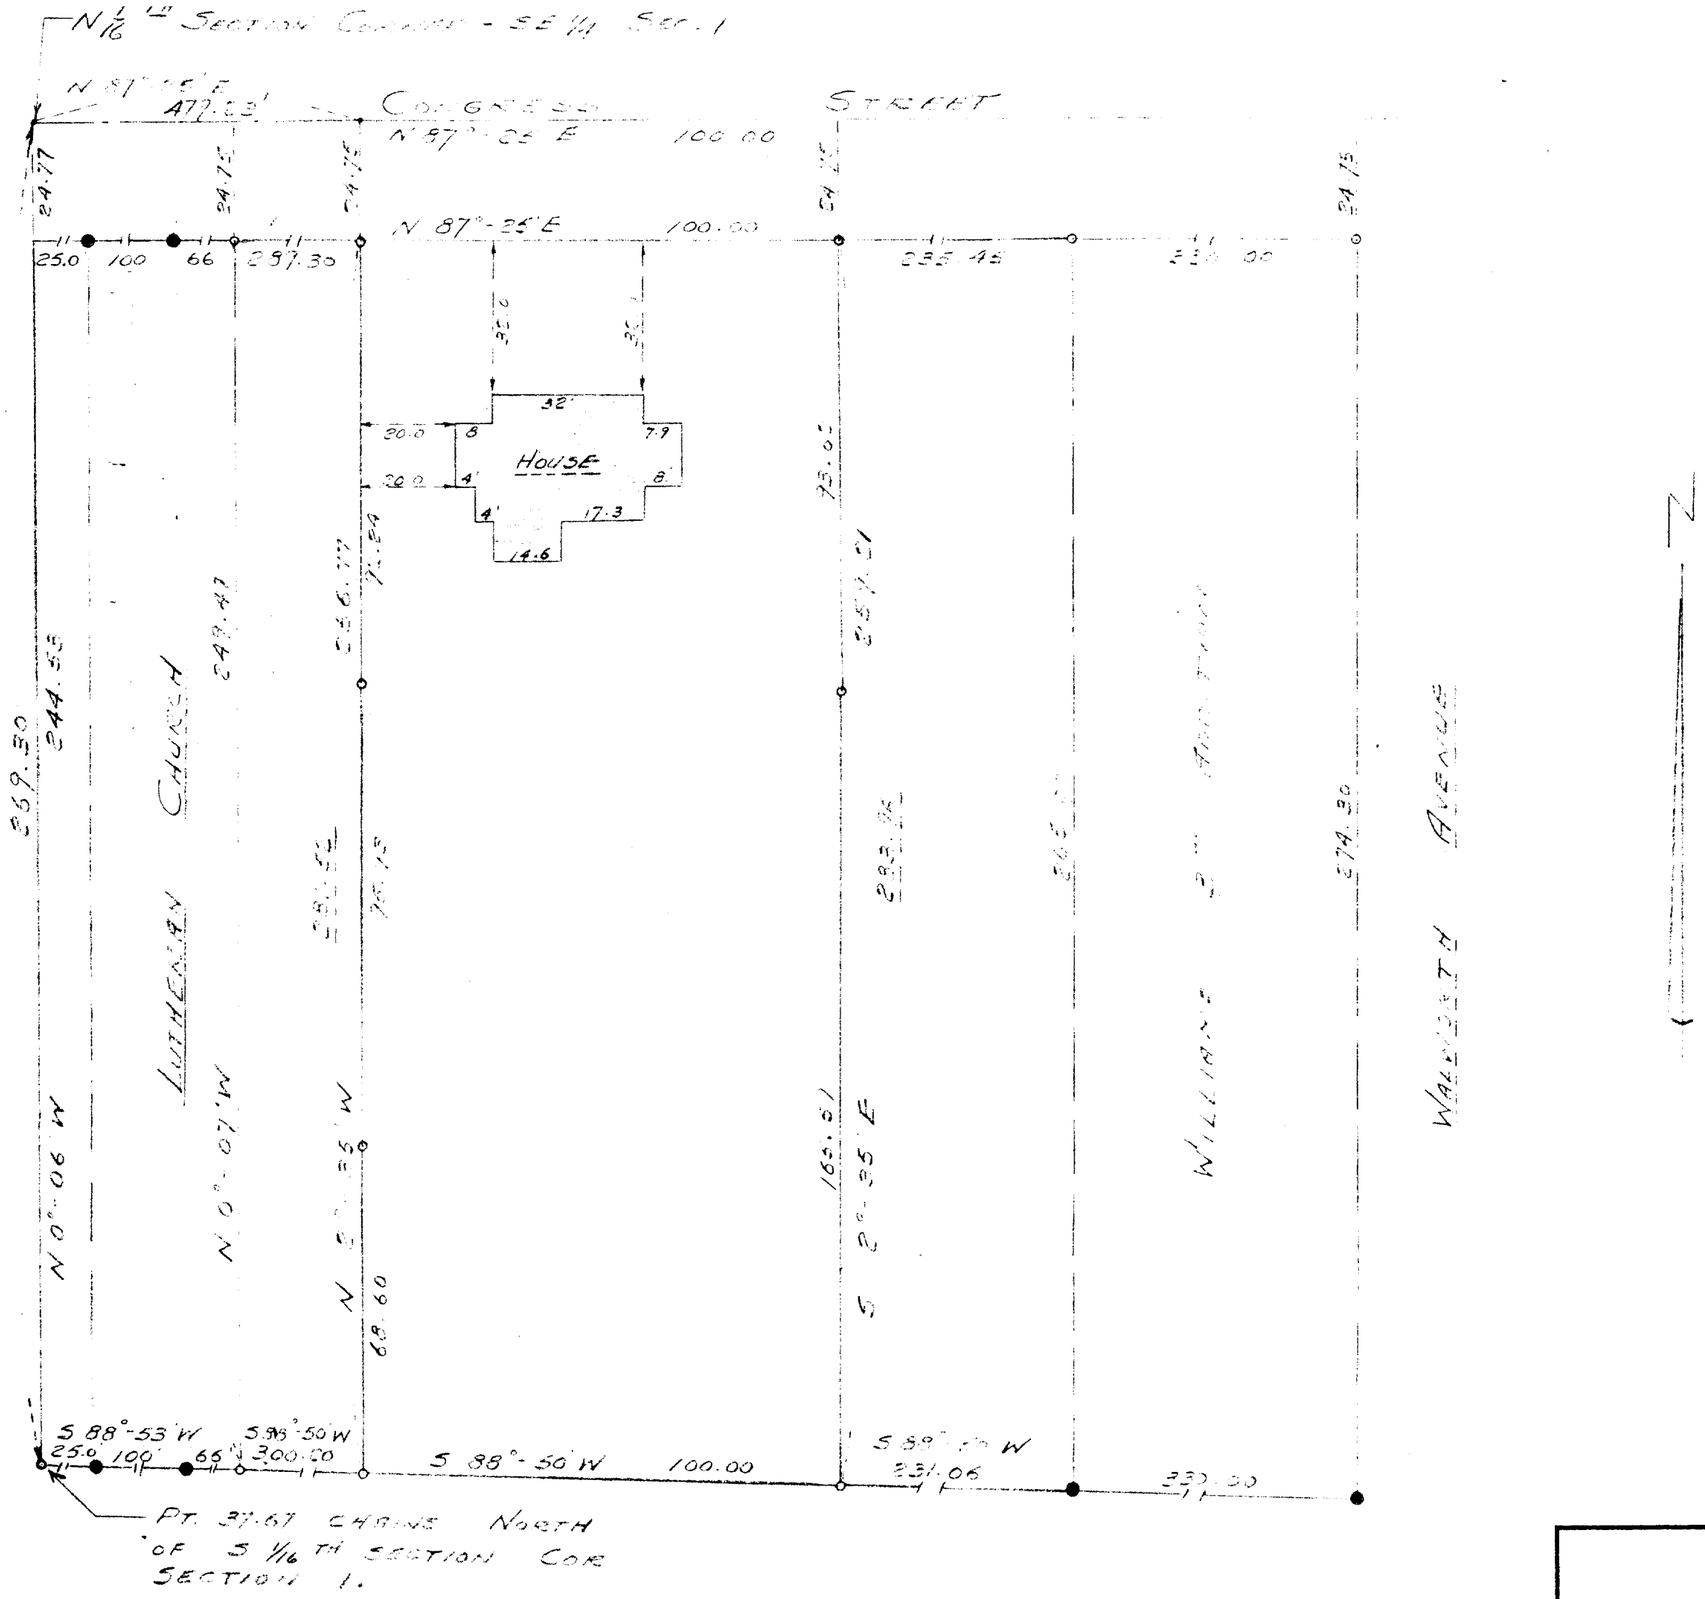

PLAT OF SURVEY
OF

E½ SE¼ Section 1, T 1 N, R 16 E
Walworth County, Wisconsin.

SURVEYOR

SCALE 1" = 30'

DATE Dec. 22, 1964

UP-51 B

11-195