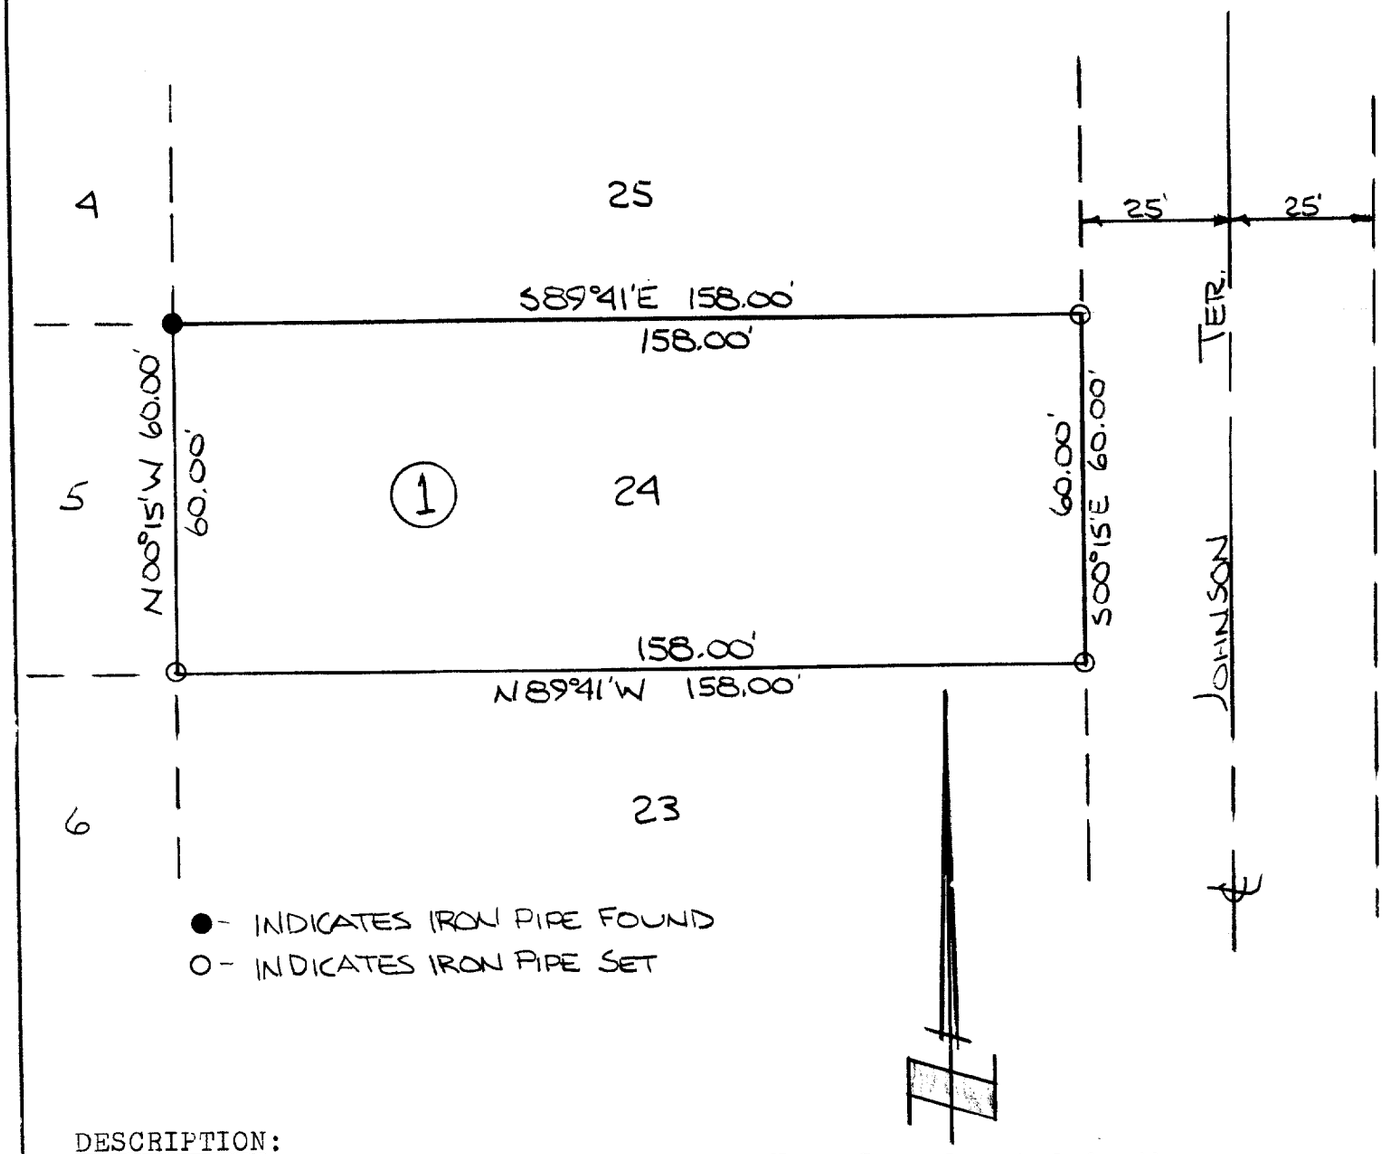


DESCRIPTION:
Lot 24 of Block 1 of Harbor View Sub. located in the NE¼ of Section 6, T1N, R17E, in the Village of Williams Bay, Walworth County, Wisconsin.

CERTIFICATE:
I, Joseph M. Biagi, surveyor, do hereby certify that I have surveyed the property hereon described.

DATE:
January 12, 1973

Joseph M. Biagi RLS #12
Elkhorn, Wisconsin

W HV-19A

11-1B