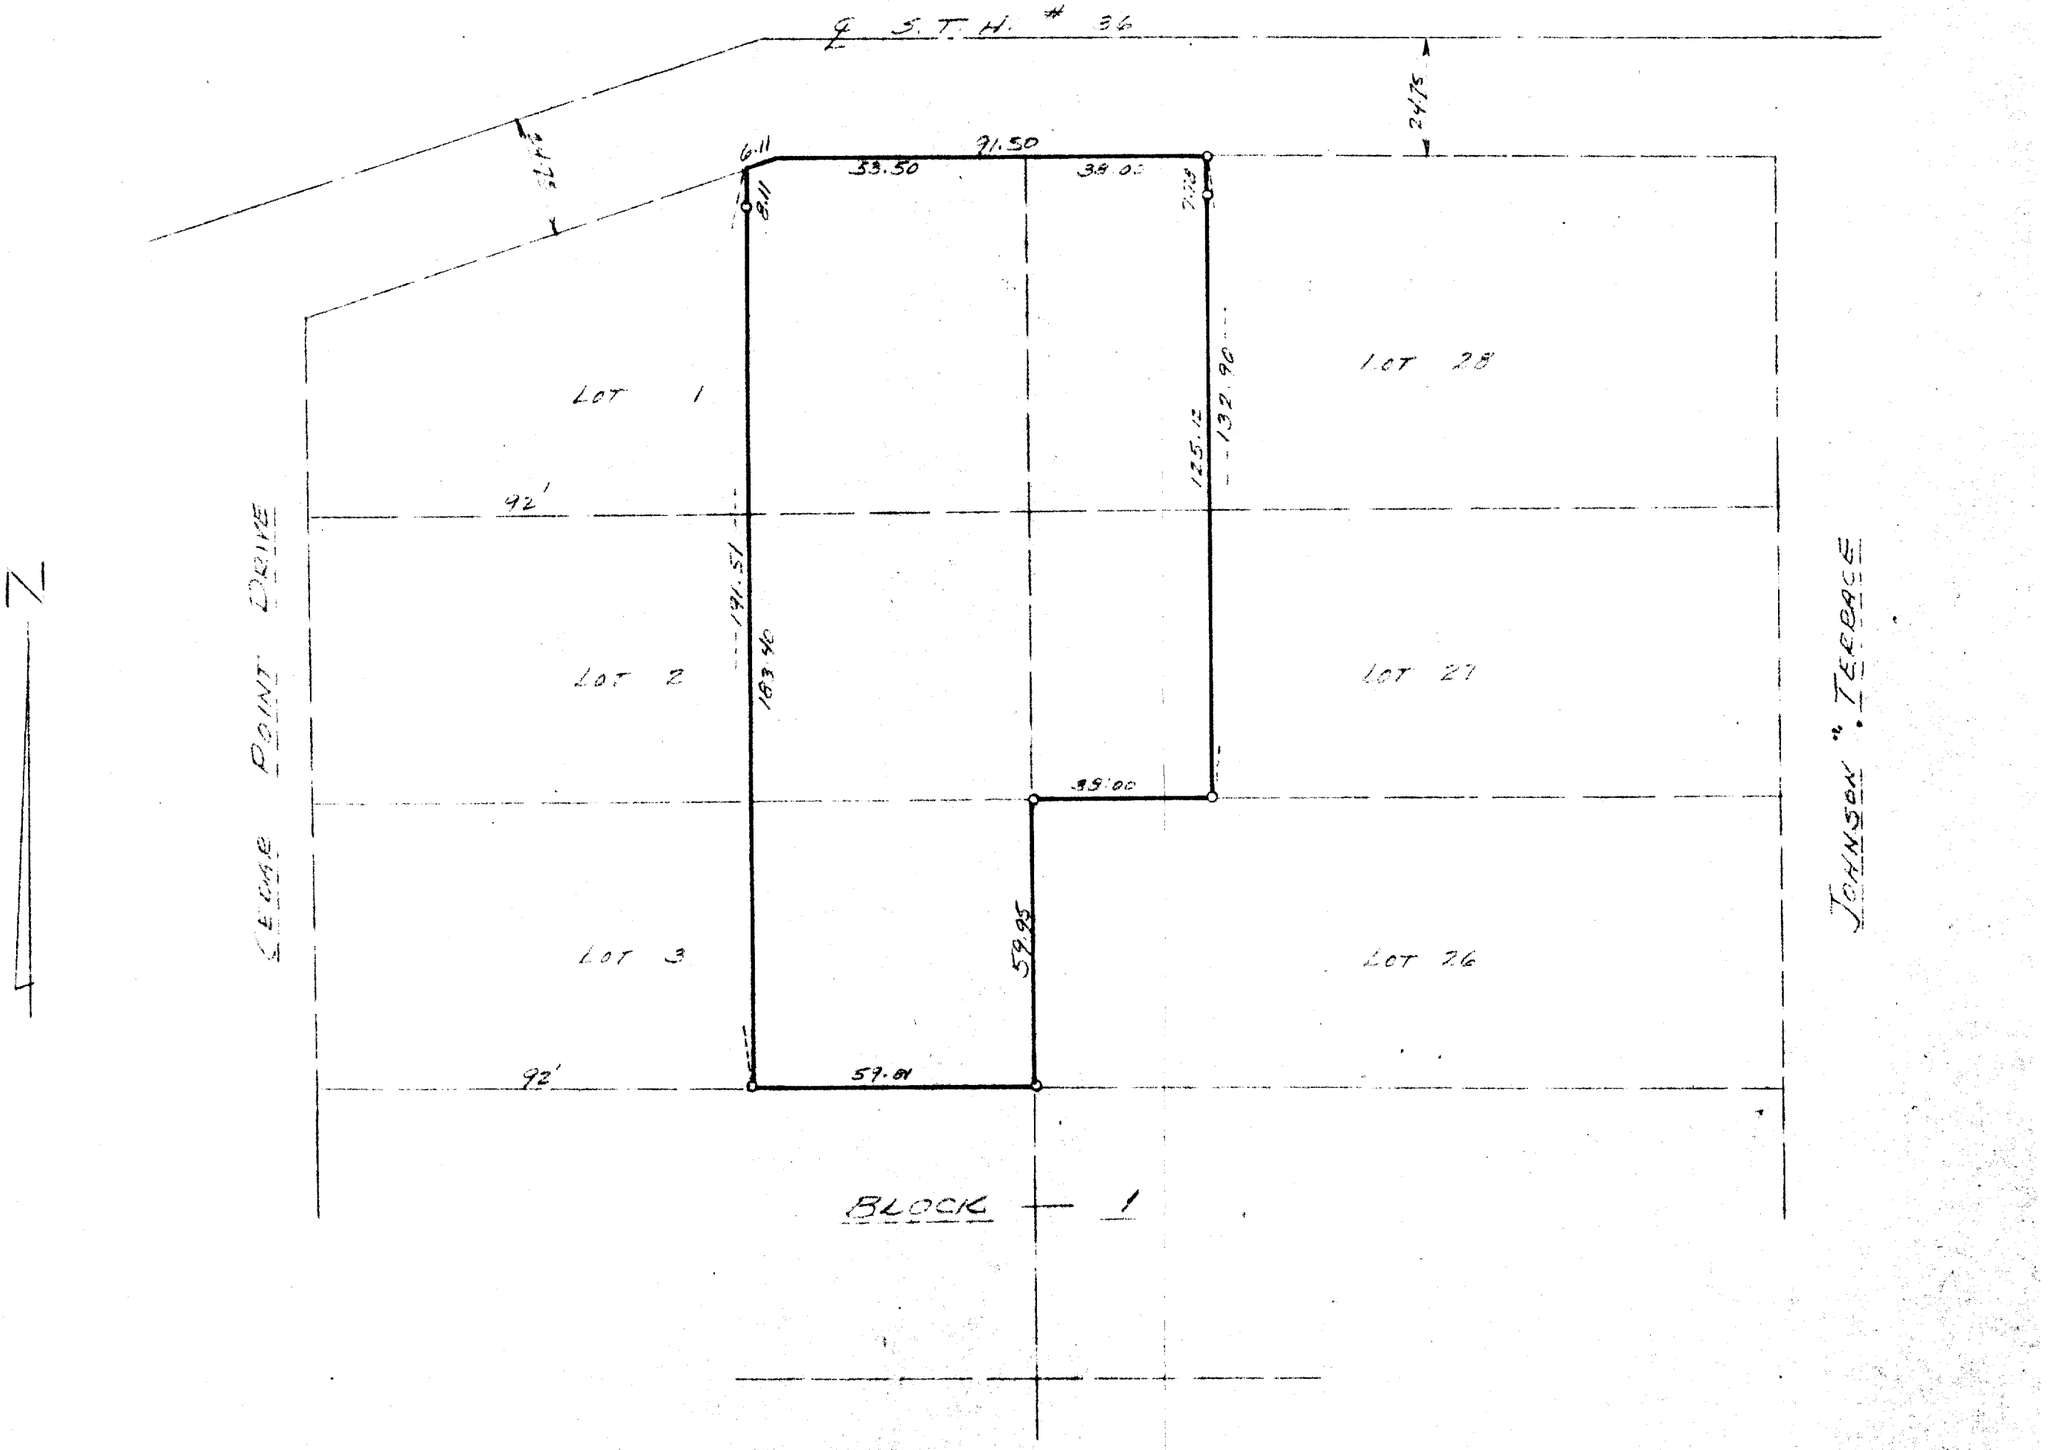


PLAT OF SURVEY
OF

LOTS 1-2-3 EXCEPT THE WEST 92' AND THE WEST 38' LOTS 27-28 BLOCK 1 HARBOR VIEW SUBDIVISION WILLIAMS BAY, WISCONSIN.

Lloyd L Jensen
SURVEYOR

SCALE 1" = 30'

DATE AUGUST 1967

WISCONSIN LLOYD L. JENSEN S-211 ELKHORN, WIS. REGISTERED LAND SURVEYOR

11-207

HV-1 and HV-17