PREPARED FOR:
BEAA SHEEHAN
KEEFE REAL ESTATE, INC.
P.O. BOX 460
LAKE GENEVA, WI 53147


PLAT OF SURVEY

-OF-

THE NORTHWEST 1/4 OF LOT 10 IN OBSERVATORY SUBDIVISION, IN THE VILLAGE OF WILLIAMS BAY, WALWORTH COUNTY, WISCONSIN.

PATHFINDER SURVEYING, INC.
W2888 KRUEGER ROAD UNIT "D"
LAKE GENEVA, WI 53147
(262) 248-3697

RECEIVED
OCT - 9 2007
BMF

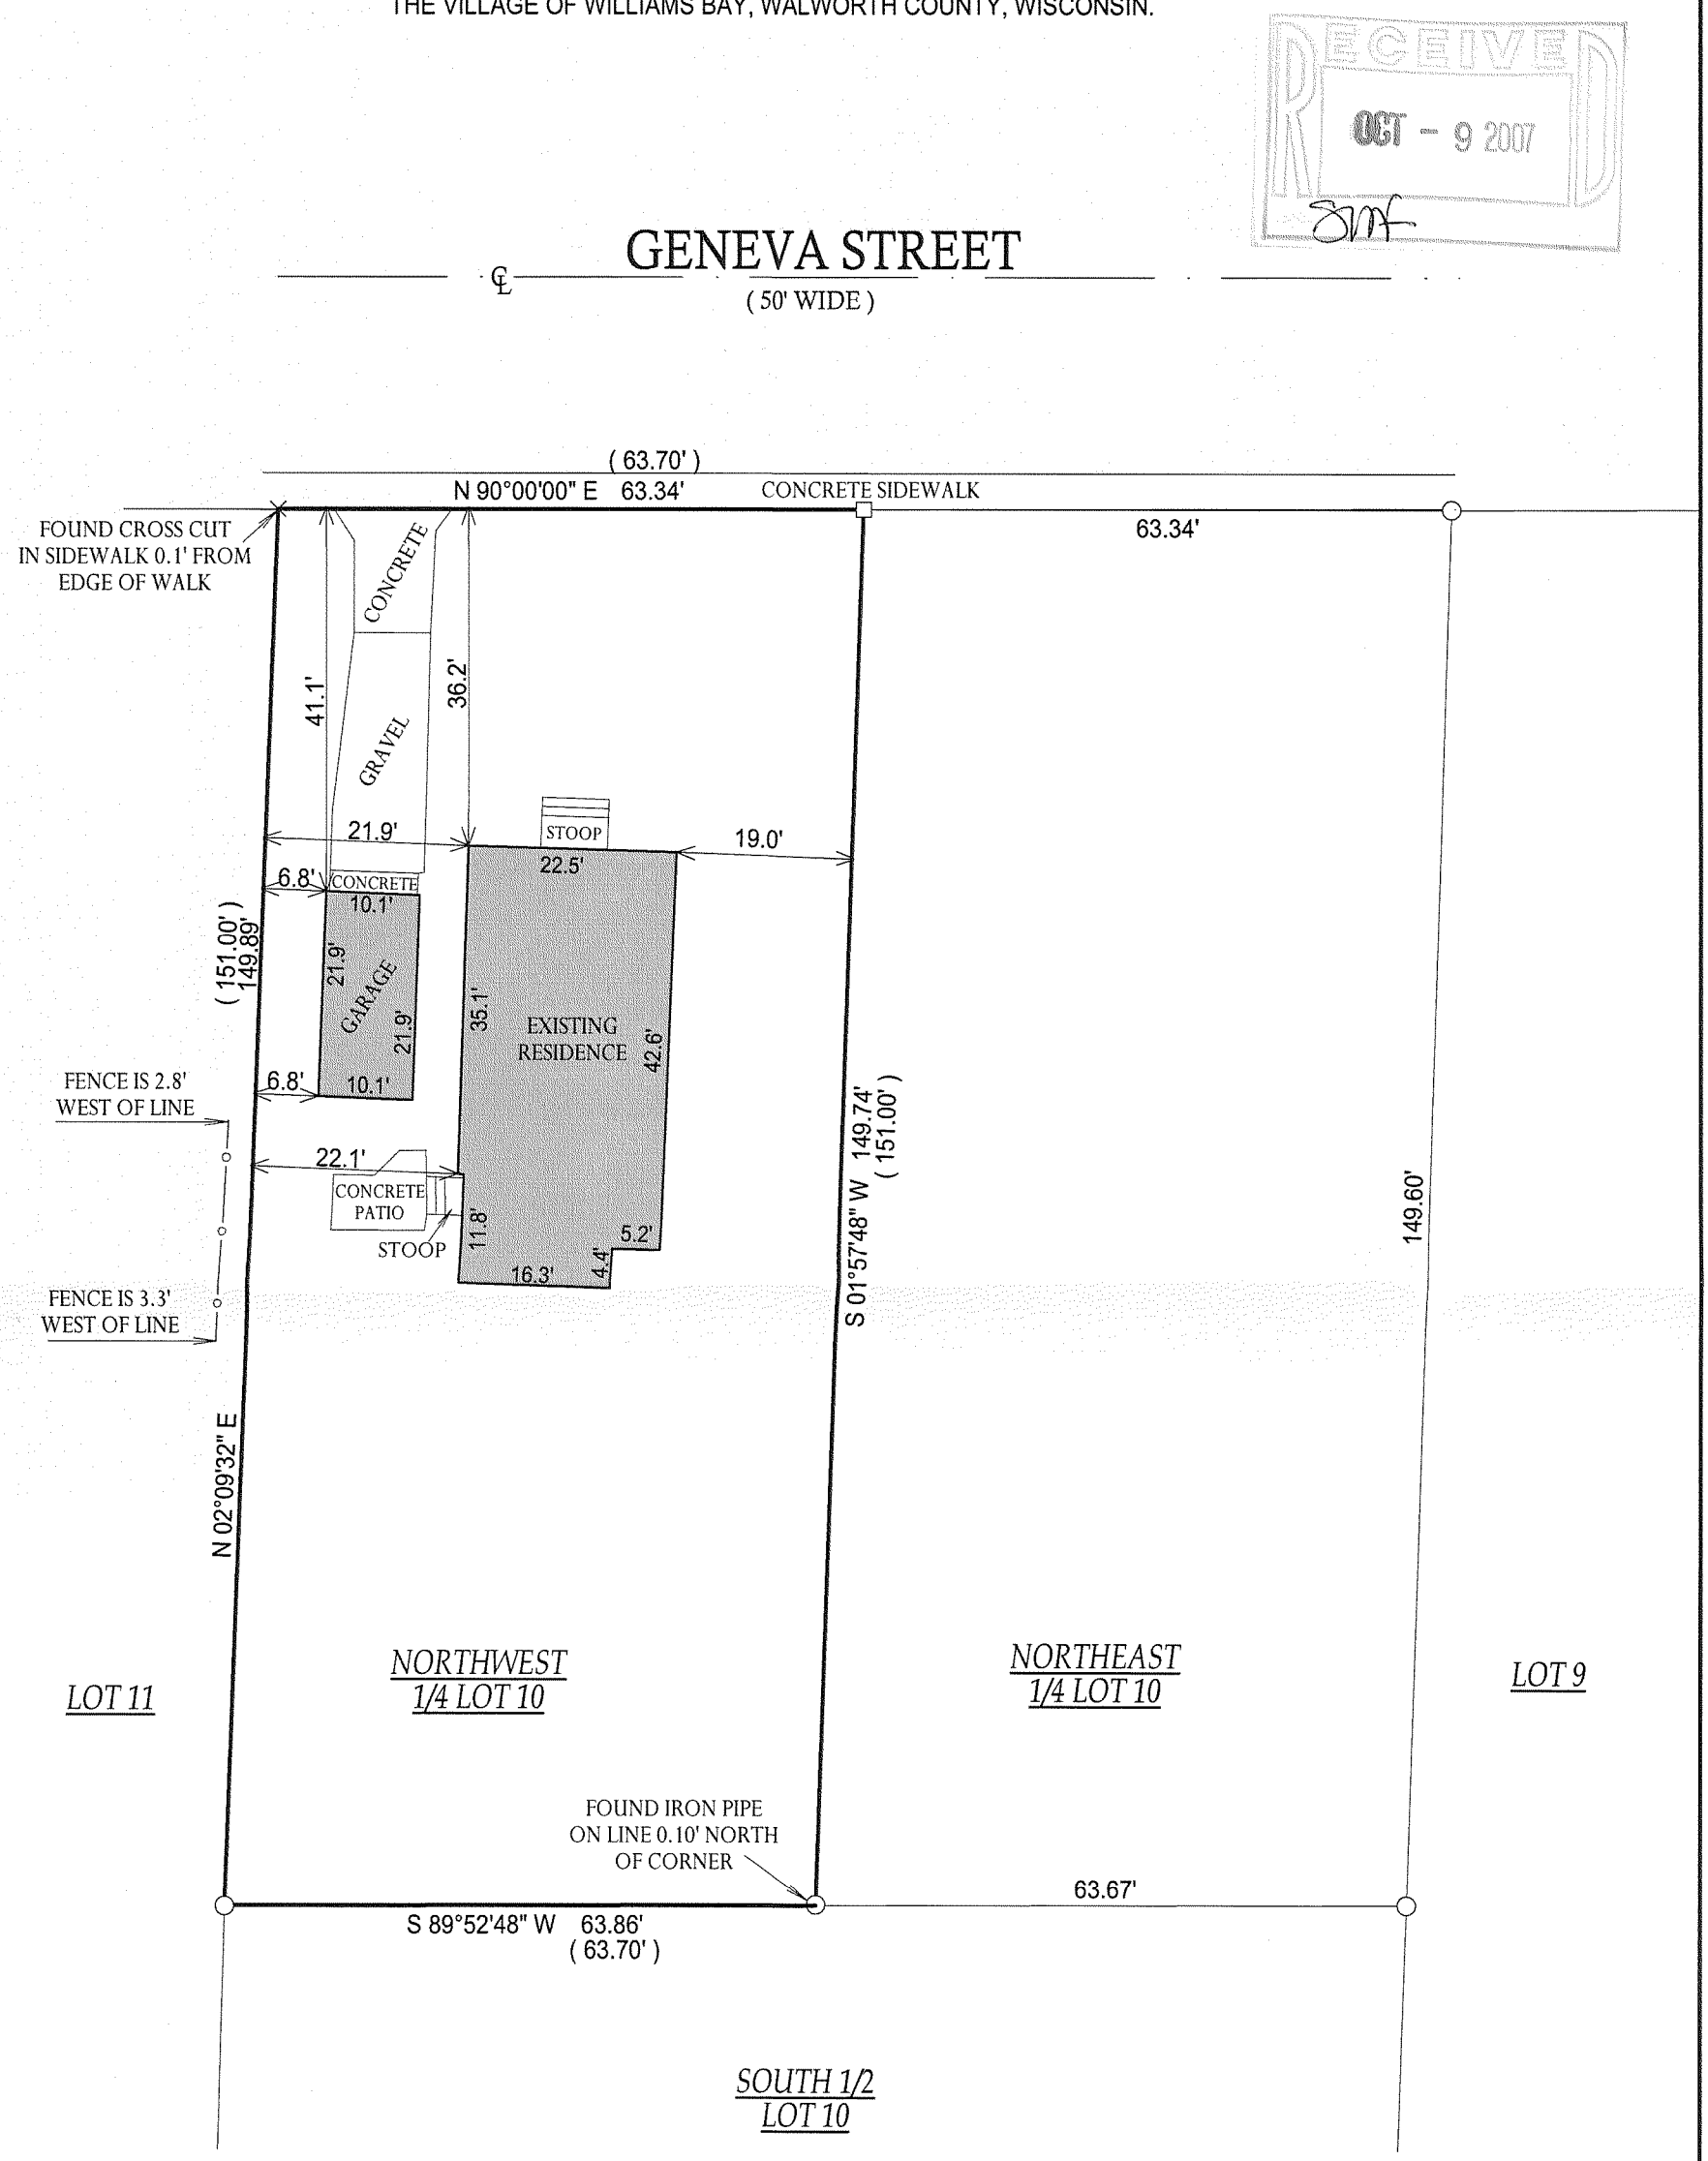

( ) = RECORDED AS

□ *= FOUND IRON BAR*

○ *= FOUND IRON PIPE*

● *= SET IRON PIPE*

■ *= SET IRON BAR*

SCALE: 1" = 20'

JOB #: 06-360UD

TAX ID #: WOB 00021

NOTE: BASIS OF BEARING IS, GENEVA STREET ASSUMED EAST-WEST.

COMPARE LEGAL DESCRIPTION ABOVE AND DRAWING WITH DEED. FOR BUILDING RESTRICTIONS AND EASEMENTS NOT SHOWN,REFER TO DEED, ABSTRACT SOURCES AND LOCAL MUNICIPAL CODES. NOTIFY THE SURVEYOR IMMEDIATELY OF ANY DISCREPANCY.

"I hereby certify that the above described property was surveyed under my supervision and that the above map, to the best of my knowledge and belief, is a true representation thereof and shows the size and location of all visible structures, apparent easements and encroachments if any." This survey is made for the present owners of the property, and those who purchase, mortgage, or guarantee the title thereto, within one year from the date hereof.

WISCONSIN
JEFFREY L. KIMPS
2436
LAKE GENEVA. WIS.
LAND SURVEYOR

JEFFREY L KIMPS S - 2436
Wisconsin Registered Land Surveyor
(original if signed in red)

REVISED: AUGUST 29th, 2007 (UPDATE)
DATED THE 3rd DAY OF AUGUST, 2006.

01 - 2167