
PLAT OF SURVEY

OF

LOTS 2 & 3 BLOCK 8 WILLIAMS 1ST ADDITION, EXCEPT THE WEST 47.63 FEET, LOCATED IN THE VILLAGE OF WILLIAMS BAY, WALWORTH COUNTY, WISCONSIN.

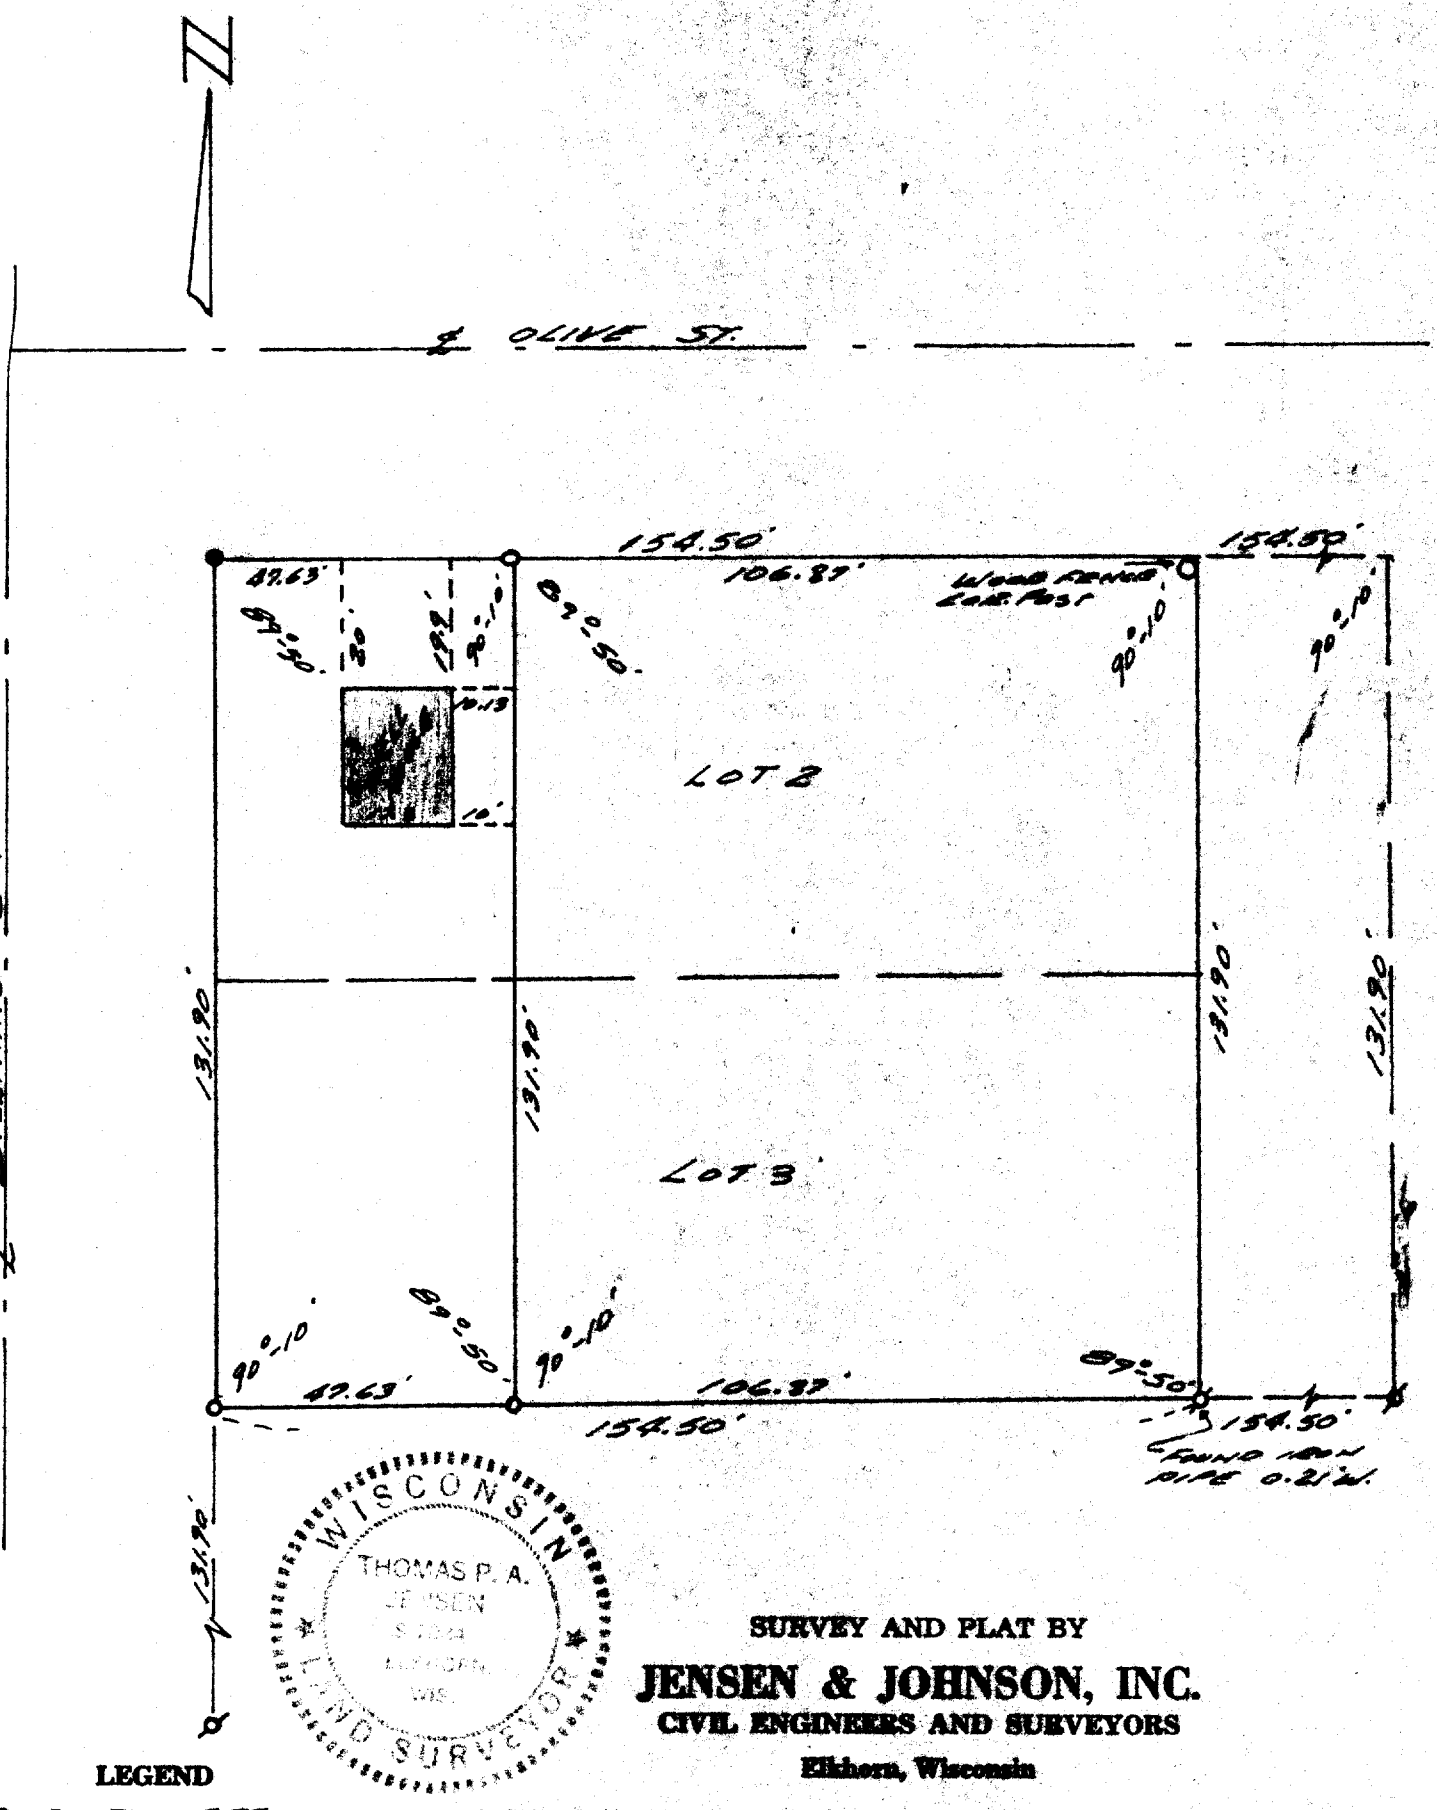

SURVEY AND PLAT BY

JENSEN & JOHNSON, INC.

CIVIL ENGINEERS AND SURVEYORS

Elkhorn, Wisconsin

LEGEND

- O — Iron Pipe SET
- ● — Concrete Monument FOUND

Scale 1" = 30

⌀ — IRON PIPE FOUND

WE CERTIFY: That we have surveyed the above described property and that the plat shown hereon is an accurate survey and a true representation thereof and correctly shows the exterior boundary lines and all divisions of said property.

Date OCT. 1978 Thomas P.A. Jensen [redacted],

Wisconsin Registered Land Surveyor, No. [redacted] S-1084

WDP-108, 109

PMC 175H

11-827J