Plat of Survey

of

Lots 61 and 62 of Lackey Bothers' Subdivision of Williams Bay, Wisconsin,

located in Government Lot 1 and the Northeast 1/4 of the fractional Southeast 1/4 of Section 1, Town 1 North, Range 16 East, and Government Lot 4 of Section 6, Town 1 North, Range 17 East, Village of Williams Bay, Walworth County, Wisconsin.

Surveyed for: **Brookhaven Properties, Inc.**
1925 East Ridgewood Lane
Glenview, Illinois. 60025

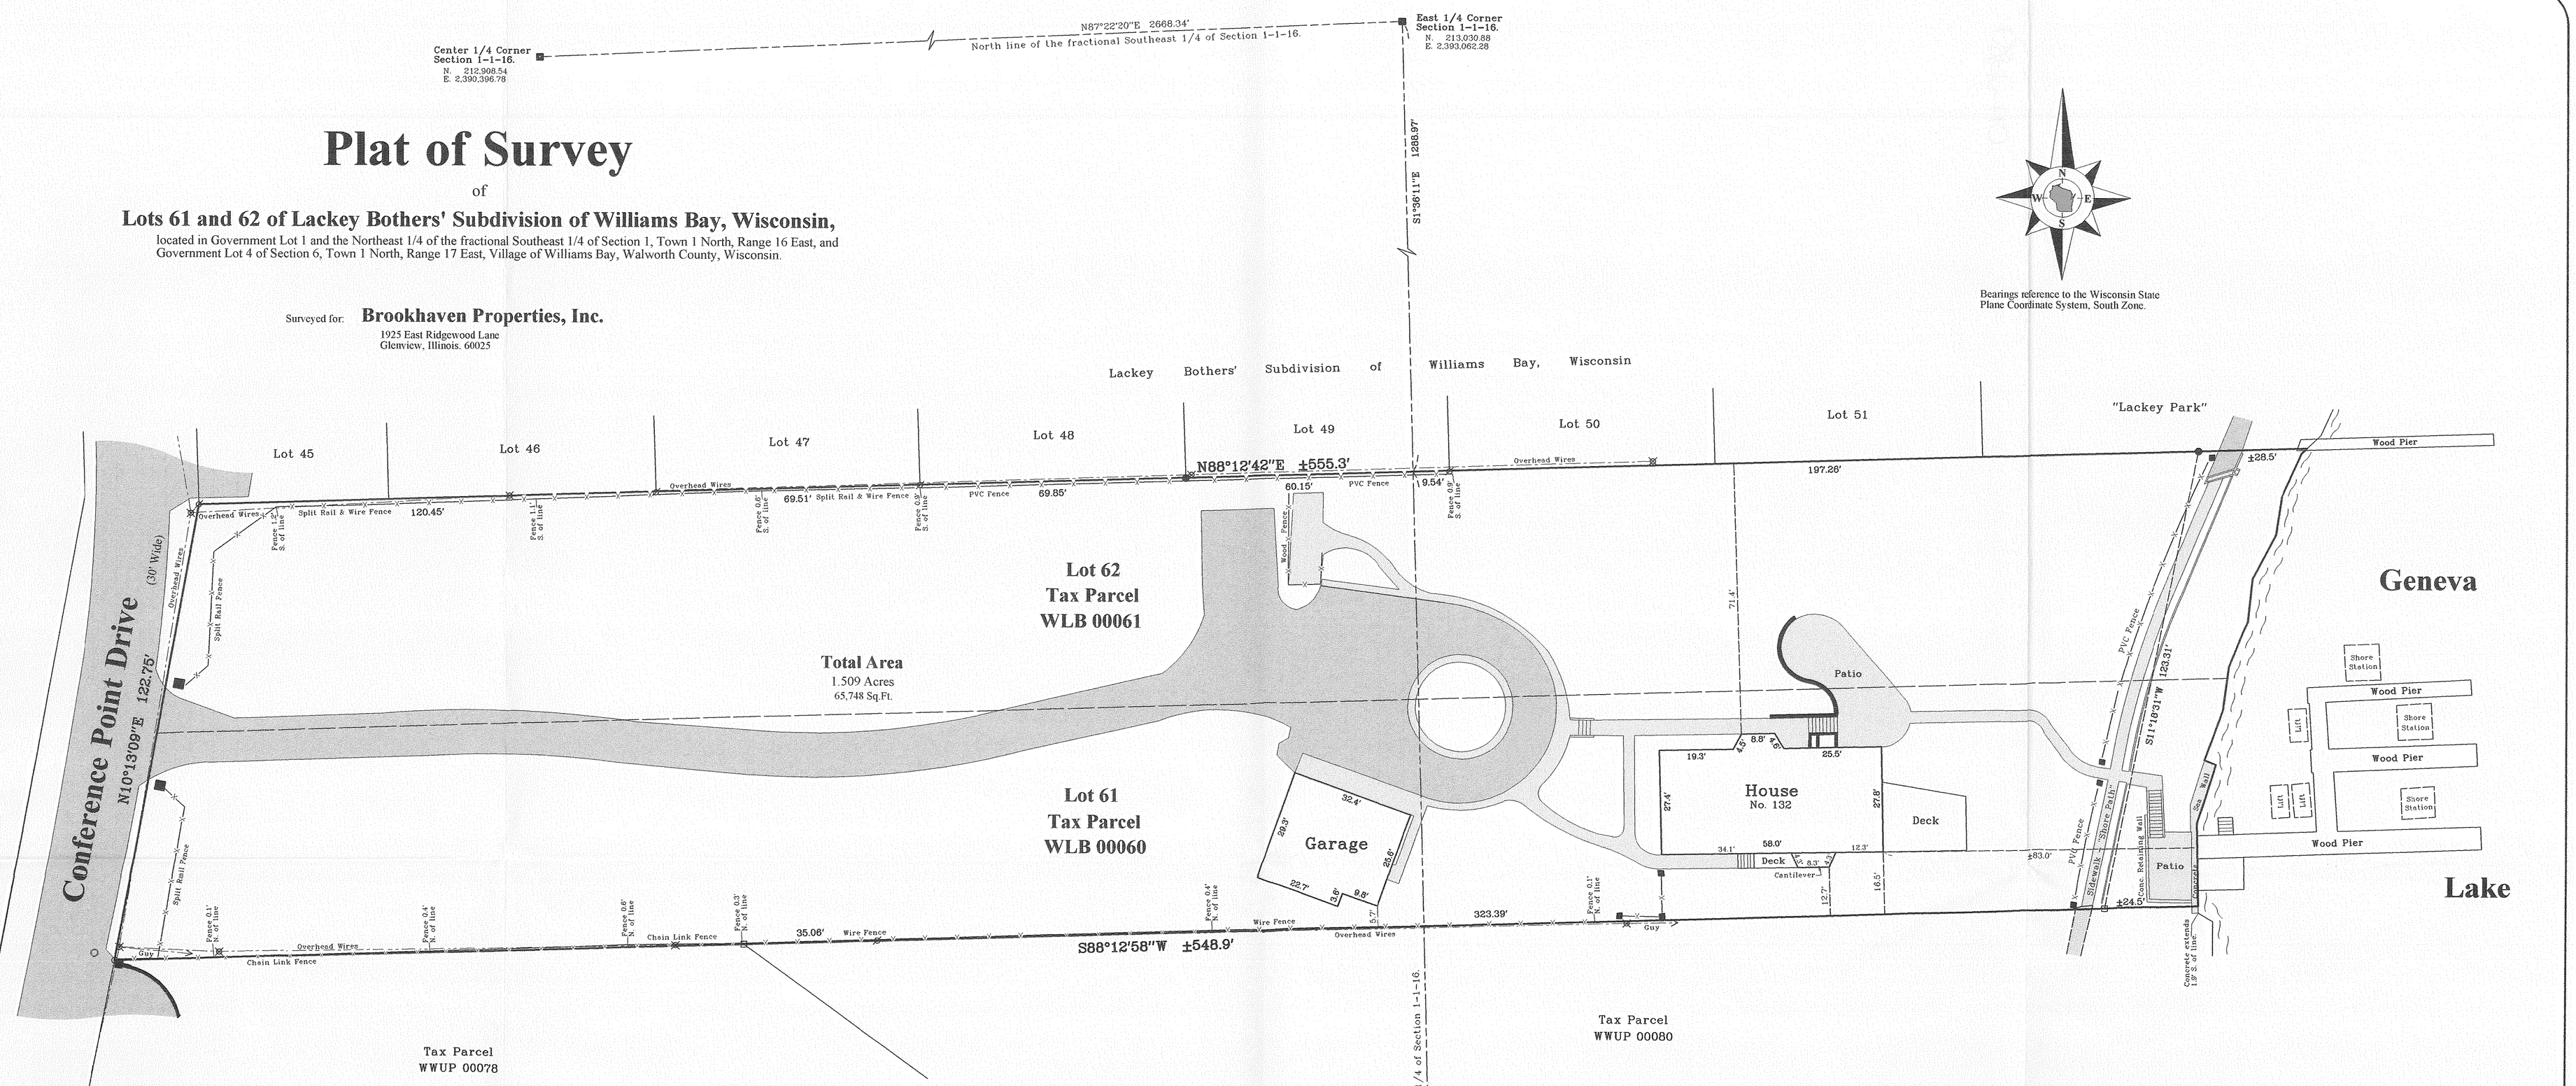

WISCONSIN
DOUGLAS G. OLSON
S-2093
ELKHORN, WI
LAND SURVEYOR
Not Valid Unless Stamped in Red.

Notes:

1) This survey plat is not certified unless signed and sealed in red ink.

2) This survey is subject to Wisconsin lien laws. This Plat of Survey is the notice of intent to file lien. Lien waiver required.

Copyright 2009 by Jensen & Olson Land Surveying, LLC.

All rights reserved. No part of this survey plat may be reproduced or transmitted in any form by any means - graphic, electronic, or mechanical, including photocopying, tracing, or information storage and retrieval systems - without permission in writing from Douglas G. Olson, Jensen & Olson Land Surveying, LLC.

I hereby certify that I have surveyed the above described property and the map hereon is correct to the best of my professional knowledge and belief and shows the size and location of the property, its exterior boundaries, the location and dimensions of all visible structures thereon, boundary fences, apparent easements and roadways and visible encroachments, if any.

This survey is made for the exclusive use of the present owners of the property, and also those who purchase, mortgage or guarantee title thereto, within one year from the date hereof.

Douglas G. Olson
Wisconsin Registered Land Surveyor - 2093

RECEIVED
OCT 15 2009
By SJK

WA-1251-1

011-22980

Survey date: June 1, 2009.
Revisions:

Scale in Feet
1" = 20'
0' 10' 20' 40' 60'

Jensen & Olson Land Surveying, LLC
45 South Wisconsin Street * P.O. Box 322 * Elkhorn, Wisconsin. 53121
Telephone: (262) 723-3434 * Facsimile: (262) 723-8044
Email: jensen.olson@elknet.net

Legend
- Found County Section Corner Monument
- Found Iron Pipe
- Found Iron Rod
- Found PK Nail
- Recorded Information
- Utility Pole
- Manhole
- Asphalt Surface
- Concrete Surface
- Brick Pillar or Stone Wall
- Gravel Surface

Sheet 1 of 1 Sheets

Drawing Name: (Jan file-2009030-2009030 Plat.dwg)

Job Reference Number
2009.030

2009.030