
PREPARED FOR
MARTIN LAW OFFICES
547 CENTER ST.
LAKE GENEVA WI 53147

PLAT OF SURVEY

-OF-

LOTS 1 AND 2, EVANGELICAL FREE CHURCH SUBDIVISION IN THE VILLAGE OF WILLIAMS BAY, COUNTY OF WALWORTH, STATE OF WISCONSIN. EXCEPTING THEREFROM A STRIP OF LAND 12.00 FEET IN WIDTH ALONG THE NORTHEASTERLY SIDE OF LOT 2, ALL IN EVANGELICAL FREE CHURCH, SUBDIVISION, LOCATED IN THE VILLAGE OF WILLIAMS BAY, WALWORTH COUNTY, WISCONSIN.

KROTT SURVEYING INC.
N3705 WILLOW BEND LANE
LAKE GENEVA WI. 53147
PHONE # (262)248-3697
FAX # (262)249-0639

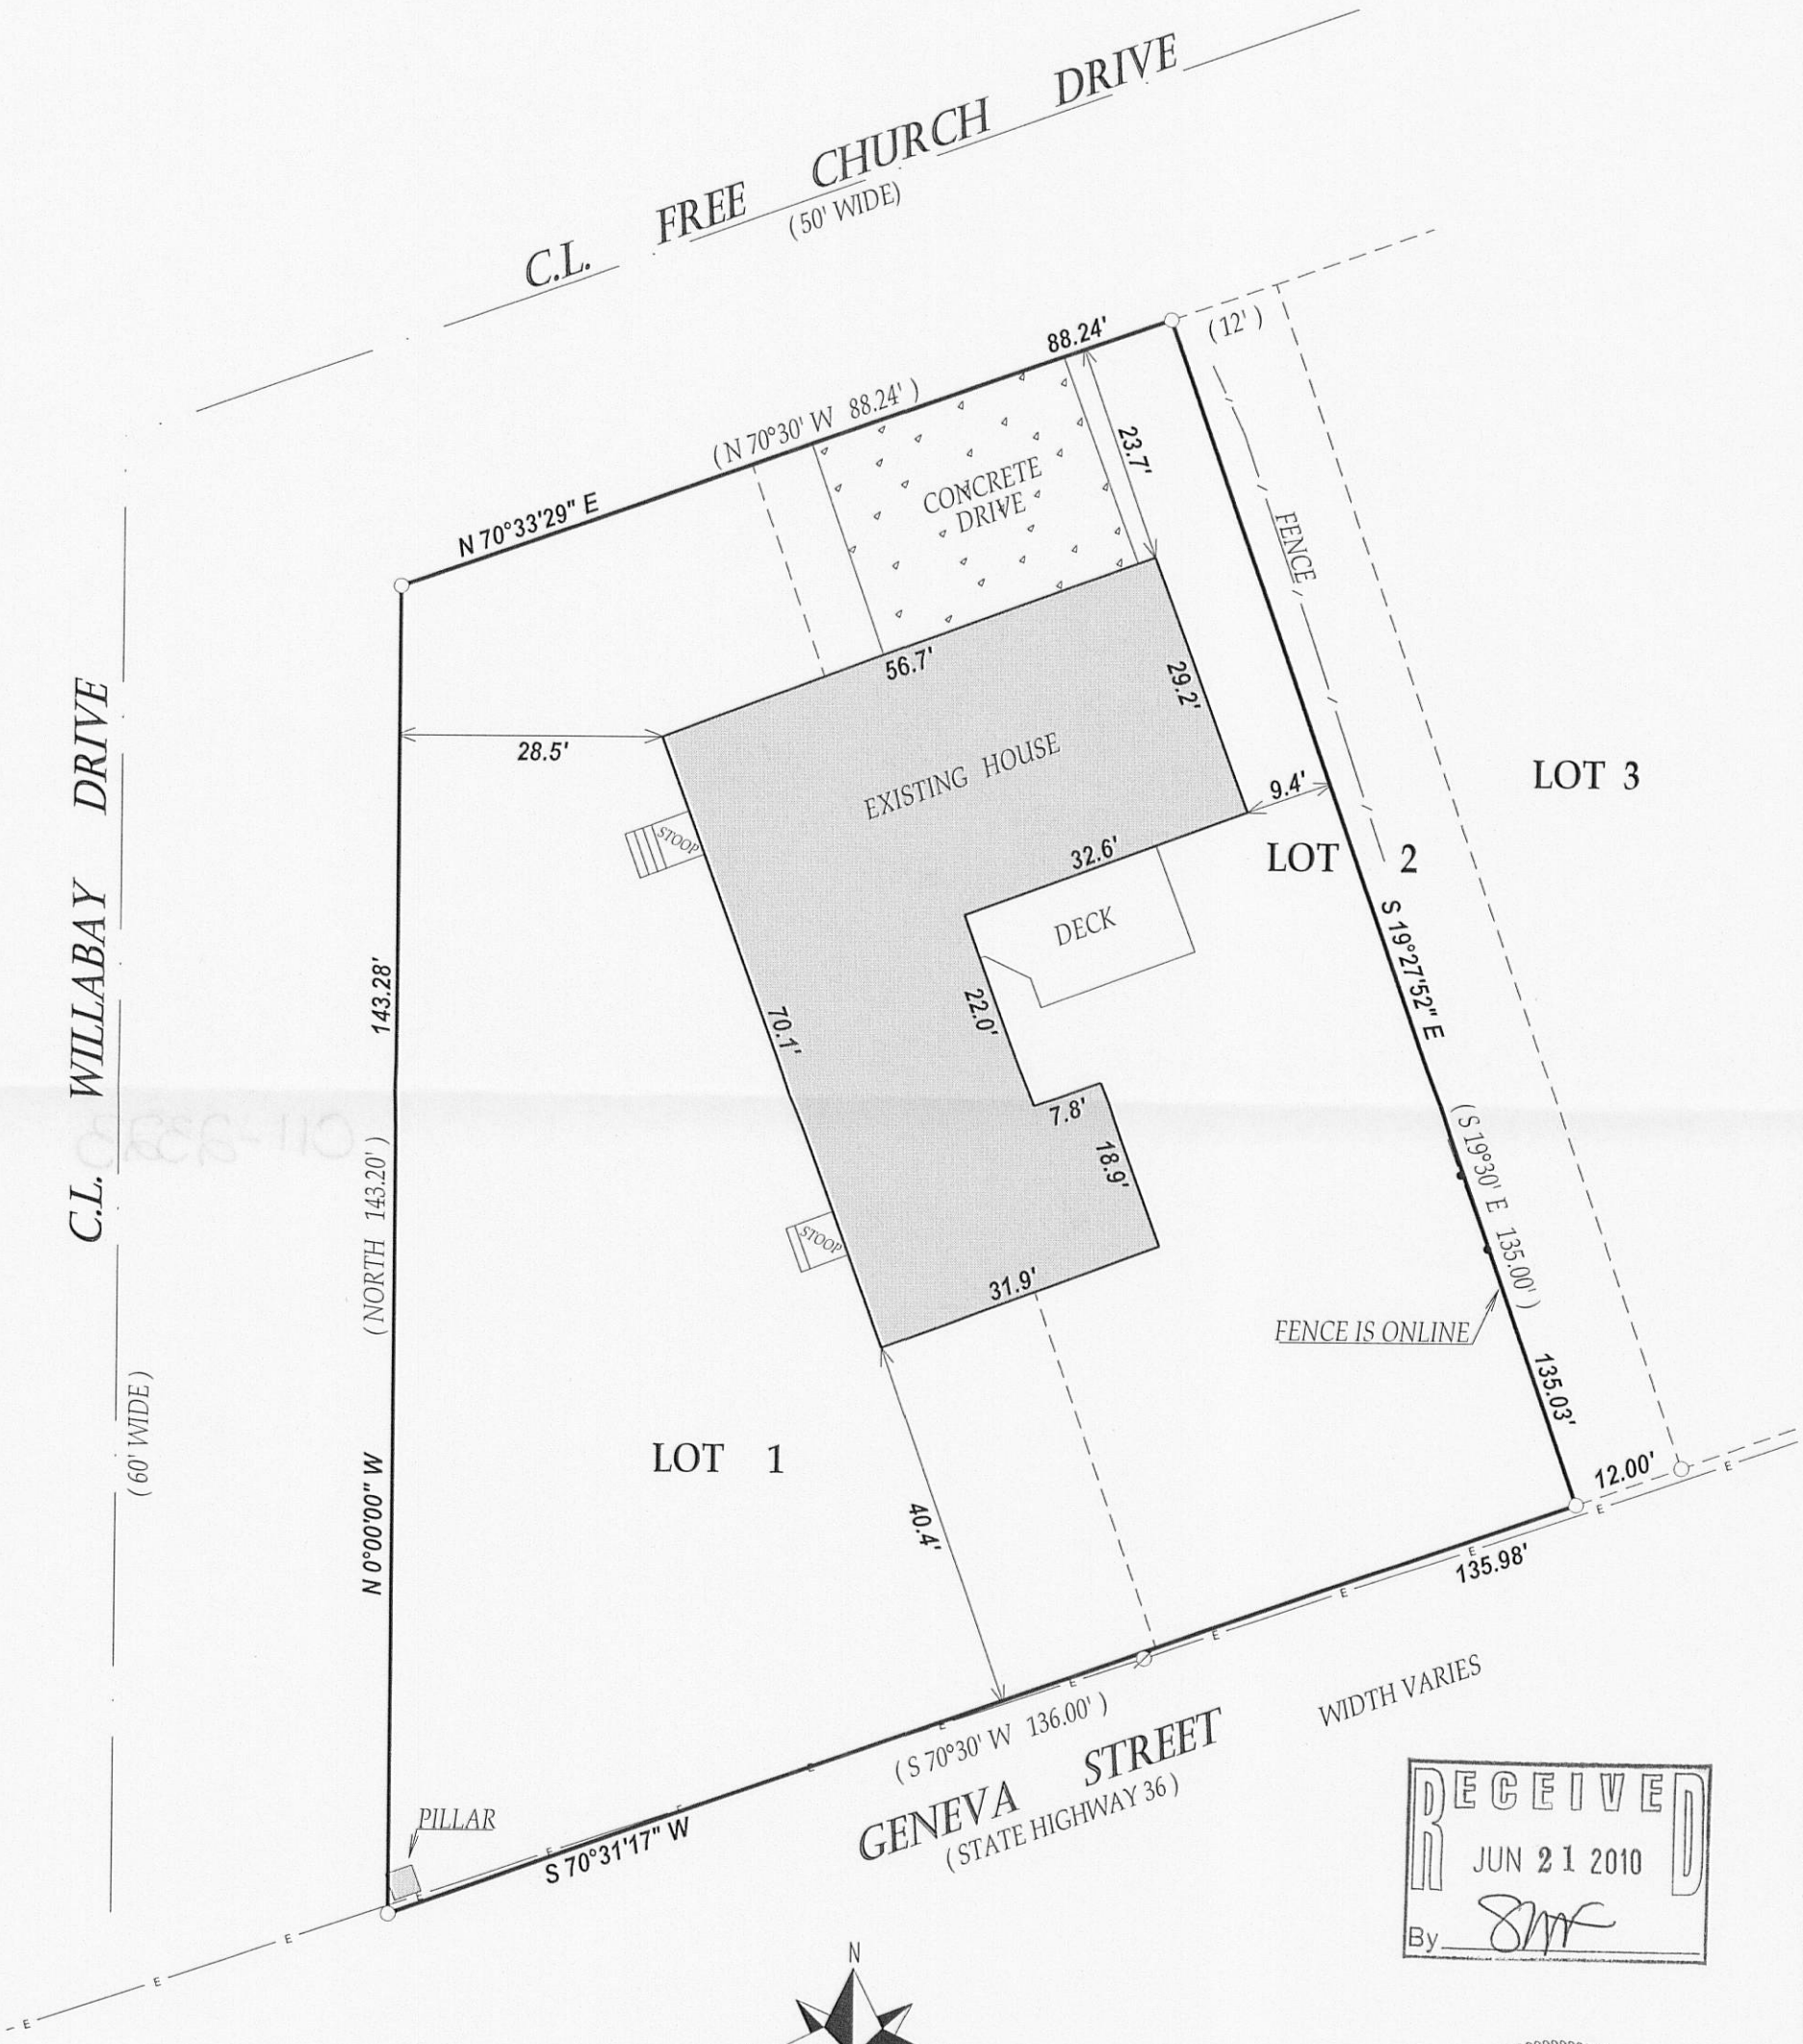

RECEIVED
JUN 21 2010
By

WISCONSIN
JOHN P.
KROTT
S-2258
LAKE GENEVA
WIS.
LAND SURVEYOR

LEGEND

- ○ FOUND IRON PIPE
- ∅ UTILITY POLE
- —E— OVERHEAD WIRES
- (XX) RECORDED AS

TAX ID # WEF00001 & WEF00002

JOB # 10-100

I have surveyed the above-described property and the above map is a true representation thereof and shows the size and location of the property, its exterior boundaries, the location and dimensions of all structures thereon, fences apparent easements and roadways and visible encroachments. if any.

This survey is made for the exclusive use of the present owners of the property, and also those who puchase, mortgage,or insure the title therto within one (1) year from date hereof; and as to them I warrant the accuracy of said survey map.

NOTE : BEARINGS ARE REFRENCED TO THE RECORD PLAT.

DATED THIS 18th DAY OF JUNE 2010.

JOHN KROTT S - 2258
Wisconsin Registered Land Surveyor
(original if signed in red)

OU-2323