
PLAT OF SURVEY

OF

THE SOUTH 1/2 OF LOT 10, OBSERVATORY SUBDIVISION, LOCATED IN THE SOUTHWEST 1/4 OF SECTION 1, T1N R16E. WILLIAMS BAY, WISCONSIN.

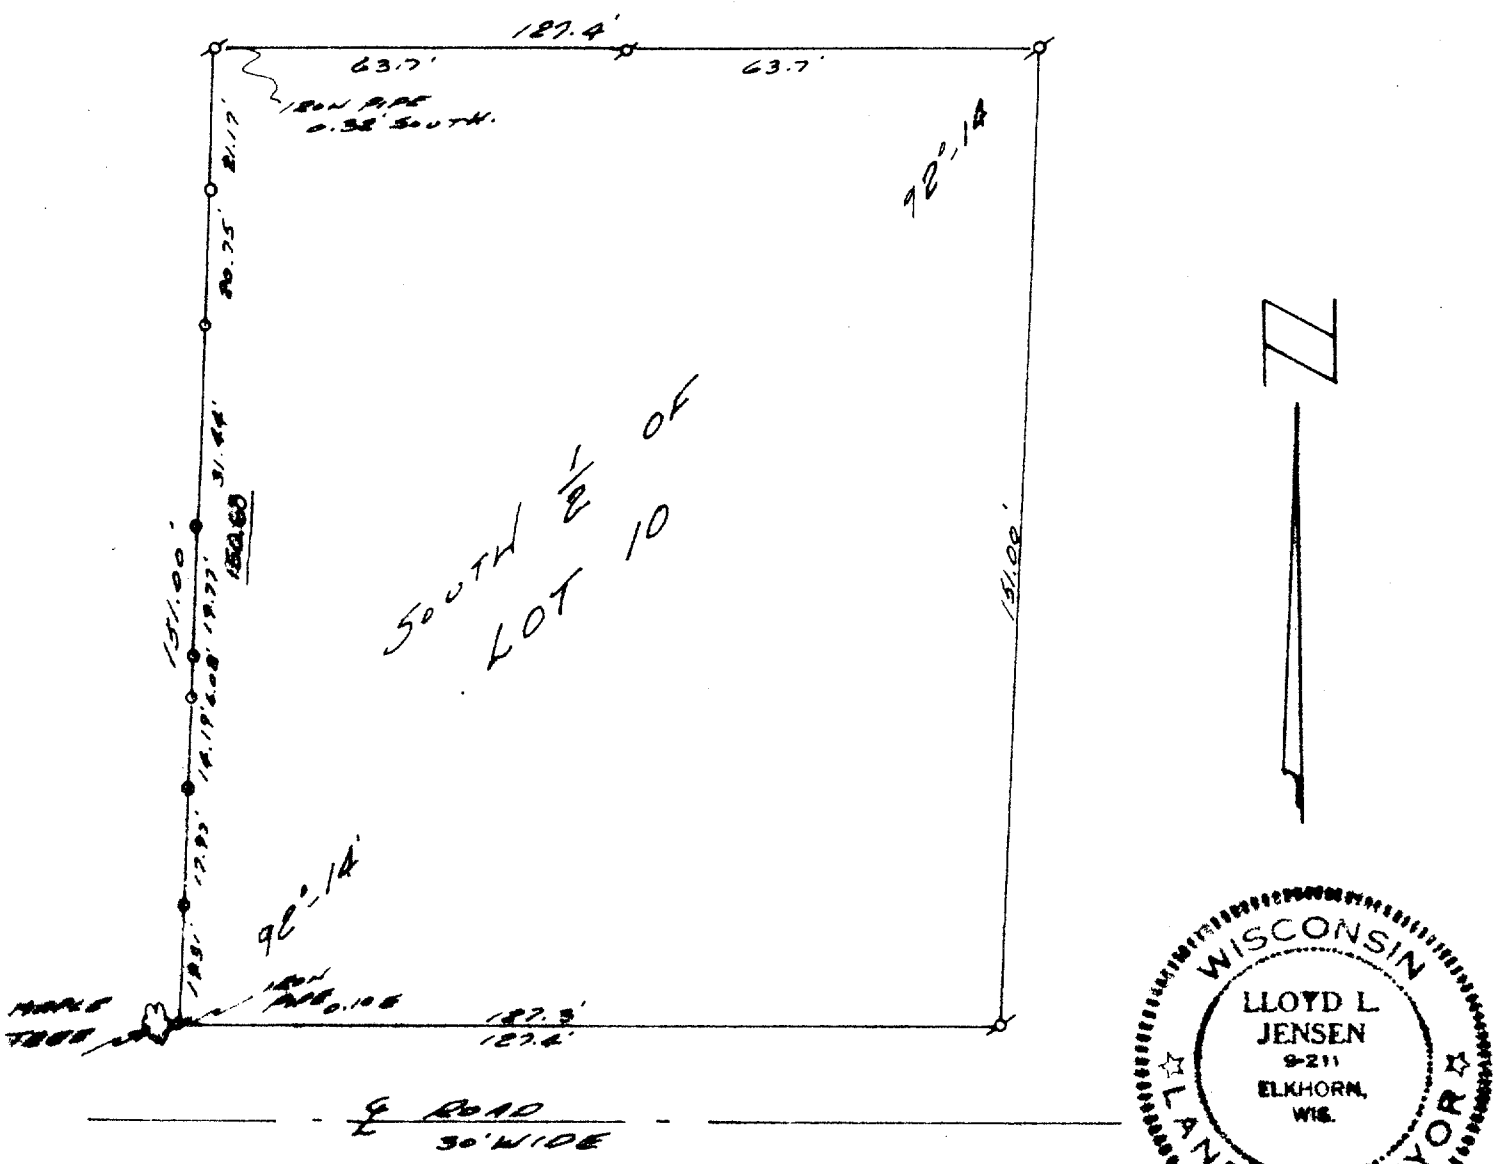

WISCONSIN
LLOYD L. JENSEN
S-211
ELKHORN, WIS.
LAND SURVEYOR

SURVEY AND PLAT BY

JENSEN & JOHNSON, INC.

CIVIL ENGINEERS AND SURVEYORS

Elkhorn, Wisconsin

LEGEND

O — Iron Pipe SET

● — Concrete Monument

Scale 1" = 30'

S — IRON PIPE FOUND

WE CERTIFY: That we have surveyed the above described property and that the plat shown hereon is an accurate survey and a true representation thereof and correctly shows the exterior boundary lines and all divisions of said property.

Date OCT. 1970

Lloyd L. Jensen

LLOYD L. JENSEN,

Wisconsin Registered Land Surveyor, No. S-211

WOB-22

11-236J