
PLAT OF SURVEY
OF

LOT 16 BLOCK NO. 3 OF HARBOR VIEW SUBDIVISION, SECTION 6 T1N R17E, WILLIAMS BAY, WISCONSIN.

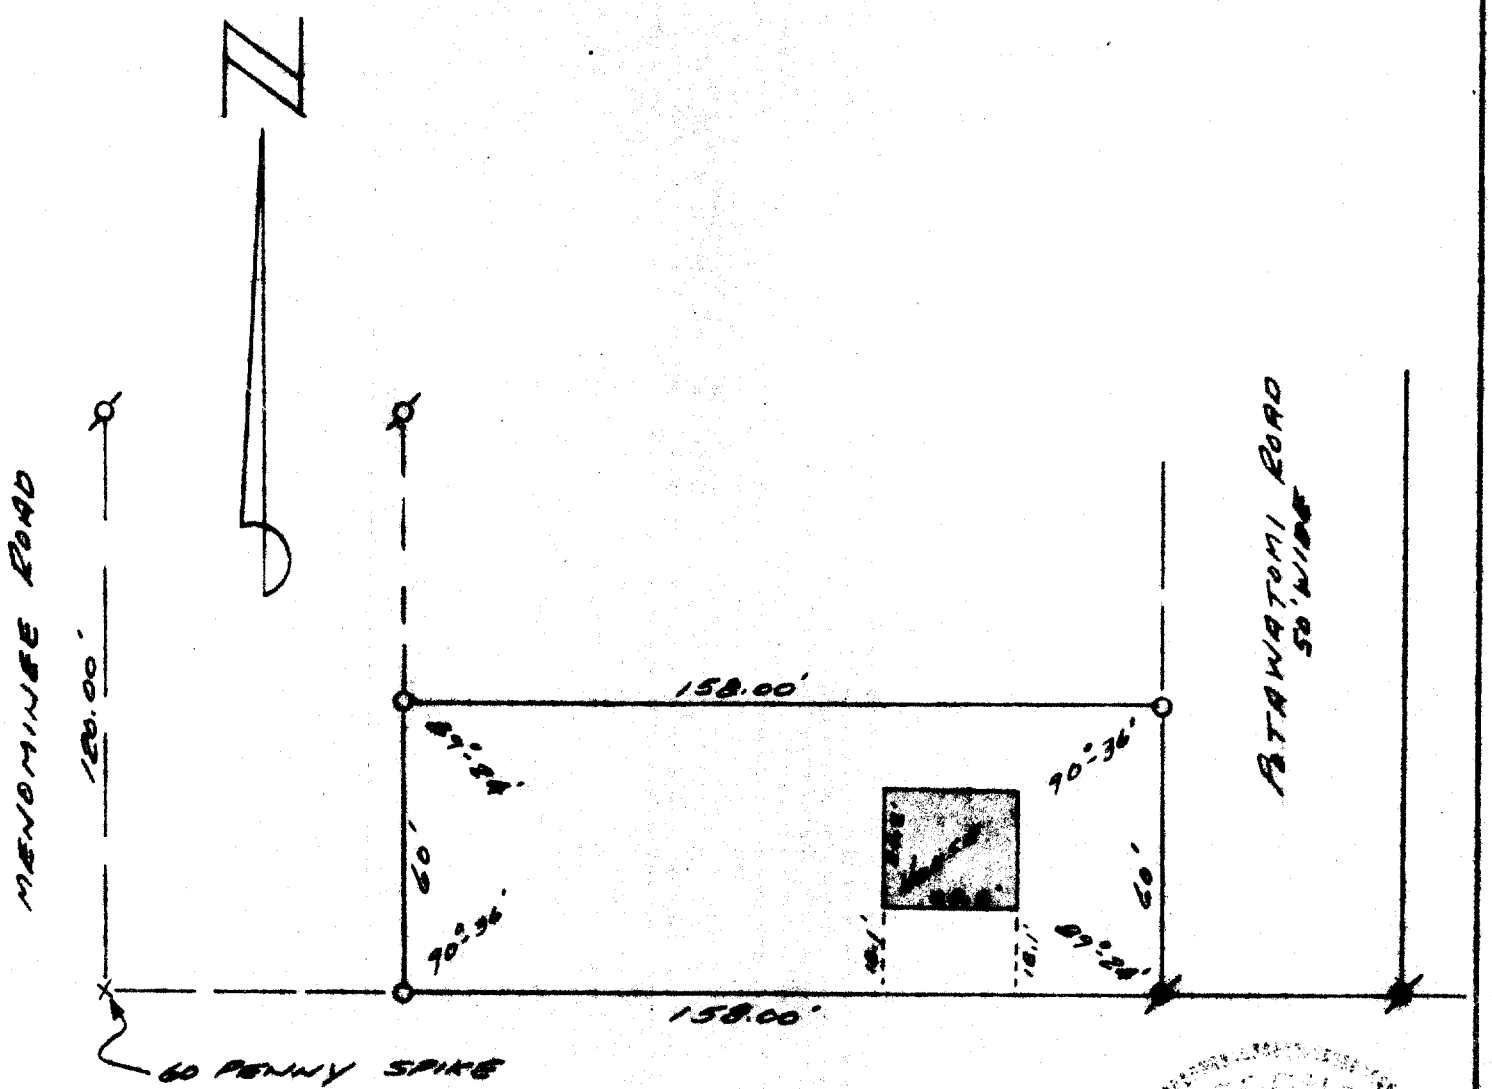

SURVEY AND PLAT BY

JENSEN & JOHNSON, INC.

CIVIL ENGINEERS AND SURVEYORS

Elkhorn, Wisconsin

LEGEND

o—Iron Pipe *set*

⌀—Concrete Monument *Found*

Scale 1" = 40'

⌀ *Other Survey Monument*

WE CERTIFY: That we have surveyed the above described property and that the plat shown hereon is a correct survey and a true representation thereof and correctly shows the exterior boundary lines and all divisions of said property.

Date *March 4, 1970*

Floyd L. Jensen

FLOYD L. JENSEN,

Wisconsin Registered Land Surveyor, No. S-321

WHW45

11-237