


Plat of Survey

of
Lot 1 of Certified Survey Map No. 4251,

recorded in Vol. 27 of Certified Survey Maps of Walworth County on Page 130 and located in Government Lot 1 and the Northeast 1/4 of the fractional Southeast 1/4 of Section 1, Town 1 North, Range 16 East, and Government Lot 4 of Section 6, Town 1 North, Range 17 East, Village of Williams Bay, Walworth County, Wisconsin.

Surveyed for: **Brookhaven Properties, Inc.**
1925 East Ridgewood Lane
Glenview, Illinois 60023

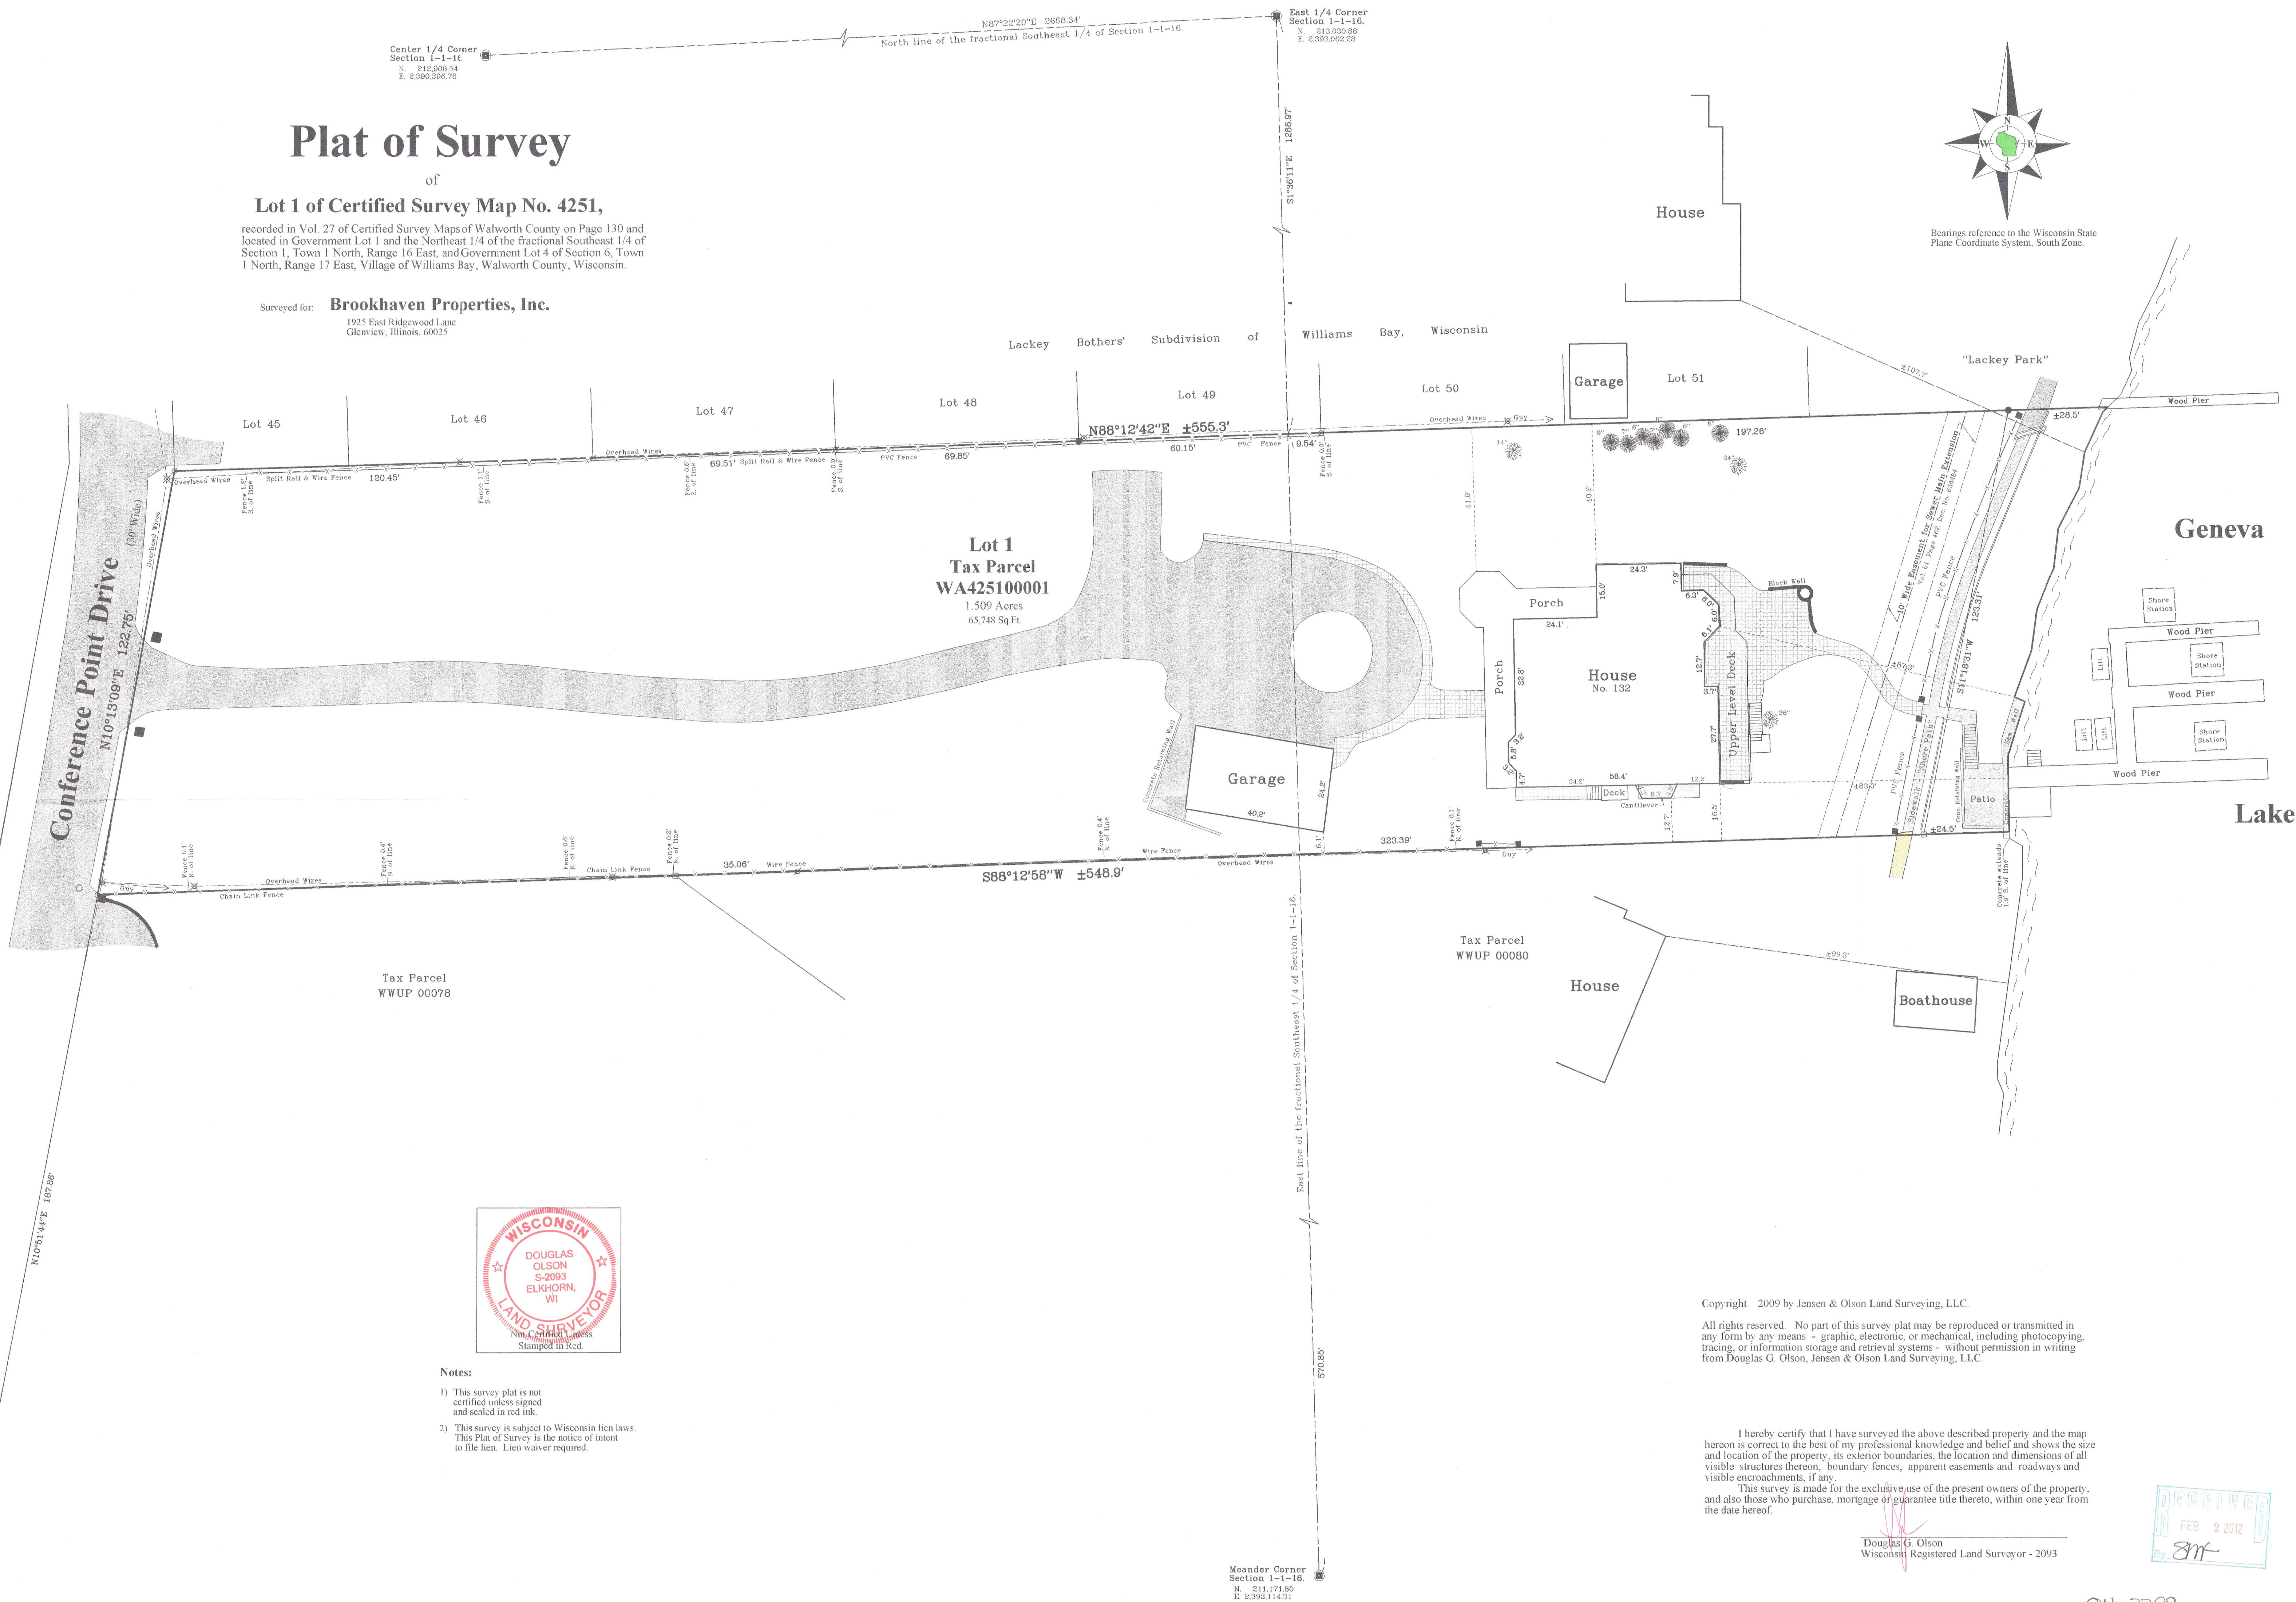

Jensen & Olson Land Surveying, LLC

45 South Wisconsin Street * P.O. Box 322 * Elkhorn, Wisconsin. 53121
Telephone: (262) 723-3434 * Facsimile: (262) 723-8044
Email: jensen.olson@elknet.net

Legend

- Found County Section Corner
- Found Concrete Monument
- Found Iron Pipe
- Found Iron Rod

Sheet 1 of 1 Sheets

Job Reference Number
2011.130

2011.130