
Plat of Survey

of

Lot 1 of Certified Survey Map No. 4251,

recorded in Vol. 27 of Certified Survey Maps of Walworth County on Page 130 and located in Government Lot 1 and the Northeast 1/4 of the fractional Southeast 1/4 of Section 1, Town 1 North, Range 16 East, and Government Lot 4 of Section 6, Town 1 North, Range 17 East, Village of Williams Bay, Walworth County, Wisconsin.

Surveyed for: **Brookhaven Properties, Inc.**
1925 East Ridgewood Lane
Glenview, Illinois. 60025

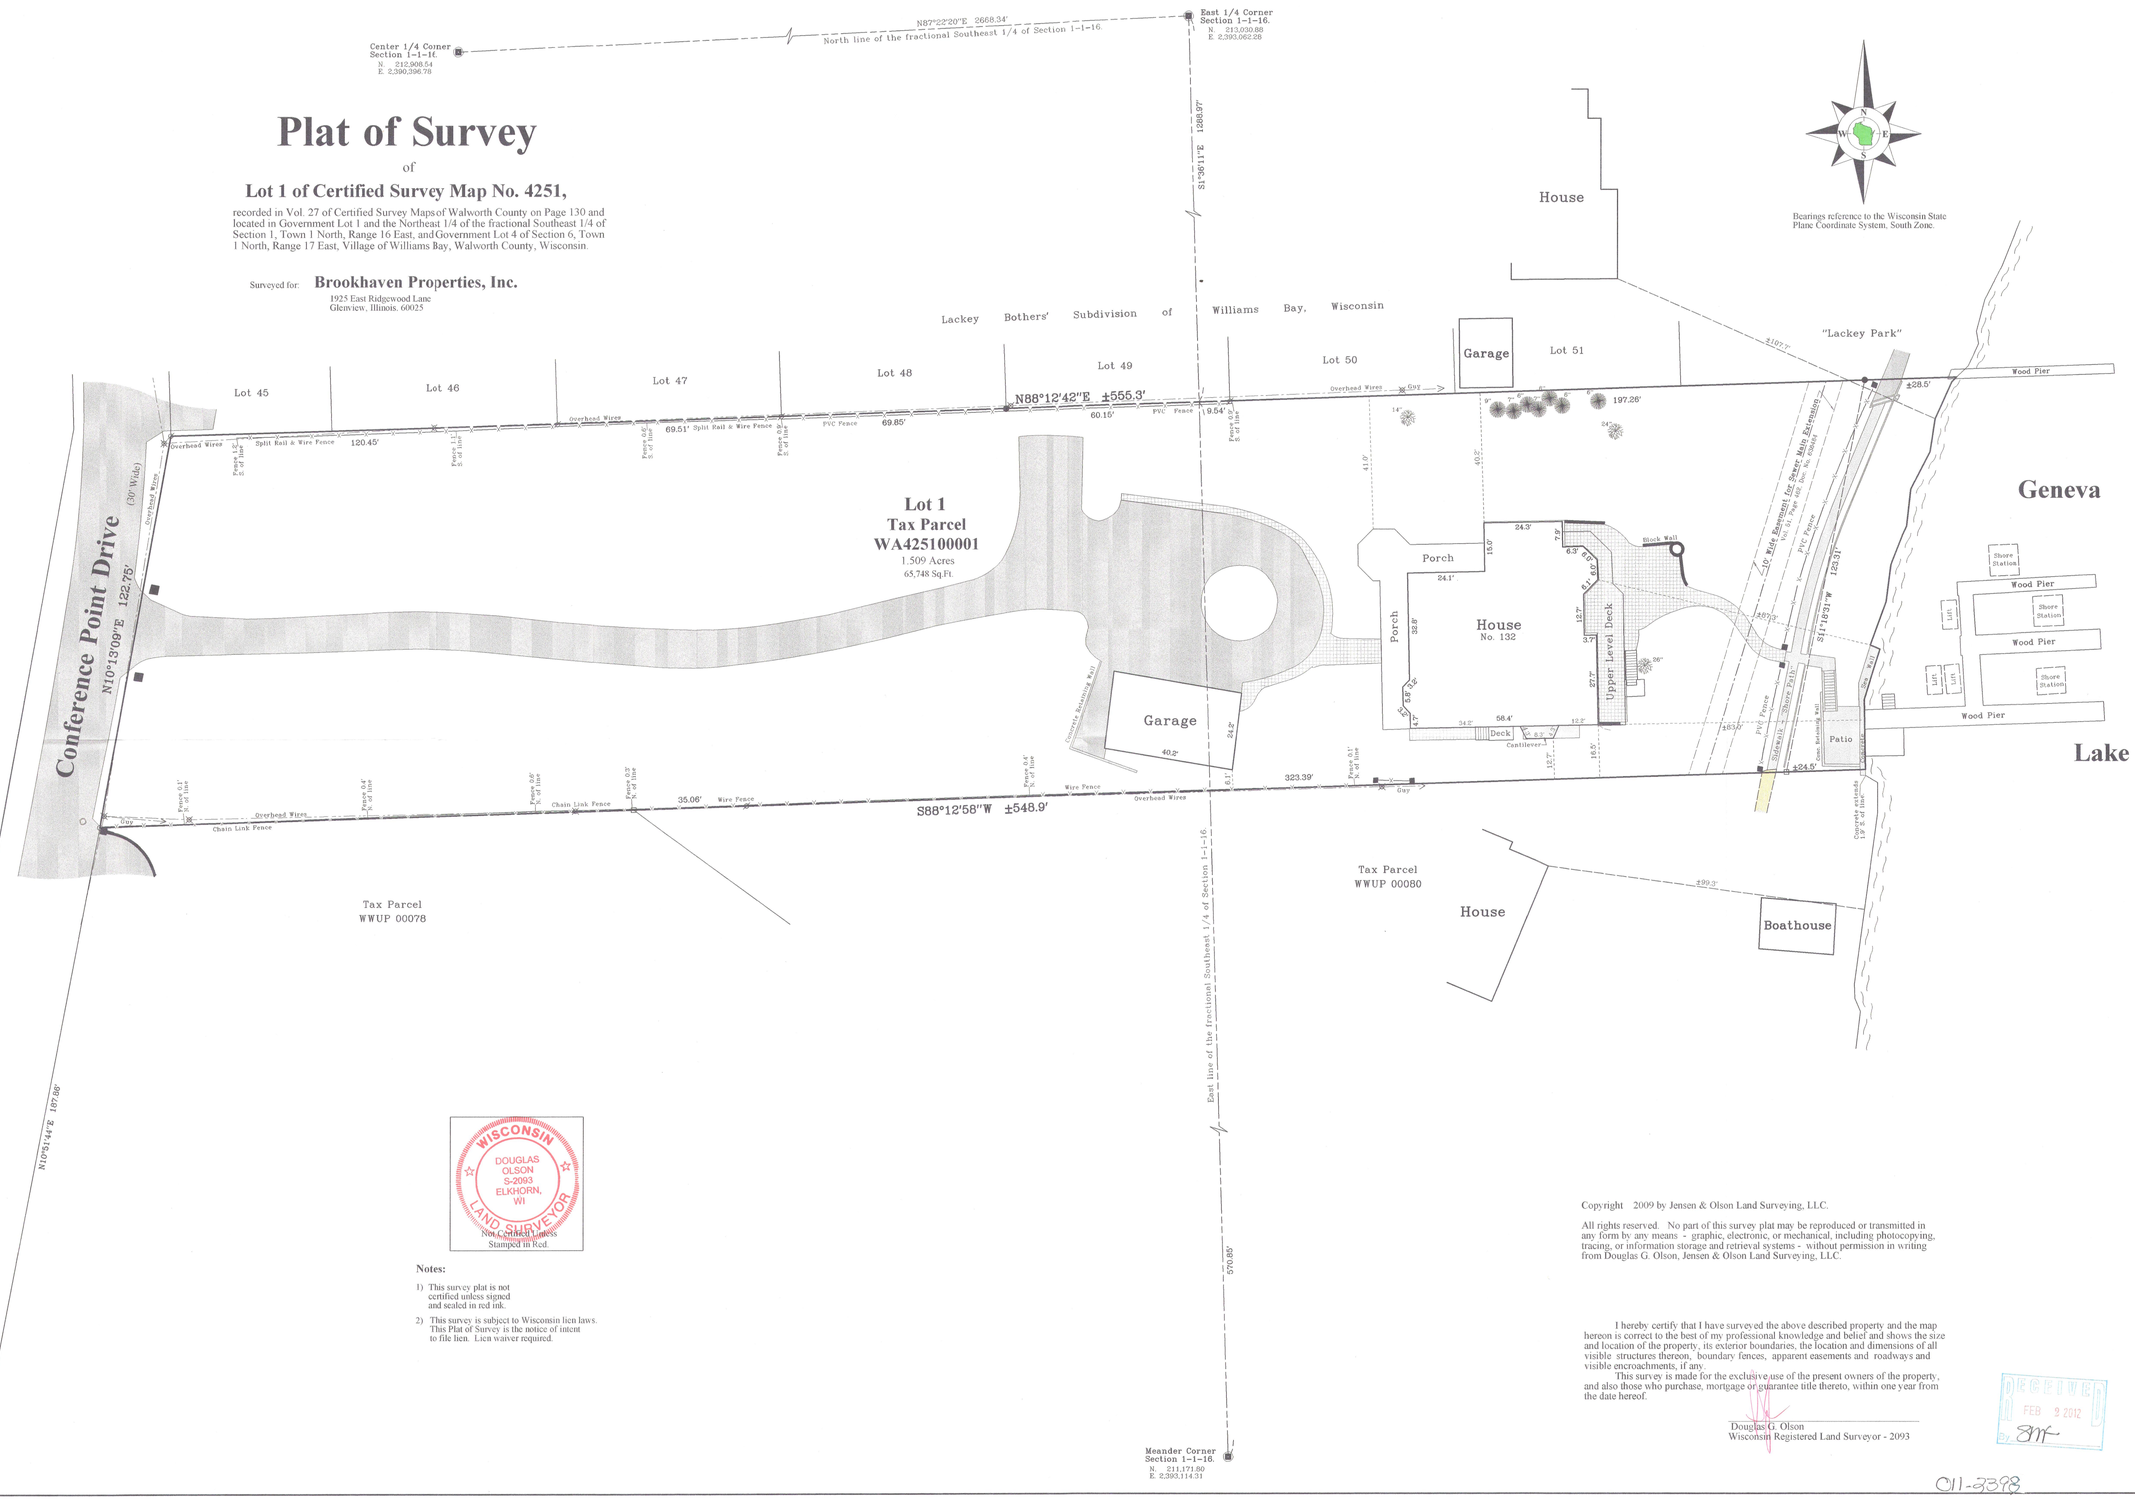

WISCONSIN
DOUGLAS OLSON
S-2093
ELKHORN, WI
LAND SURVEYOR
Not Certified Unless Stamped in Red.

Notes:

1) This survey plat is not certified unless signed and sealed in red ink.
2) This survey is subject to Wisconsin lien laws. This Plat of Survey is the notice of intent to file lien. Lien waiver required.

Copyright 2009 by Jensen & Olson Land Surveying, LLC.

All rights reserved. No part of this survey plat may be reproduced or transmitted in any form by any means - graphic, electronic, or mechanical, including photocopying, tracing, or information storage and retrieval systems - without permission in writing from Douglas G. Olson, Jensen & Olson Land Surveying, LLC.

I hereby certify that I have surveyed the above described property and the map hereon is correct to the best of my professional knowledge and belief and shows the size and location of the property, its exterior boundaries, the location and dimensions of all visible structures thereon, boundary fences, apparent easements and roadways and visible encroachments, if any.

This survey is made for the exclusive use of the present owners of the property, and also those who purchase, mortgage or guarantee title thereto, within one year from the date hereof.

Douglas G. Olson
Wisconsin Registered Land Surveyor - 2093

RECEIVED
FEB 2 2012
By: BM

Survey date: June 1, 2009.
Revisions: No. 1 – Adjacent houses
No. 2 – Bldg. Dim.
No. 3 – Proposed Addition
No. 4 – As-built

Scale in Feet
1" = 20'
0' 10' 20' 40' 60'

Jensen & Olson Land Surveying, LLC
45 South Wisconsin Street * P.O. Box 322 * Elkhorn, Wisconsin. 53121
Telephone: (262) 723-3434 * Facsimile: (262) 723-8044
Email: jensen.olson@elknet.net

Legend
- Found County Section Corner
- Found Concrete Monument
- Found Iron Pipe
- Found Iron Rod
- Found P.K. Nail
- Found Railroad Spike
- Utility Pole
- Guy Wire
- Deciduous Tree
- Coniferous Tree
- Stone or Brick Pillar
- Retaining Wall
- Brick Pavers
- Asphalt Surface
- Concrete Surface
- Gravel Surface
- ◇ Water Valve
- ⊙ Sanitary Manhole
- ⊙ Storm Manhole
- ⊙ Hydrant
- ⊙ Light Pole
- ⊙ Mail Box
- ⊙ Sign

Sheet 1 of 1 Sheets
Drawing Name: (for doc 2011130-2011130 Plat 4s)
Job Reference Number
2011.130

2011.130

WA425(-)

C11-3398