
226-65

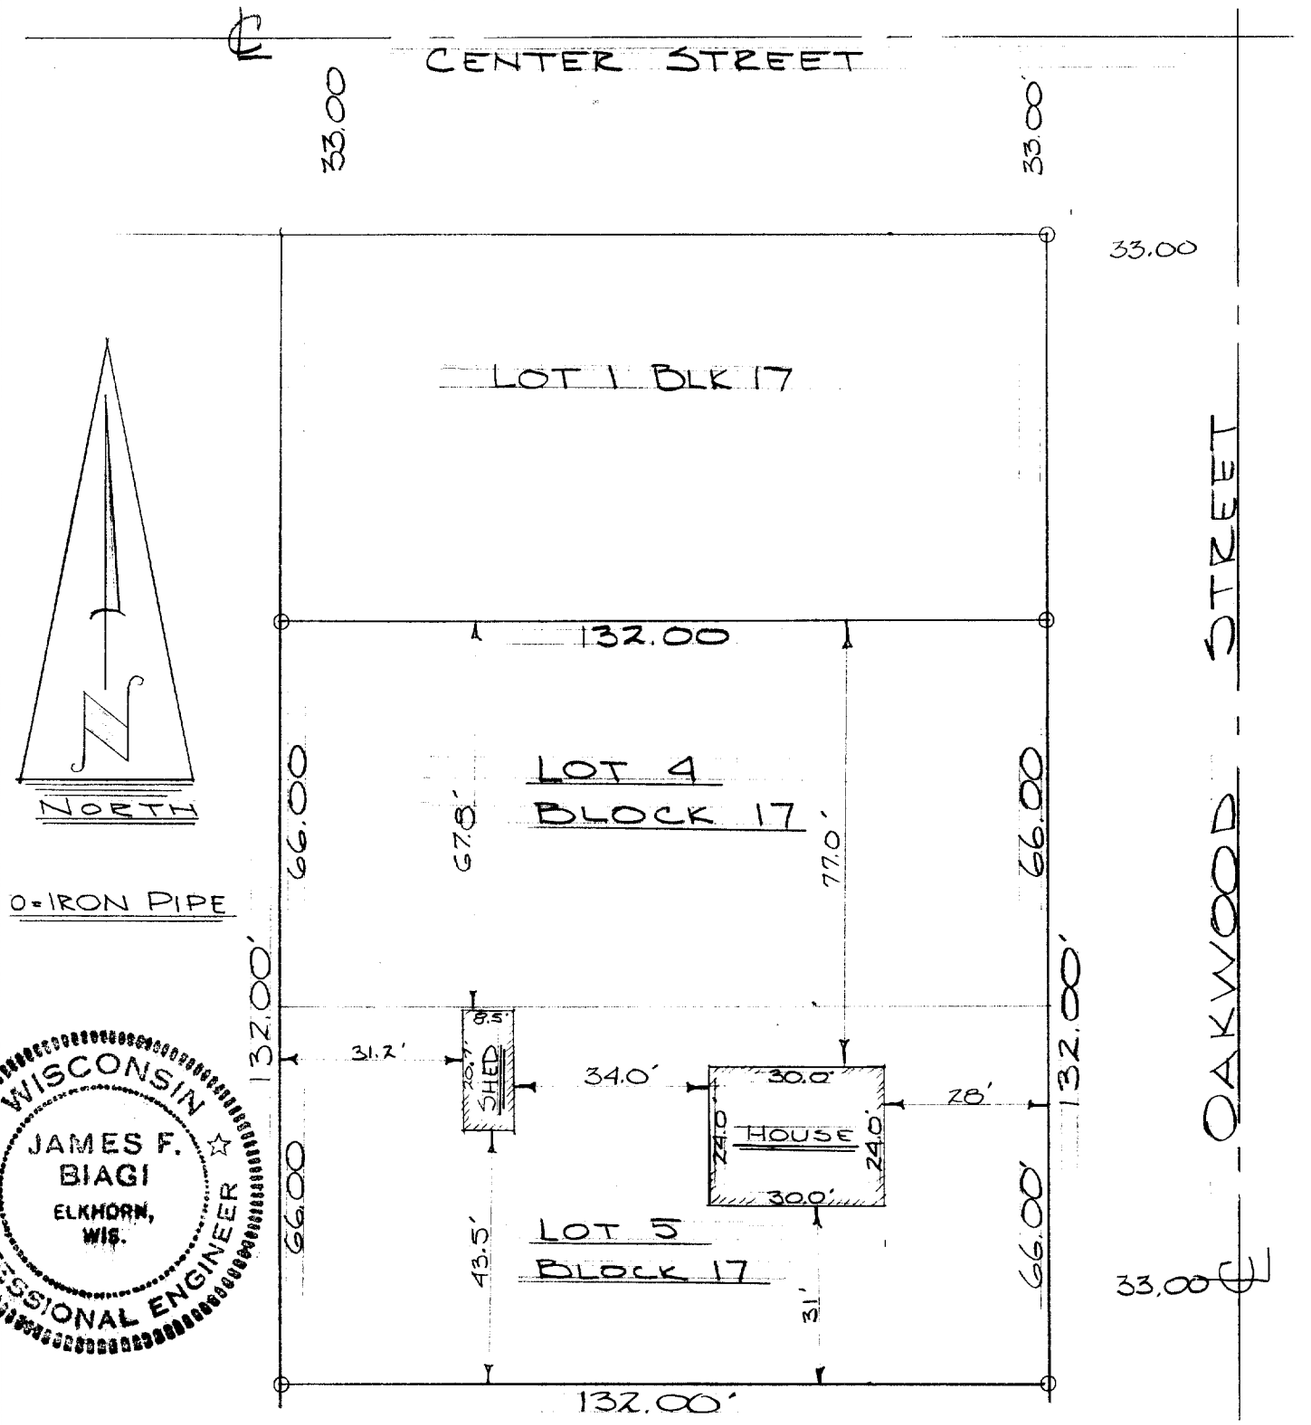

WISCONSIN
JAMES F. BIAGI
ELKHORN, WIS.
PROFESSIONAL ENGINEER

DESCRIPTION: Lots 4 and 5 of Block 17 of Williams Second Addition to the Village of Williams Bay, Walworth County, Wisconsin.

CERTIFICATE: I, James F. Biagi, surveyor, do hereby certify that I have surveyed the property hereon described and that the location of the improvements are as shown above.

James F. Biagi

James F. Biagi RLS 272

WISCONSIN
JAMES F. BIAGI
MILWAUKEE, WIS.
LAND SURVEYOR

11-23B