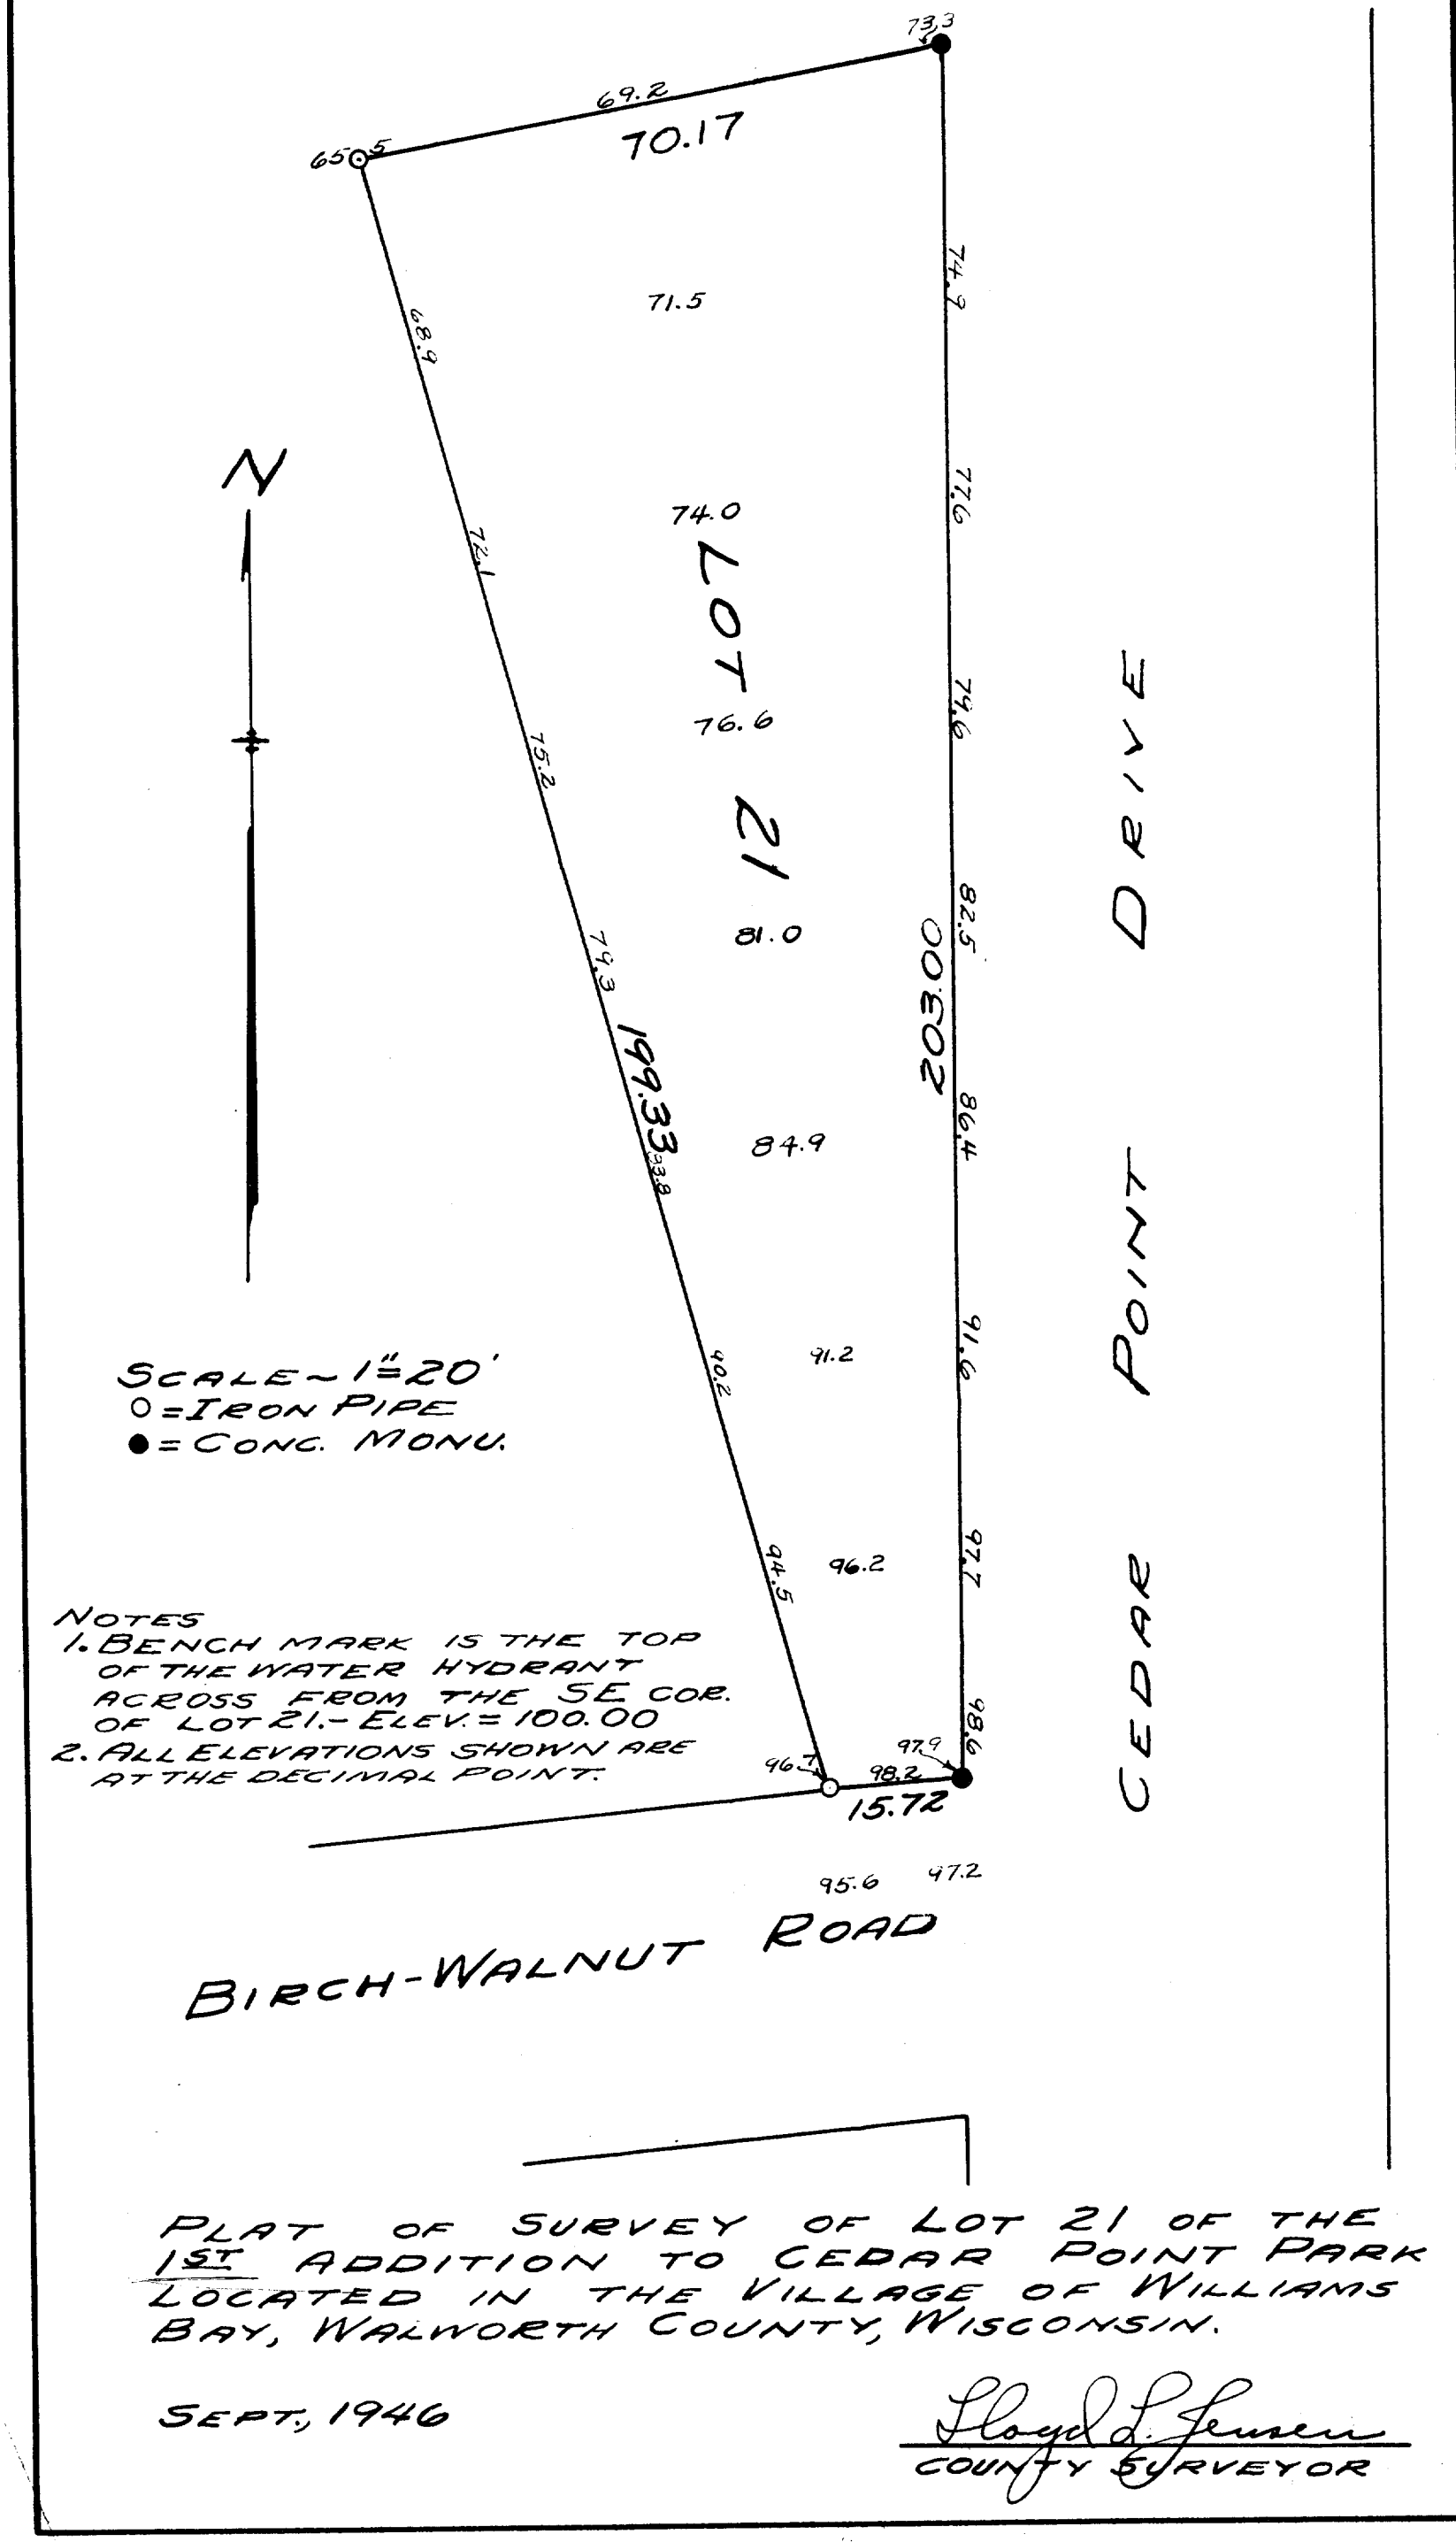


PLAT OF SURVEY OF LOT 21 OF THE 1ST ADDITION TO CEDAR POINT PARK LOCATED IN THE VILLAGE OF WILLIAMS BAY, WALWORTH COUNTY, WISCONSIN.

SEPT., 1946

Floyd L. Jensen
COUNTY SURVEYOR

WCP1-22

11-24-J