
LAND-MARK SURVEYING
Mark L. Miritz
Wisconsin Registered Land Surveyor S-2582

N9330 Knuteson Drive
Whitewater, WI 53190
Phone:(262)495-3284
MARKMIRITZ@
LAND-MARKSURVEYING.COM

PLAT OF SURVEY

THE WEST HALF (W 1/2) AND THE WEST HALF (W 1/2) OF THE EAST HALF (E 1/2) OF LOT EIGHT (8) IN GRAND TERRACE SUBDIVISION, BEING A SUBDIVISION OF PART OF SECTION ONE (1) AND TWELVE (12) IN TOWNSHIP ONE (1) NORTH, RANGE SIXTEEN (16) EAST, VILLAGE OF WILLIAMS BAY, WALWORTH COUNTY, WISCONSIN.

OWNER: THOMAS NEWMAN ET. AL.
P.O. BOX 564
WHEATON, IL 60189-0564

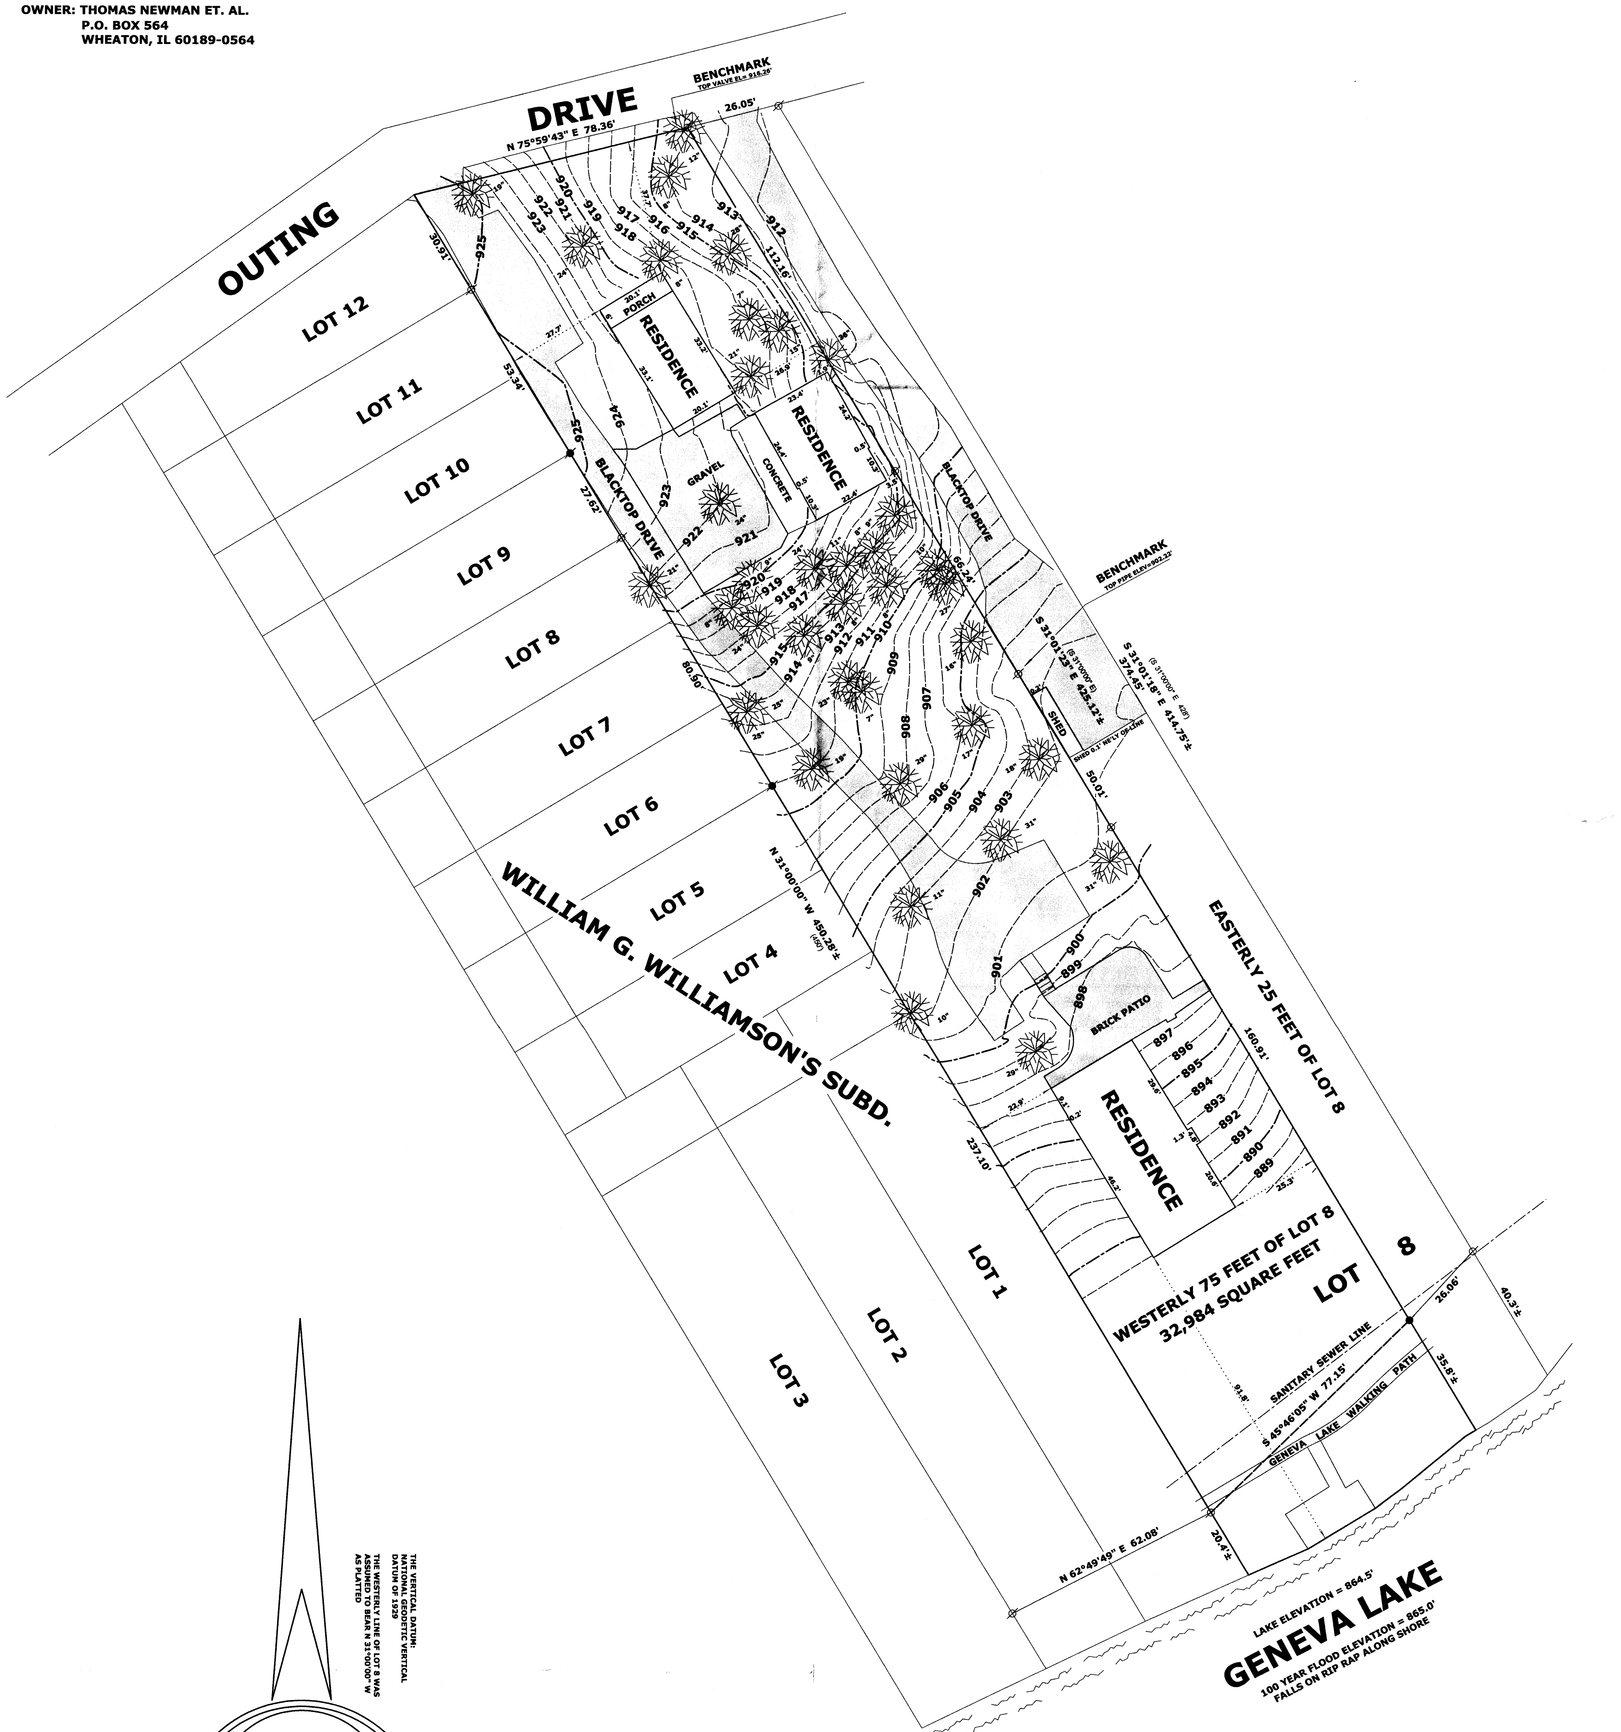

THE VERTICAL DATUM: NATIONAL GEODETIC VERTICAL DATUM OF 1929

THE WESTERLY LINE OF LOT 8 WAS ASSUMED TO BEAR N 31°00'00" W AS PLATTED

LEGEND

- TREE WITH DIAMETER MEASURED IN INCHES 2' ABOVE GROUND
- ⌀ FOUND IRON PIPE
- ● FOUND IRON ROD
- (x x) RECORDED AS DIMENSION

SCALE: 1 INCH = 20 FEET

"I hereby certify that the above described property has been surveyed by me or under my direction and that the above map is a true representation thereof and shows the size and location of the property, its exterior boundaries, the location of all visible structures and dimensions of all principal buildings thereon, boundary fences, apparent easements, roadways and visible encroachments, if any."
"This survey is made for the use of the present owners of the property, and also those who purchase, mortgage, or guarantee the title thereto within one year from date hereof."

WISCONSIN MARK L. MIRITZ S-2582 WHITEWATER WI LAND SURVEYOR

Mark L. Miritz
MARK L. MIRITZ
WISCONSIN REGISTERED
LAND SURVEYOR S-2582

DATE: JULY 27, 2013 JOB NO. 13.704

Oct 1 2013

WGT-6

WGT — 6 011 — 2506